**PARENT PARCEL:** 07-00-035-101-056
**CHILD PARCEL:** XX-XX-XXX-XXX-XXX
**STARTING POINT:** INTERSECTION OF C/L OF RACE RD. AND C/L OF SUGAR RIDGE RD.

**16-03437-X**

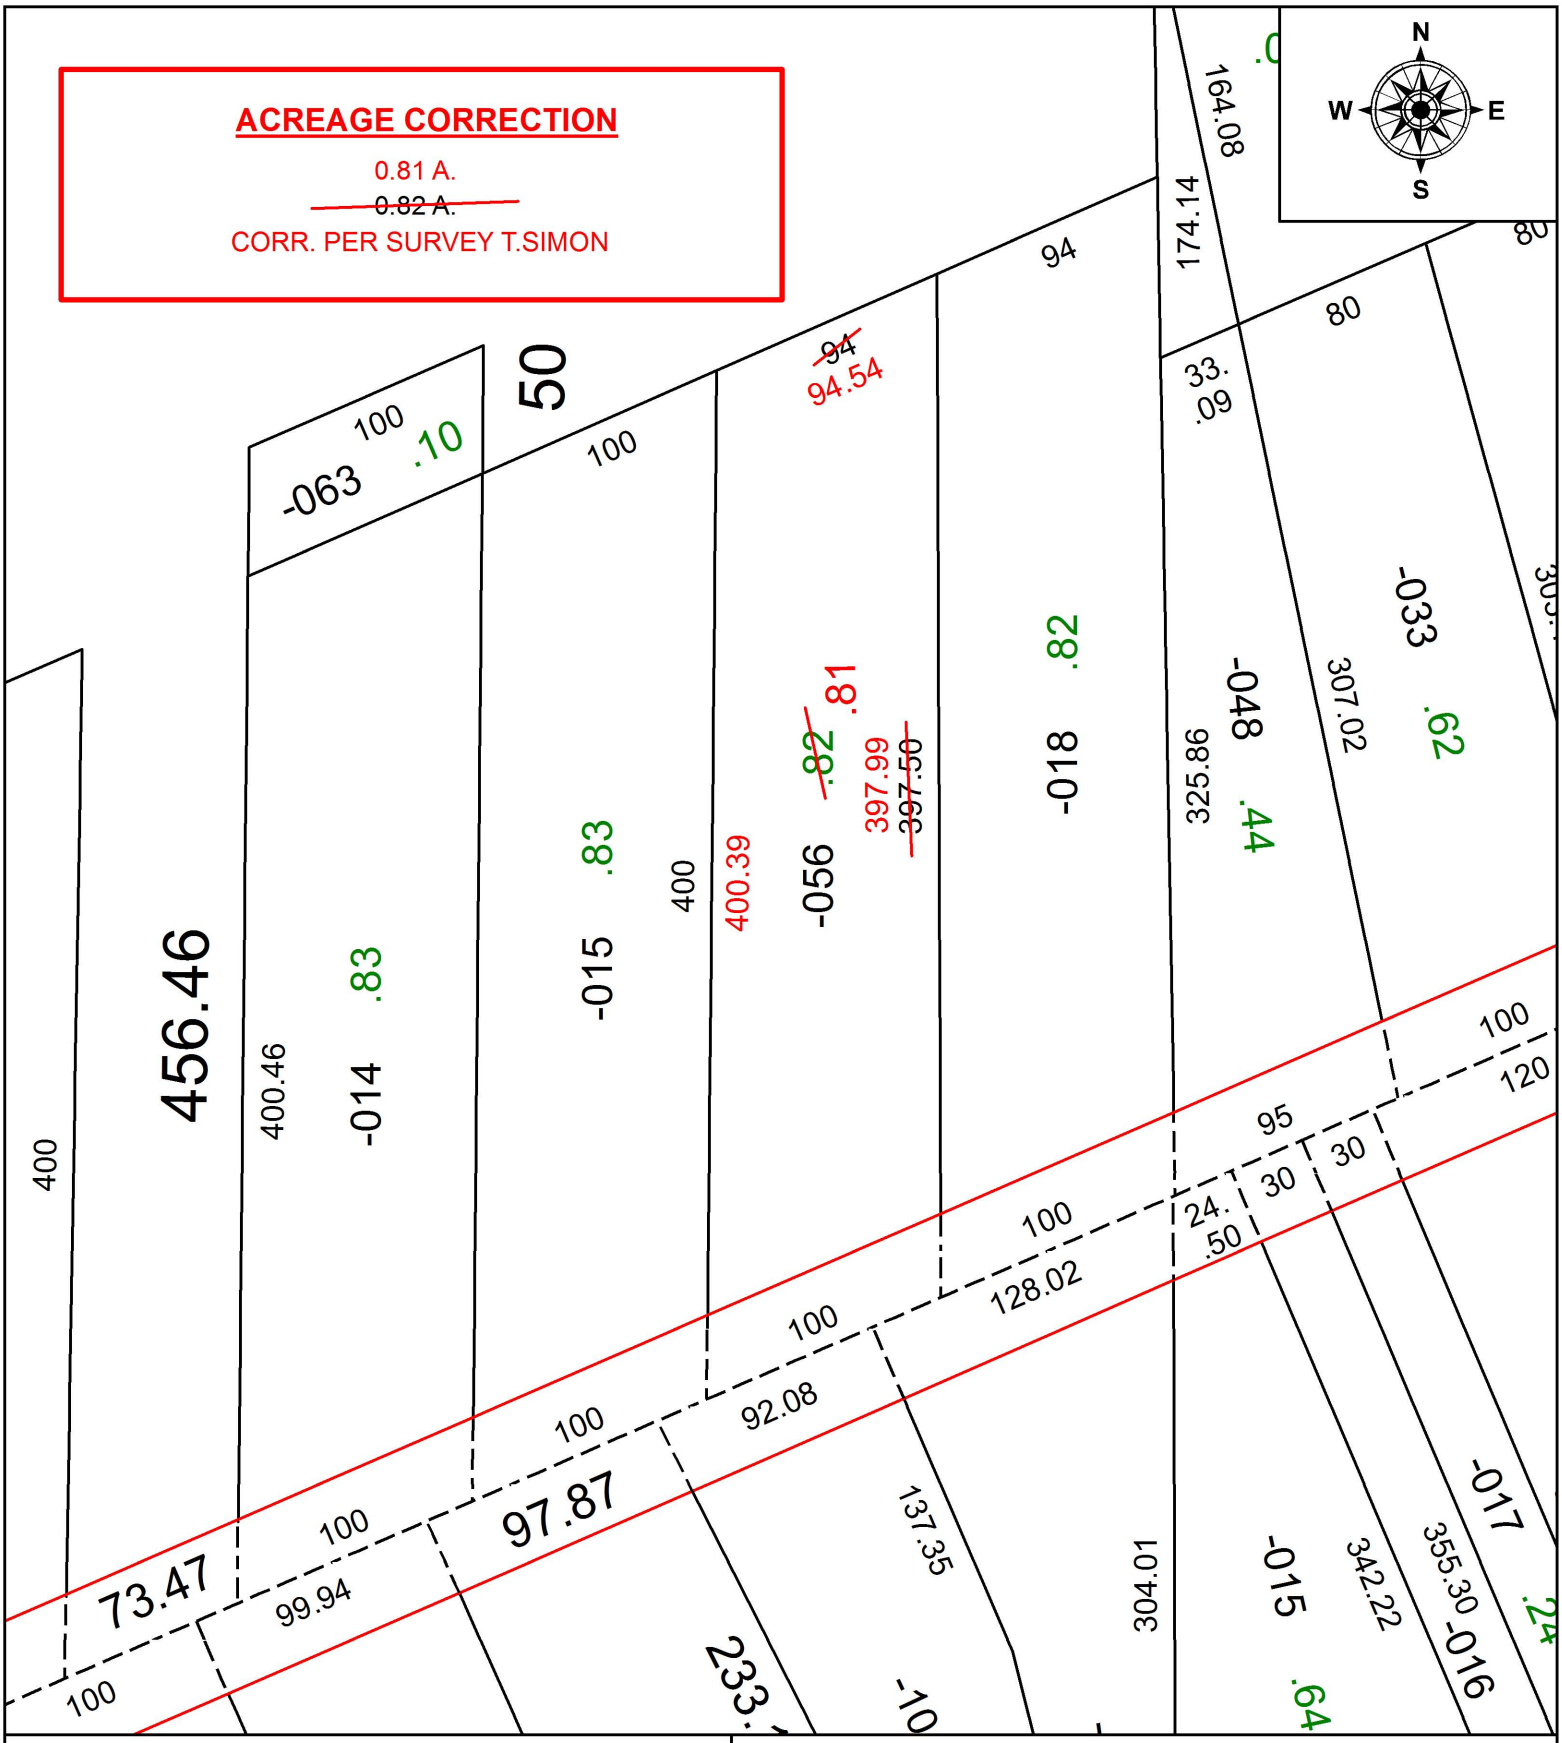


**SPLITS/DEEDS PROCESSED**
LORAIN COUNTY TAX MAP DEPARTMENT
226 MIDDLE AVE. ELYRIA, OH

**SURVEYED BY:** THOMAS A. SIMON
**CLOSURE:** 1: 226,579
**MAP PAGE(S):** 7-00-035
**APPOVED BY:** RRM **DATE:** 4-27-16
**SCALE:** 1" = 75 **PRIOR INSTRUMENT:** 20010768768