PARENT PARCEL: 04-00-003-101-498

CHILD PARCEL: 04-00-003-101-541 THRU 545

STARTING POINT: CENTERLINE OF RENWOOD AVE & CHELSEA ST

15-03449

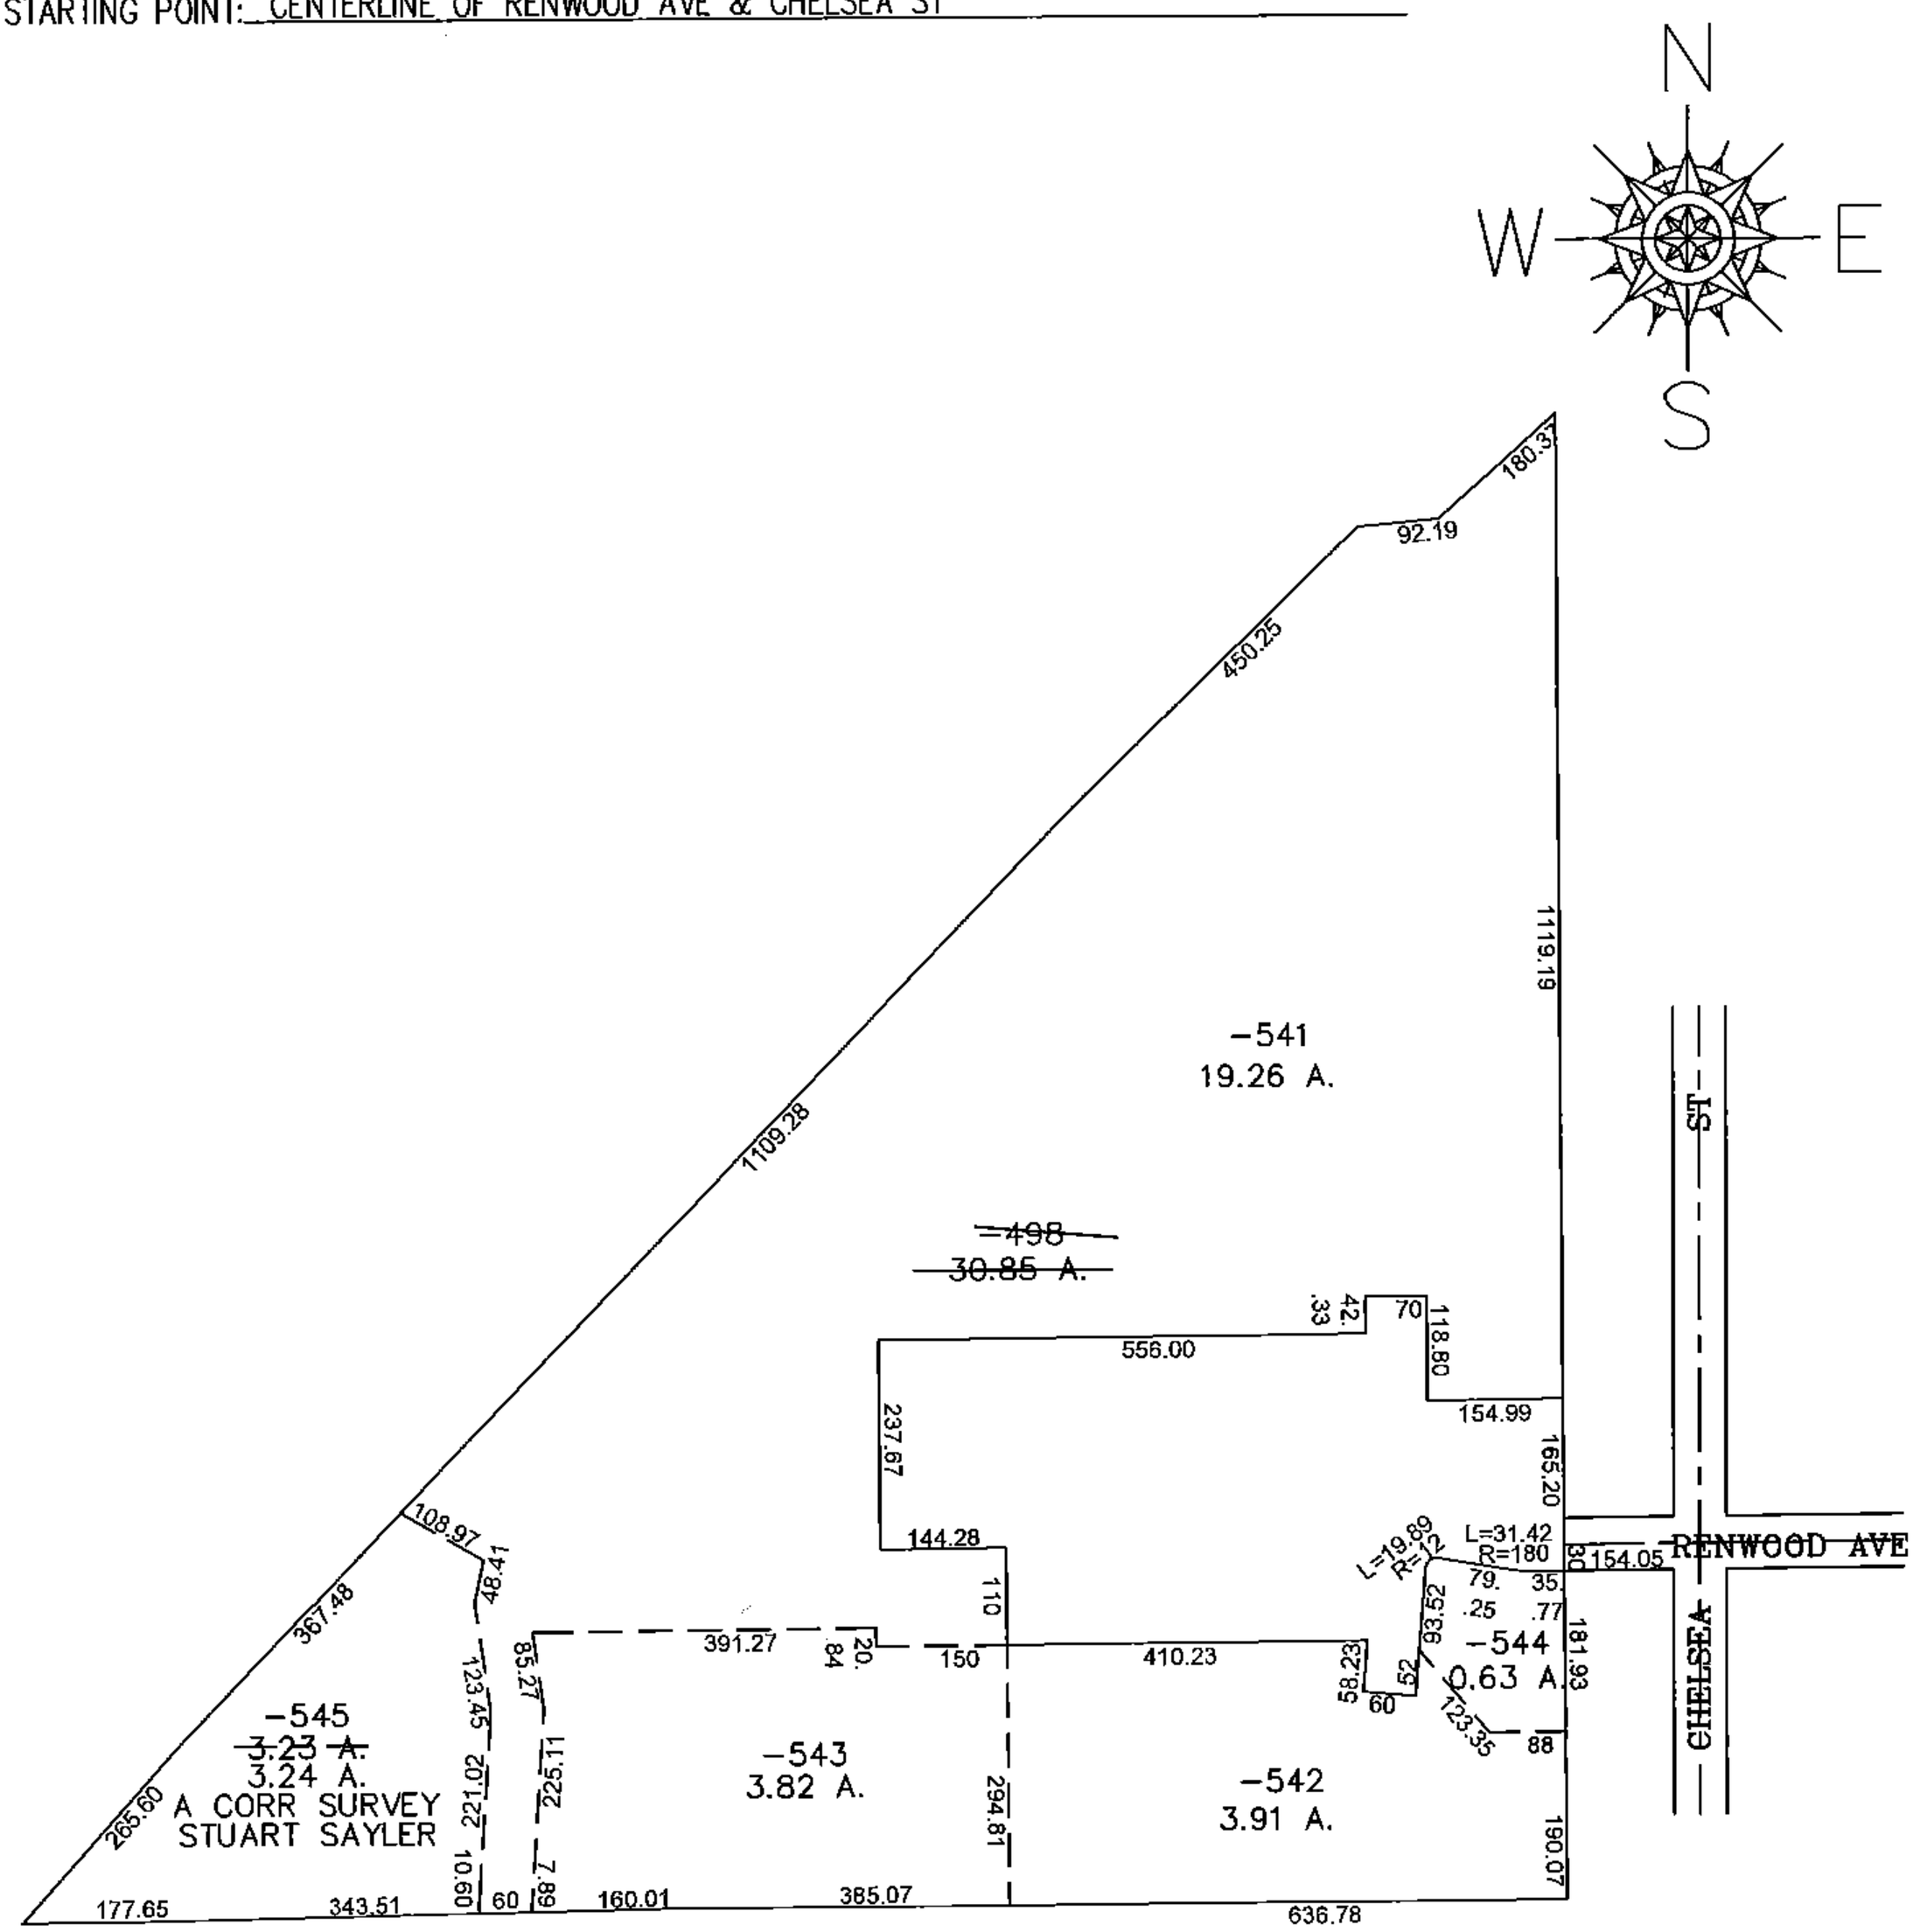

SPLITS/DEEDS PROCESSED

LORAIN COUNTY TAX MAP DEPARTMENT
226 MIDDLE AVE. ELYRIA, OHIO

SURVEYED BY: STUART SAYLOR

CLOSURE: 0.00 : 10,000

MAP PAGE(S): 04-00-003

APPROVED BY: JAH DATE: 12/7/2015

SCALE: 1"= 300 PRIOR INSTRUMENT: 20110395657