PARENT PARCEL: * SEE BELOW

CHILD PARCEL: 17-06-011-000-018, -019, -020 17-06-007-000-014

STARTING POINT: CENTERLINE OF ASHALND-KIPTON RD & TOWNSHIP LINE OF BRIGHTON TWP.

15-03454

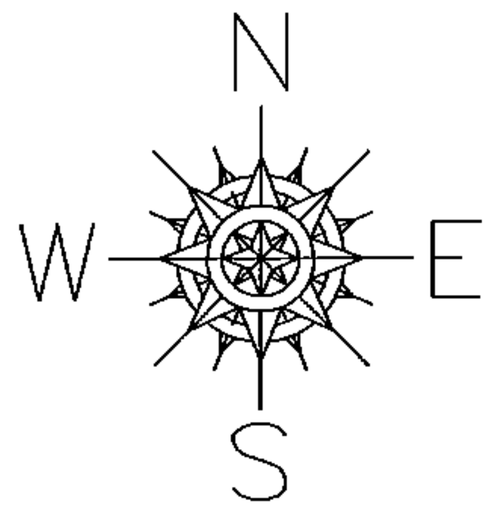

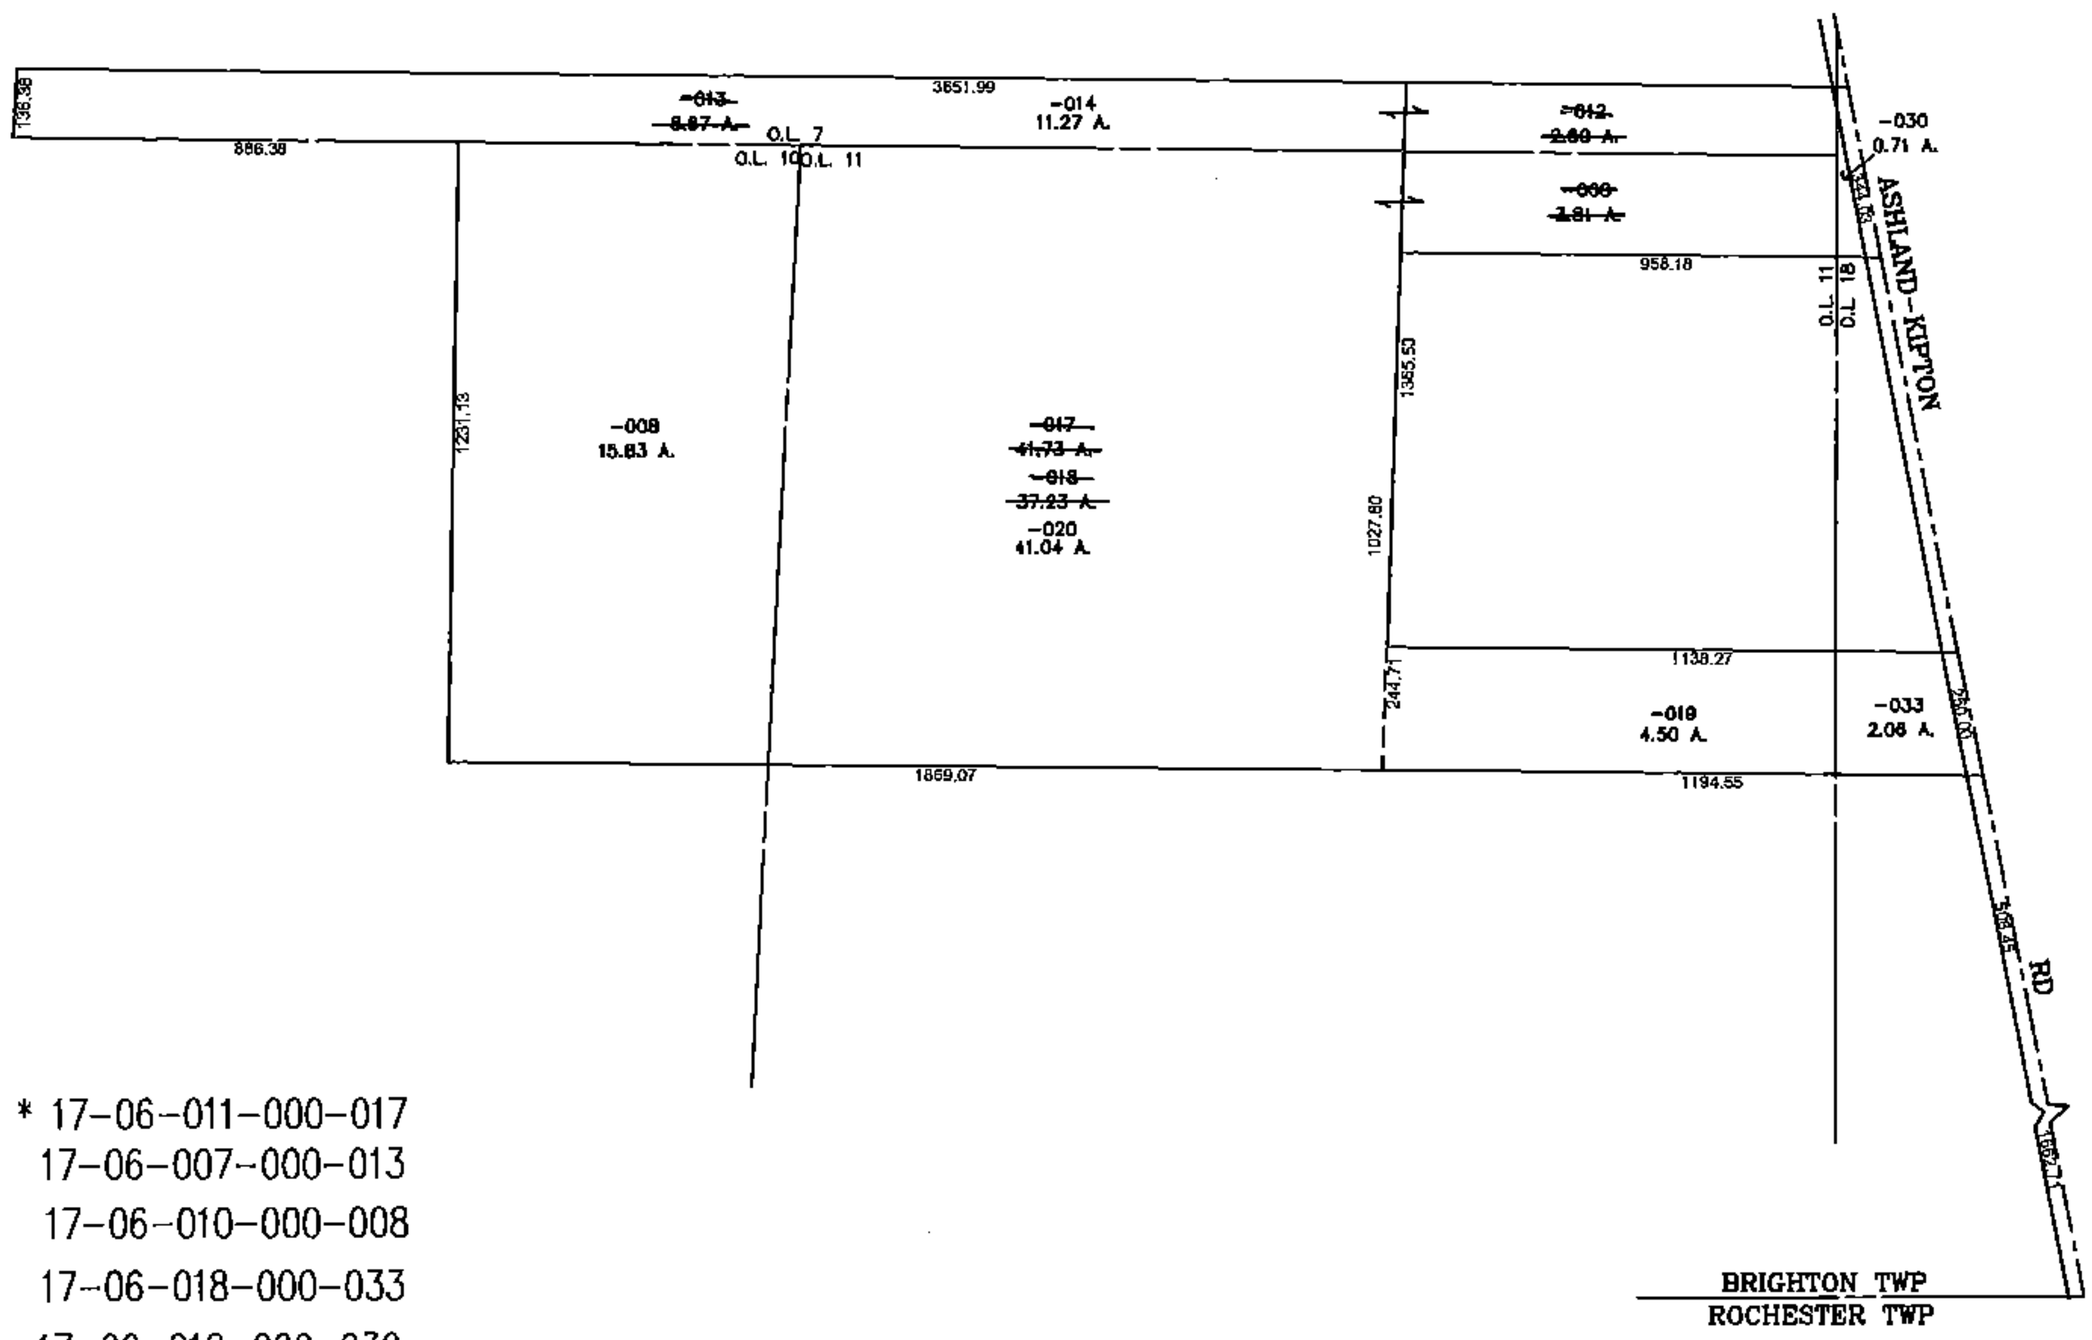

* 17-06-011-000-017
17-06-007-000-013
17-06-010-000-008
17-06-018-000-033
17-06-018-000-030
17-06-010-000-008

SPLITS/DEEDS PROCESSED

LORAIN COUNTY TAX MAP DEPARTMENT
226 MIDDLE AVE. ELYRIA, OHIO

SURVEYED BY: THOMAS SNEZEK

CLOSURE: 0.00 : 10,000

MAP PAGE(S): 17-06-011

APPROVED BY: JAH DATE: 12/15/15

SCALE: 1"= 600 PRIOR INSTRUMENT: 20130462205