PARENT PARCEL: 15-00-098-108-118

CHILD PARCEL: 15-00-098-108-271 THRU -276

STARTING POINT: CENTERLINE OF STABLE RD & PALOMINO CT

15-03462

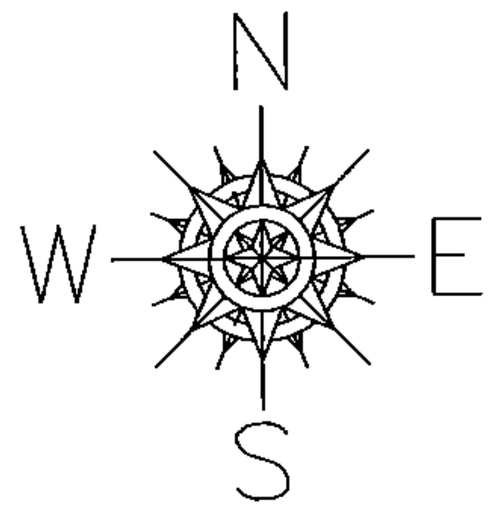

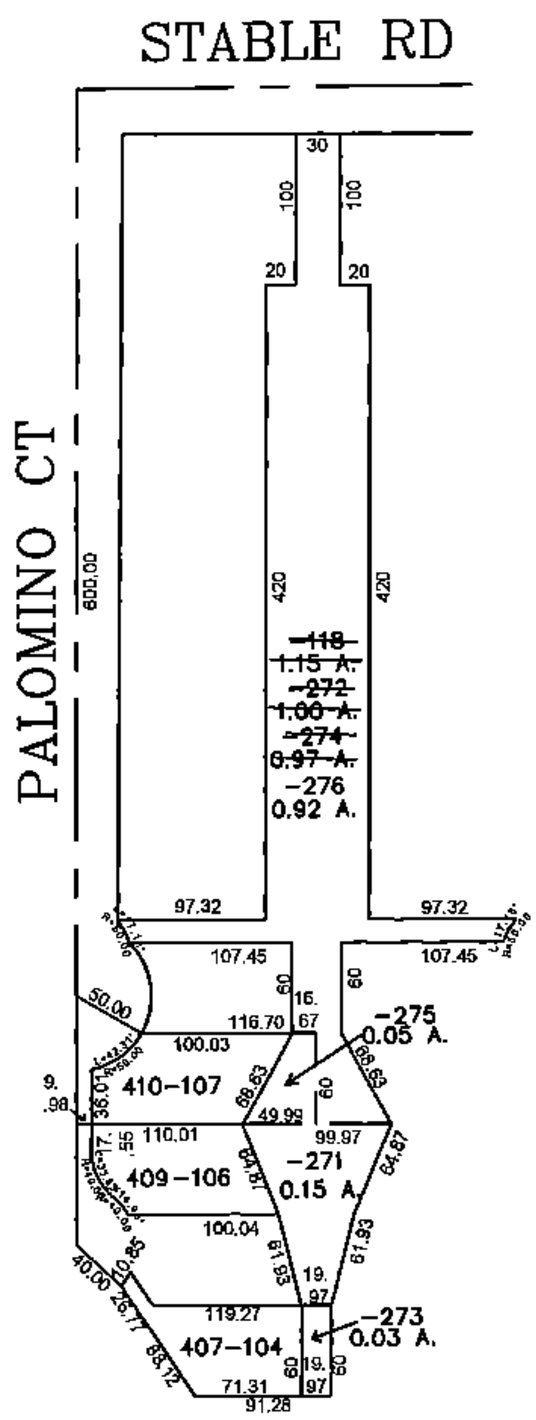

SPLITS/DEEDS PROCESSED

LORAIN COUNTY TAX MAP DEPARTMENT
226 MIDDLE AVE. ELYRIA, OHIO

SURVEYED BY: THOMAS SIMON

CLOSURE: 0.00 : 10,000

MAP PAGE(S): 15-00-098

APPROVED BY: JAH DATE: 12/21/2015

SCALE: 1"= 200 PRIOR INSTRUMENT: 20150554268