PARENT PARCEL: 06-24-102-000-002 & -003

CHILD PARCEL: XX-XX-XXX-XXX-XXX

STARTING POINT: NORTH LINE OF WOODFORD AVE. & WEST LINE OF B&O R.R.

16-03466-C

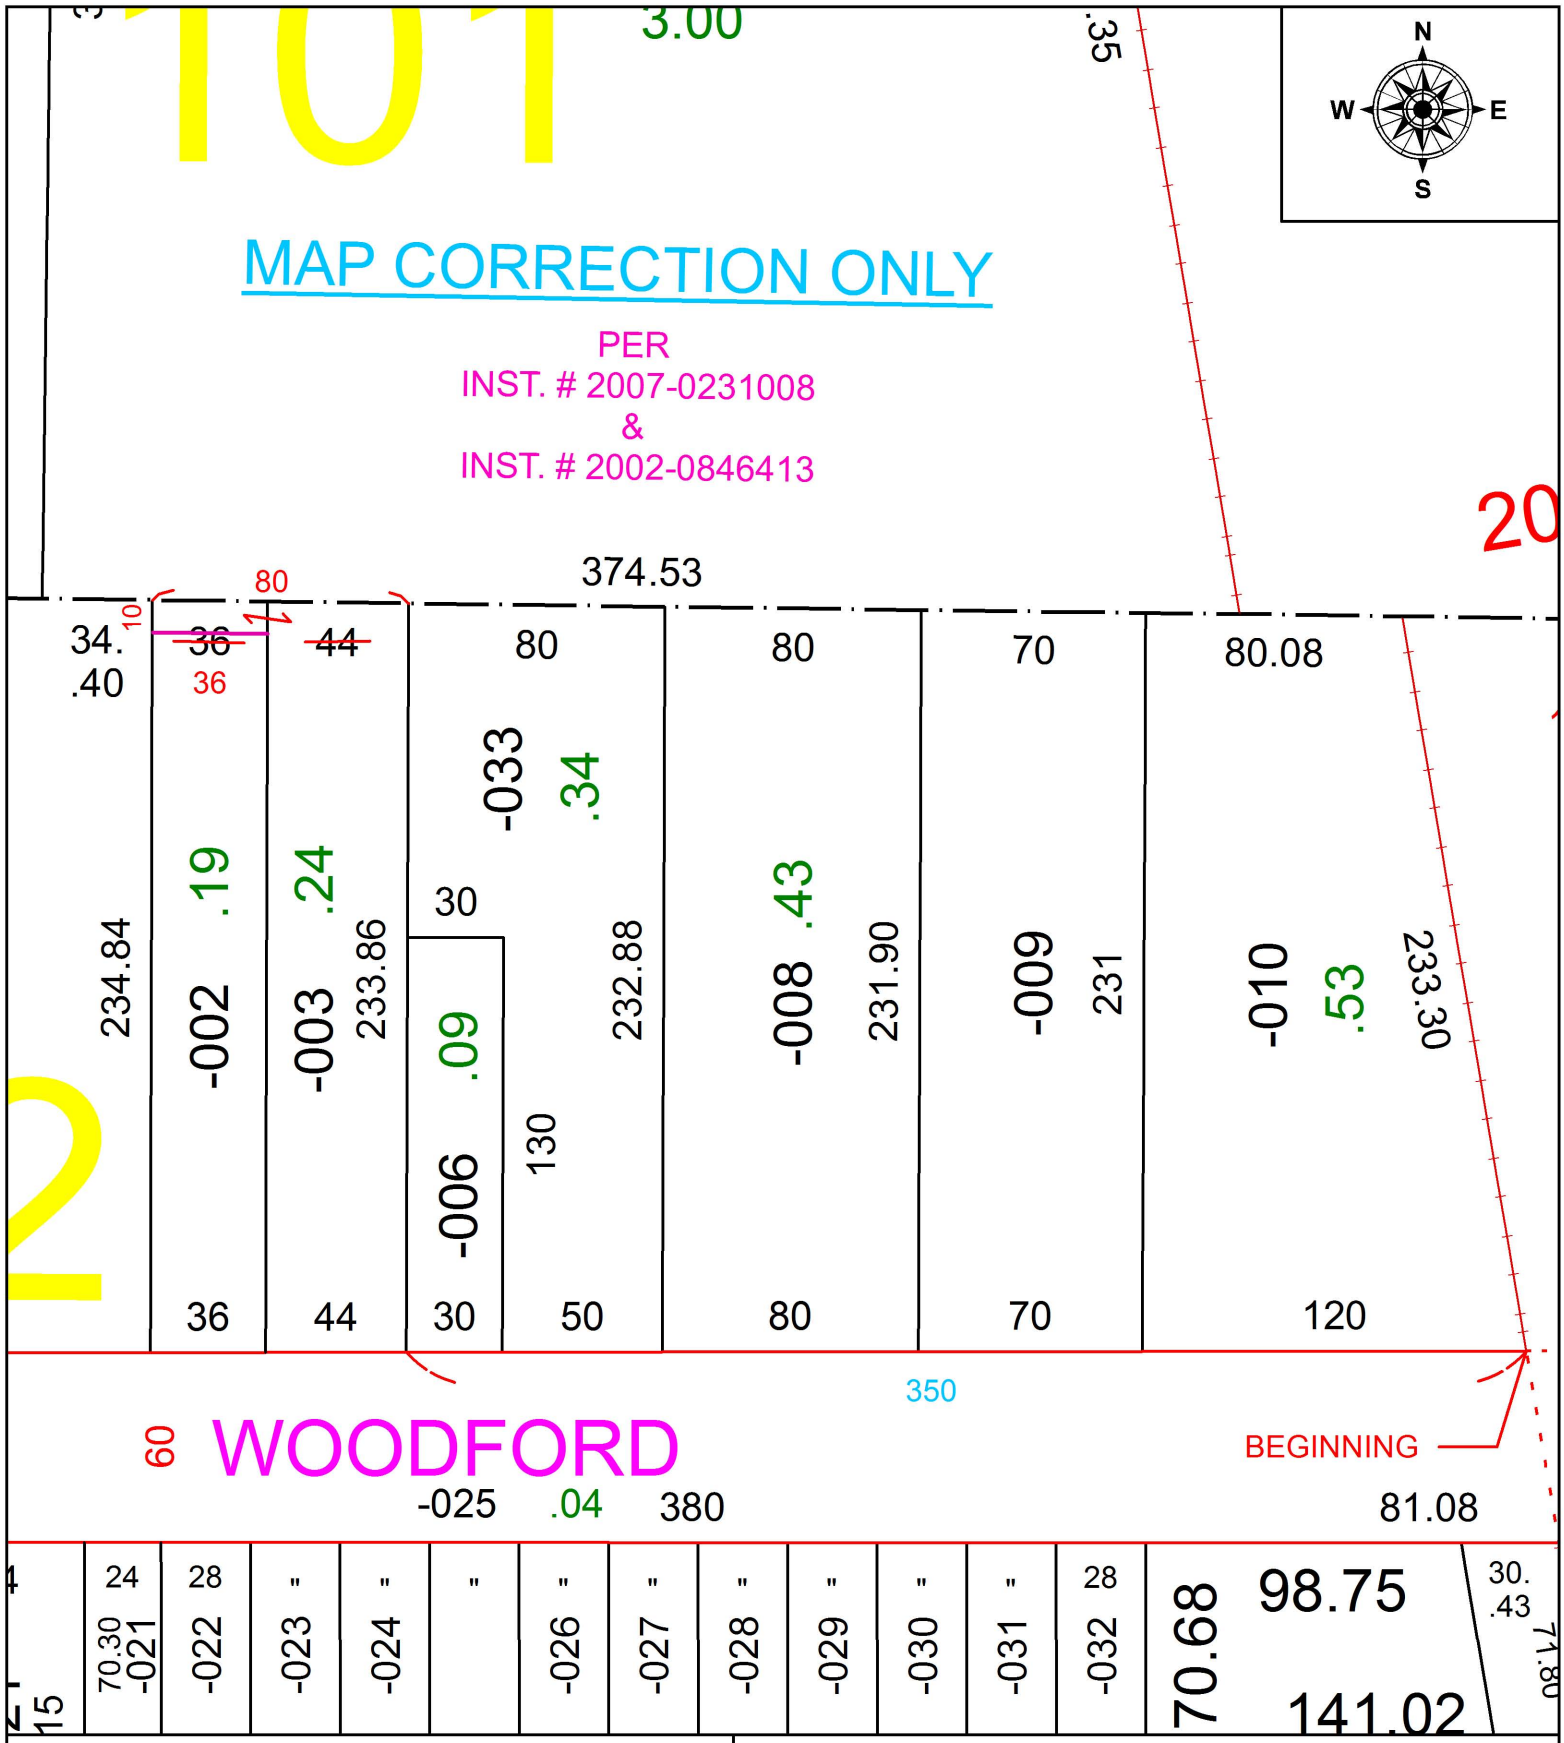

SPLITS/DEEDS PROCESSED

LORAIN COUNTY TAX MAP DEPARTMENT
226 MIDDLE AVE. ELYRIA, OH

SURVEYED BY: NA
CLOSURE: NA
MAP PAGE(S): 06-24-102
APPOVED BY: TJS **DATE:** 6/9/16
SCALE: 1" = 60 **PRIOR INSTRUMENT:** DV 512/343