PARENT PARCEL: 05-00-024-110-010 & -011

CHILD PARCEL: XX-XX-XXX-XXX-XXX

STARTING POINT: S.W. CORNER OF S/L 331 IN J.C.BARNEY'S ADDITION PV. 2 PG. 7

16-03467-C

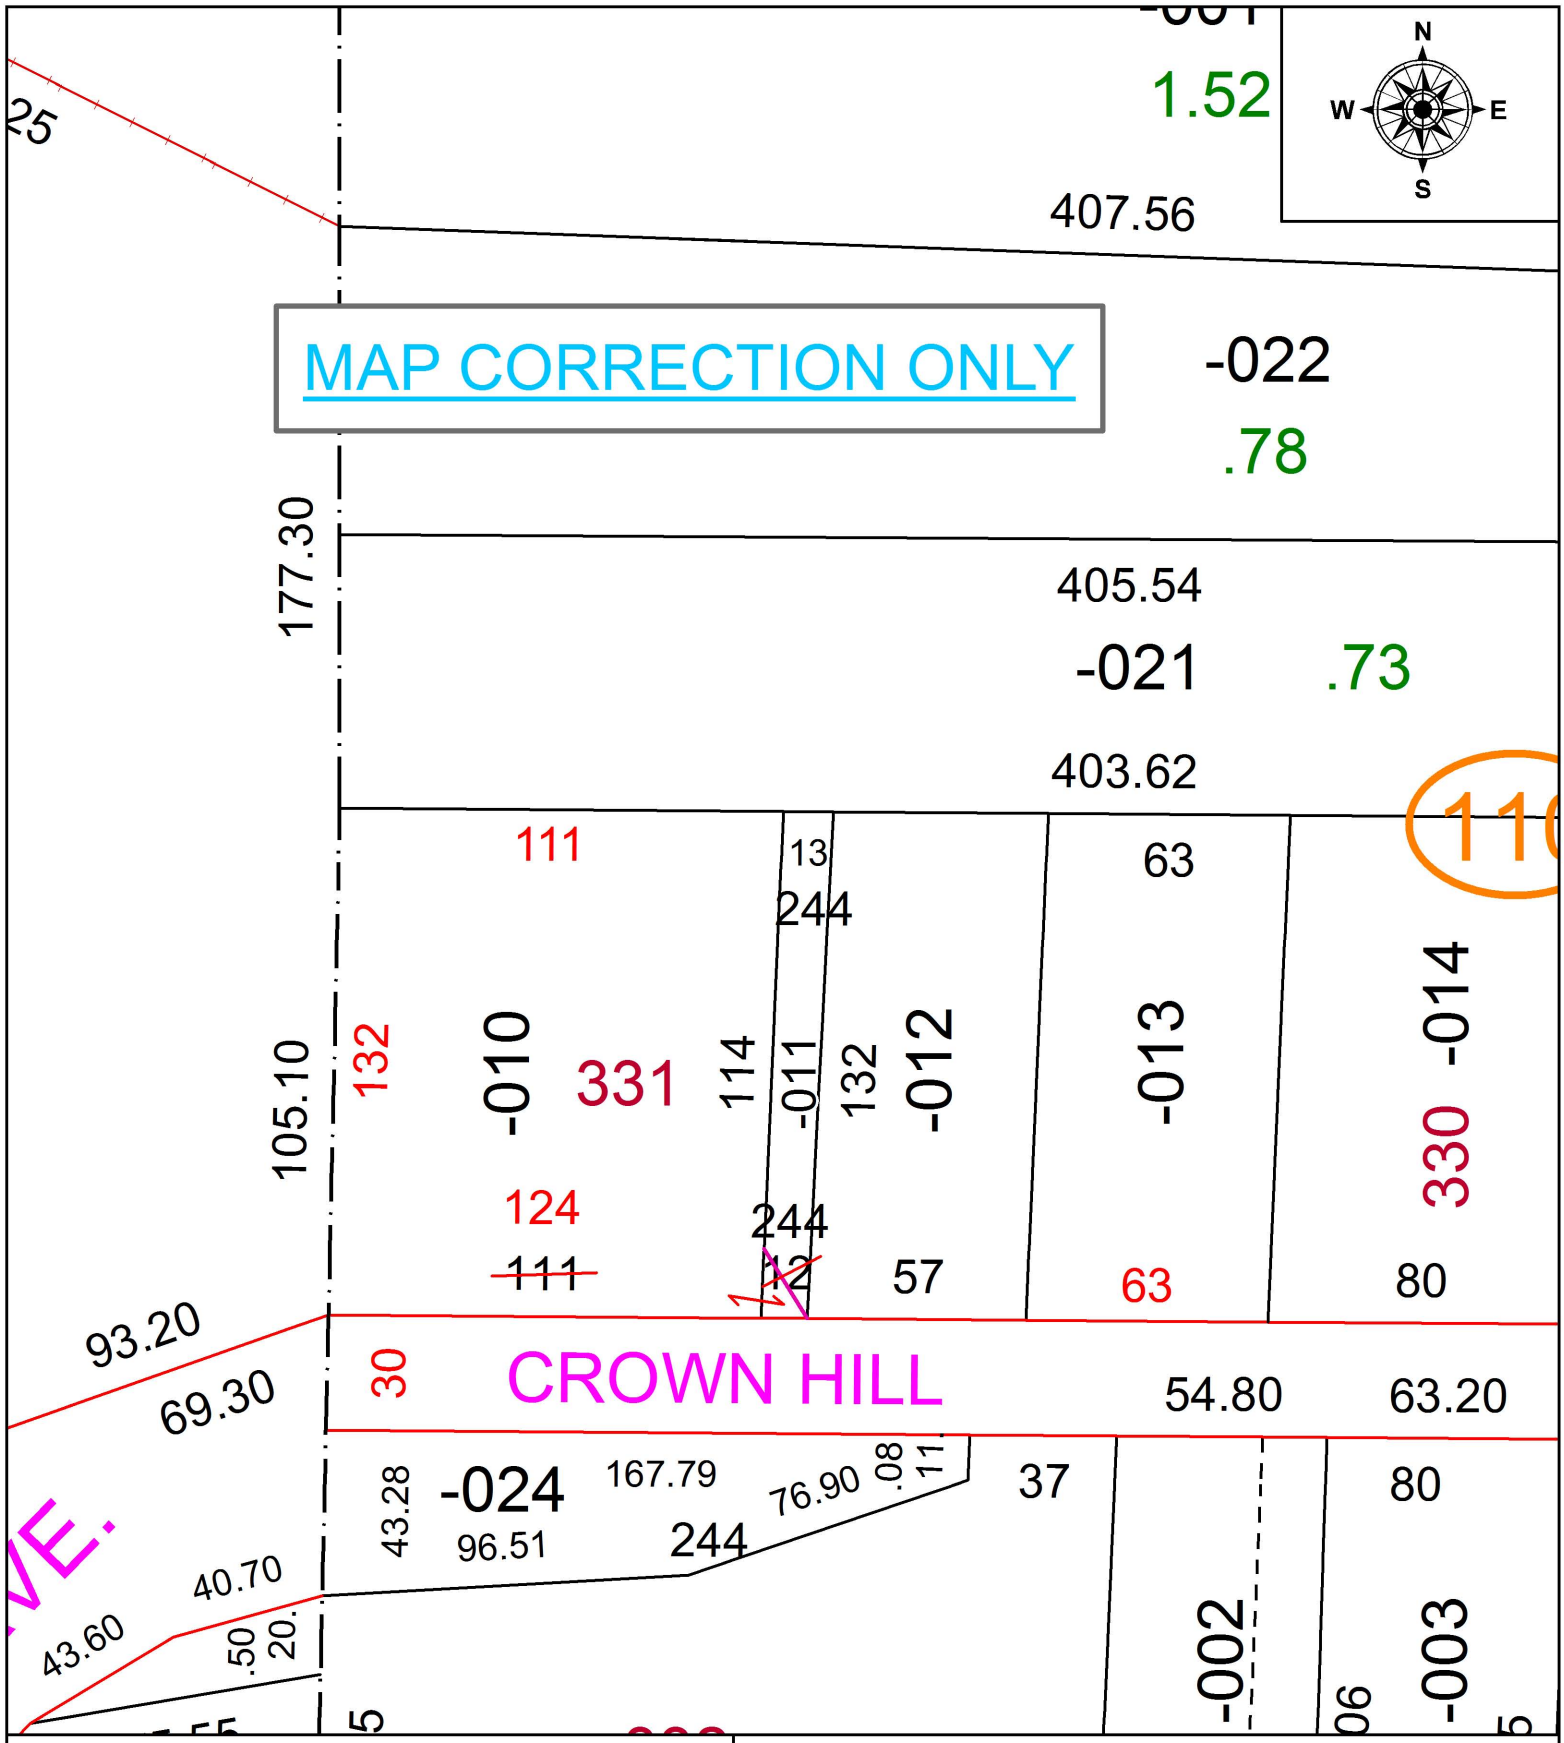

SPLITS/DEEDS PROCESSED

LORAIN COUNTY TAX MAP DEPARTMENT
226 MIDDLE AVE. ELYRIA, OH

SURVEYED BY: NA
CLOSURE: NA
MAP PAGE(S): 05-00-024
APPOVED BY: TJS **DATE:** 6/10/16
SCALE: 1" = 200 **PRIOR INSTRUMENT:** 2004-0045938