PARENT PARCEL: 09-00-055-000-001

CHILD PARCEL: XX-XX-XXX-XXX-XXX

STARTING POINT: BEING THE NORTH PART OF O.L. 55 EXTENDING SOUTH FAR ENOUGH TO CONTAIN 44.42 AC.

16-03469-A

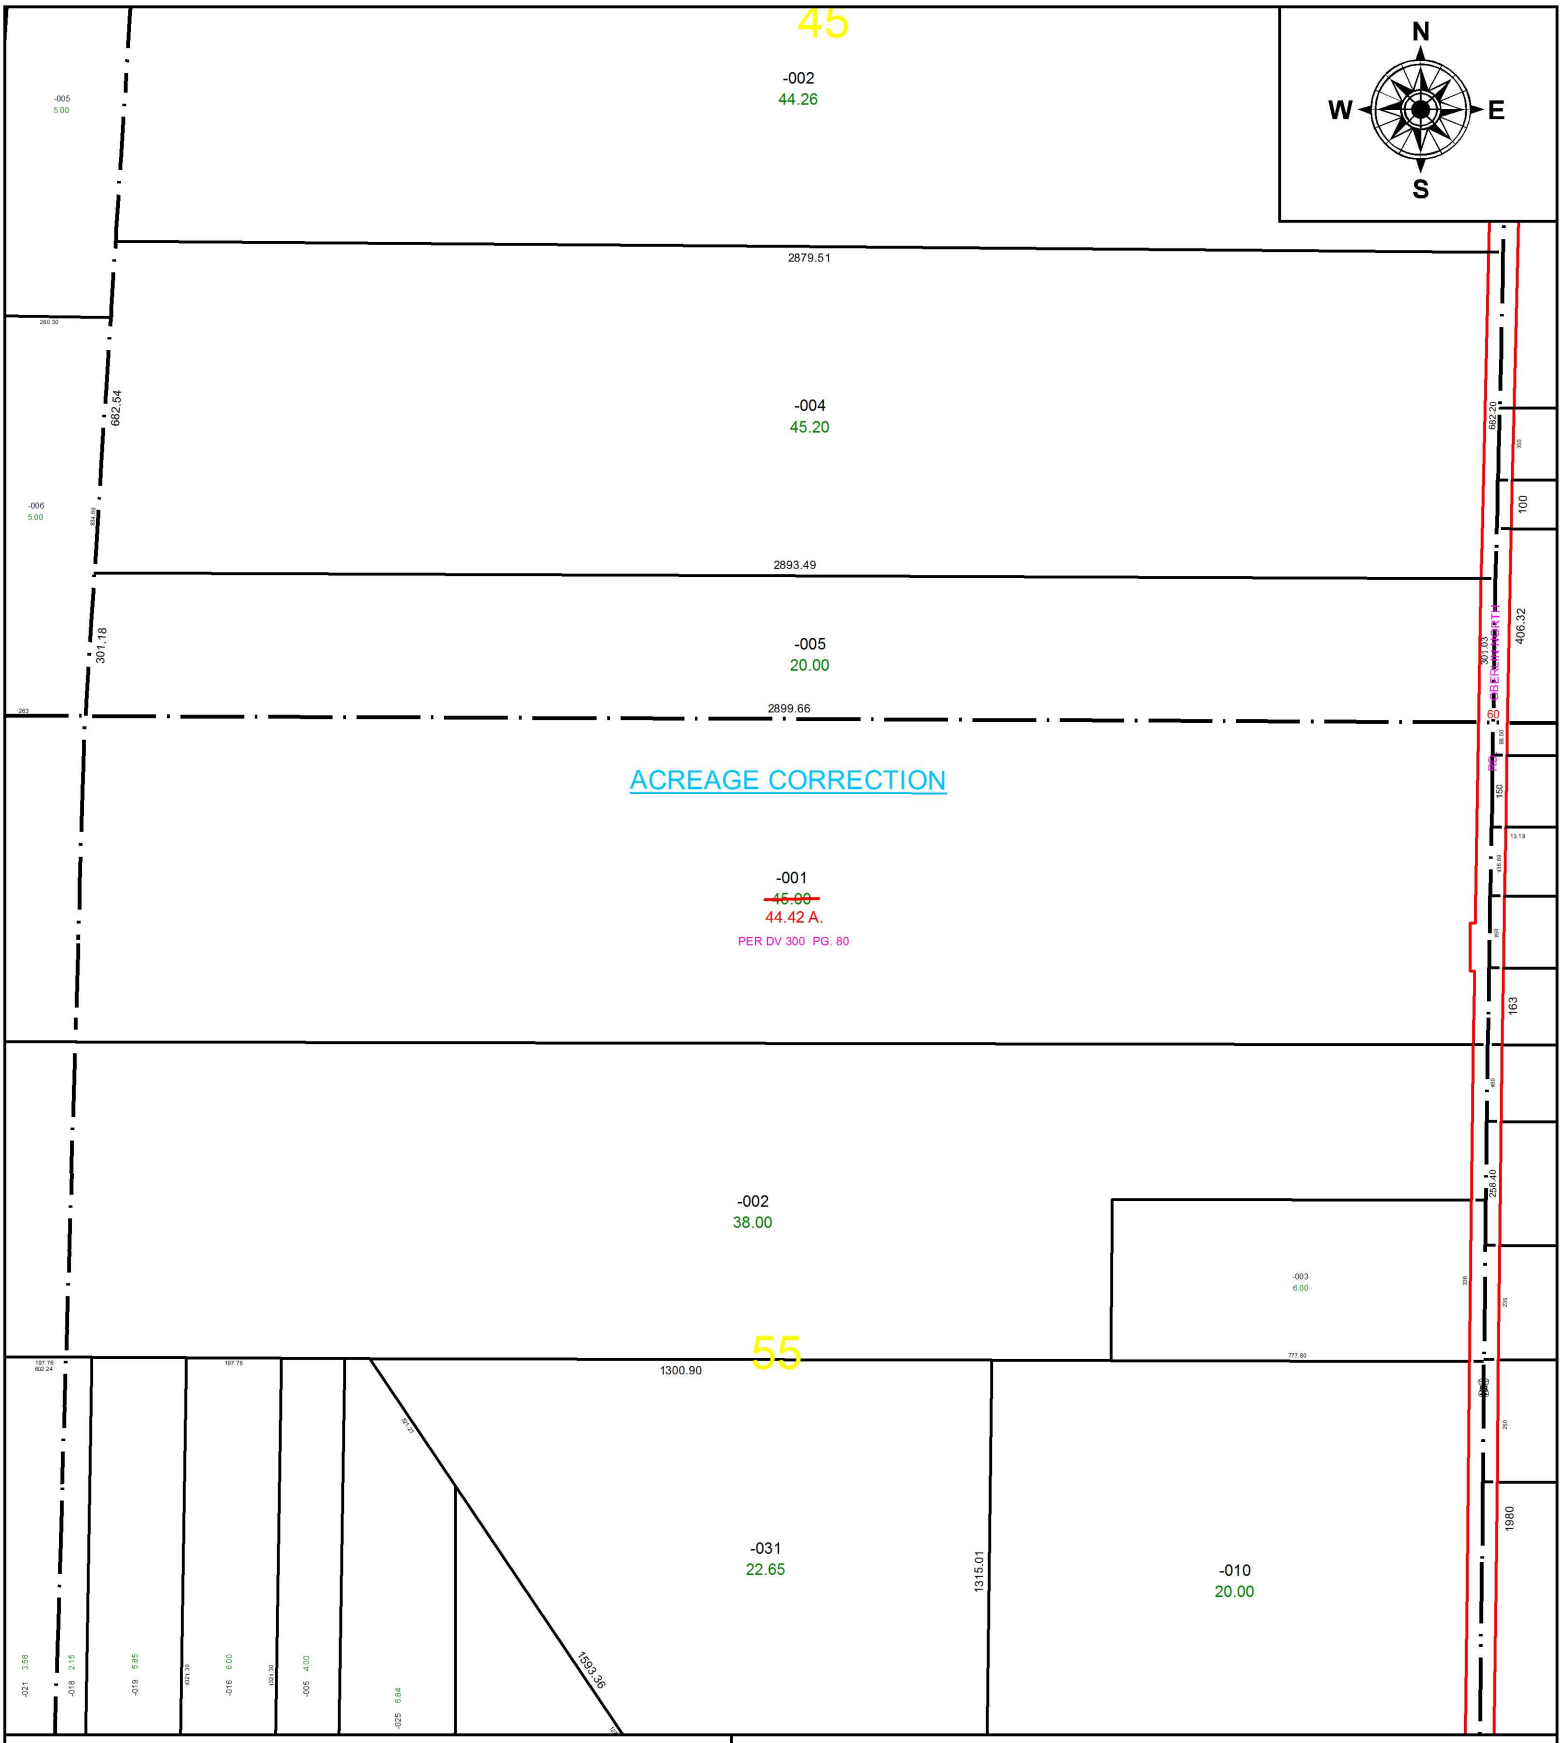

SPLITS/DEEDS PROCESSED

LORAIN COUNTY TAX MAP DEPARTMENT
226 MIDDLE AVE. ELYRIA, OH

SURVEYED BY: NA

CLOSURE: NA

MAP PAGE(S): 09-00-055

APPOVED BY: TJS **DATE:** 6/17/16

SCALE: 1" = 400 **PRIOR INSTRUMENT:** DV 300/80