PARENT PARCEL: 09-00-011-000-006
CHILD PARCEL: XX-XX-XXX-XXX-XXX
STARTING POINT: INTERSECTION OF C/L OF RUSSIA RD. AND WEST LINE OF O.L.11

16-03472-D

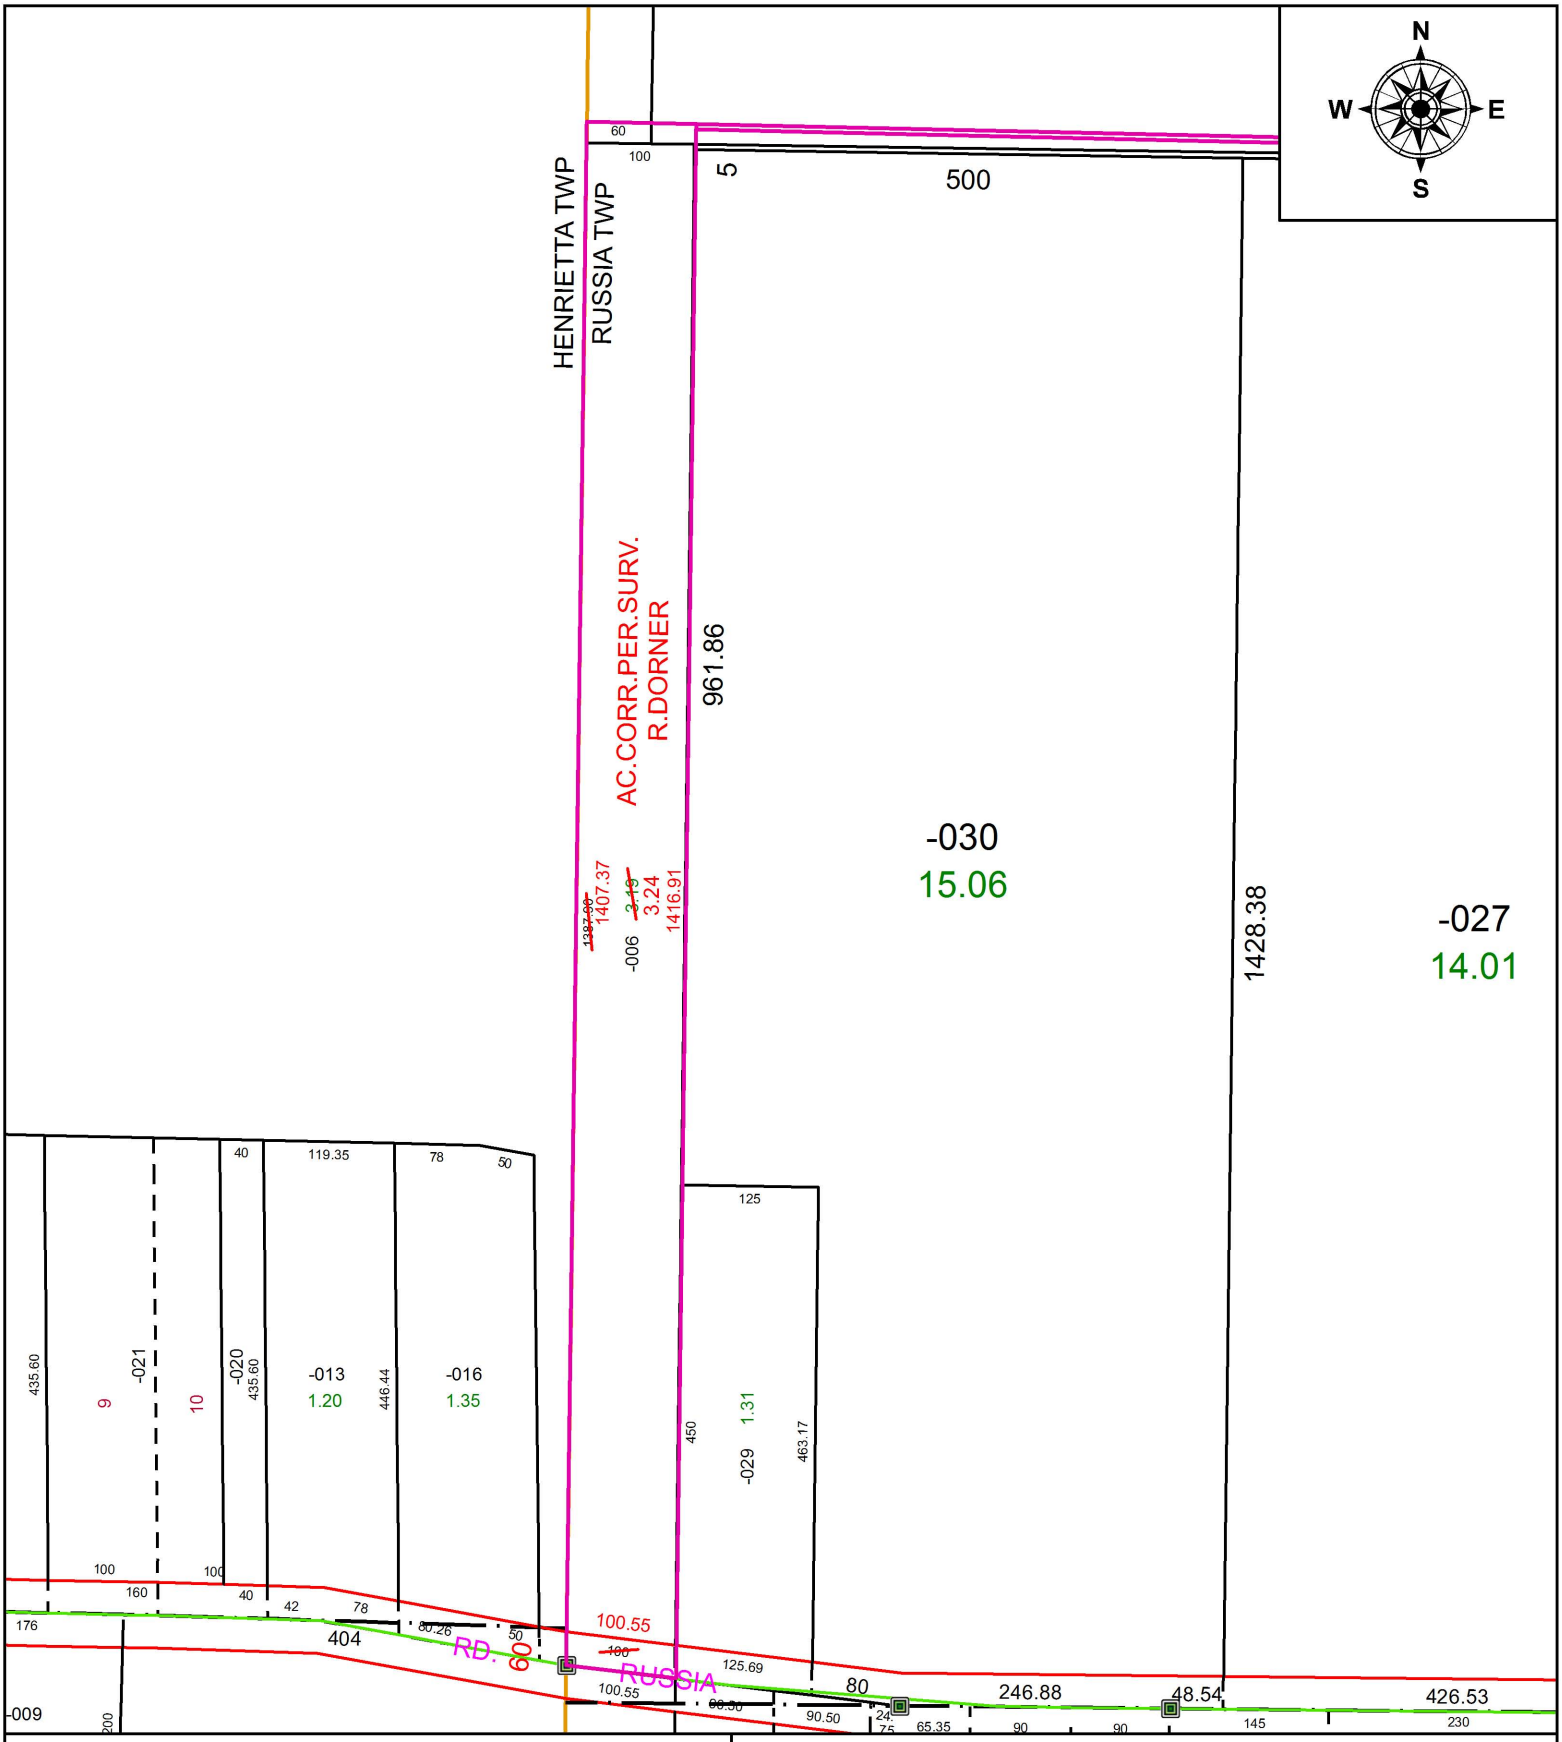

SPLITS/DEEDS PROCESSED
LORAIN COUNTY TAX MAP DEPARTMENT
226 MIDDLE AVE. ELYRIA, OH

SURVEYED BY: ROBERT A. DORNER
CLOSURE: 1: 582,445
MAP PAGE(S): 9-00-011-A
APPOVED BY: RRM **DATE:** 6-21-16
SCALE: 1" = 175 **PRIOR INSTRUMENT:** 20160576408