PARENT PARCEL: 07-00-028-103-014 & -142

CHILD PARCEL: XX-XX-XXX-XXX-XXX

STARTING POINT: LOR-20-2213 R.O.W. MONUMENT (STA 156+00)

16-03474-D

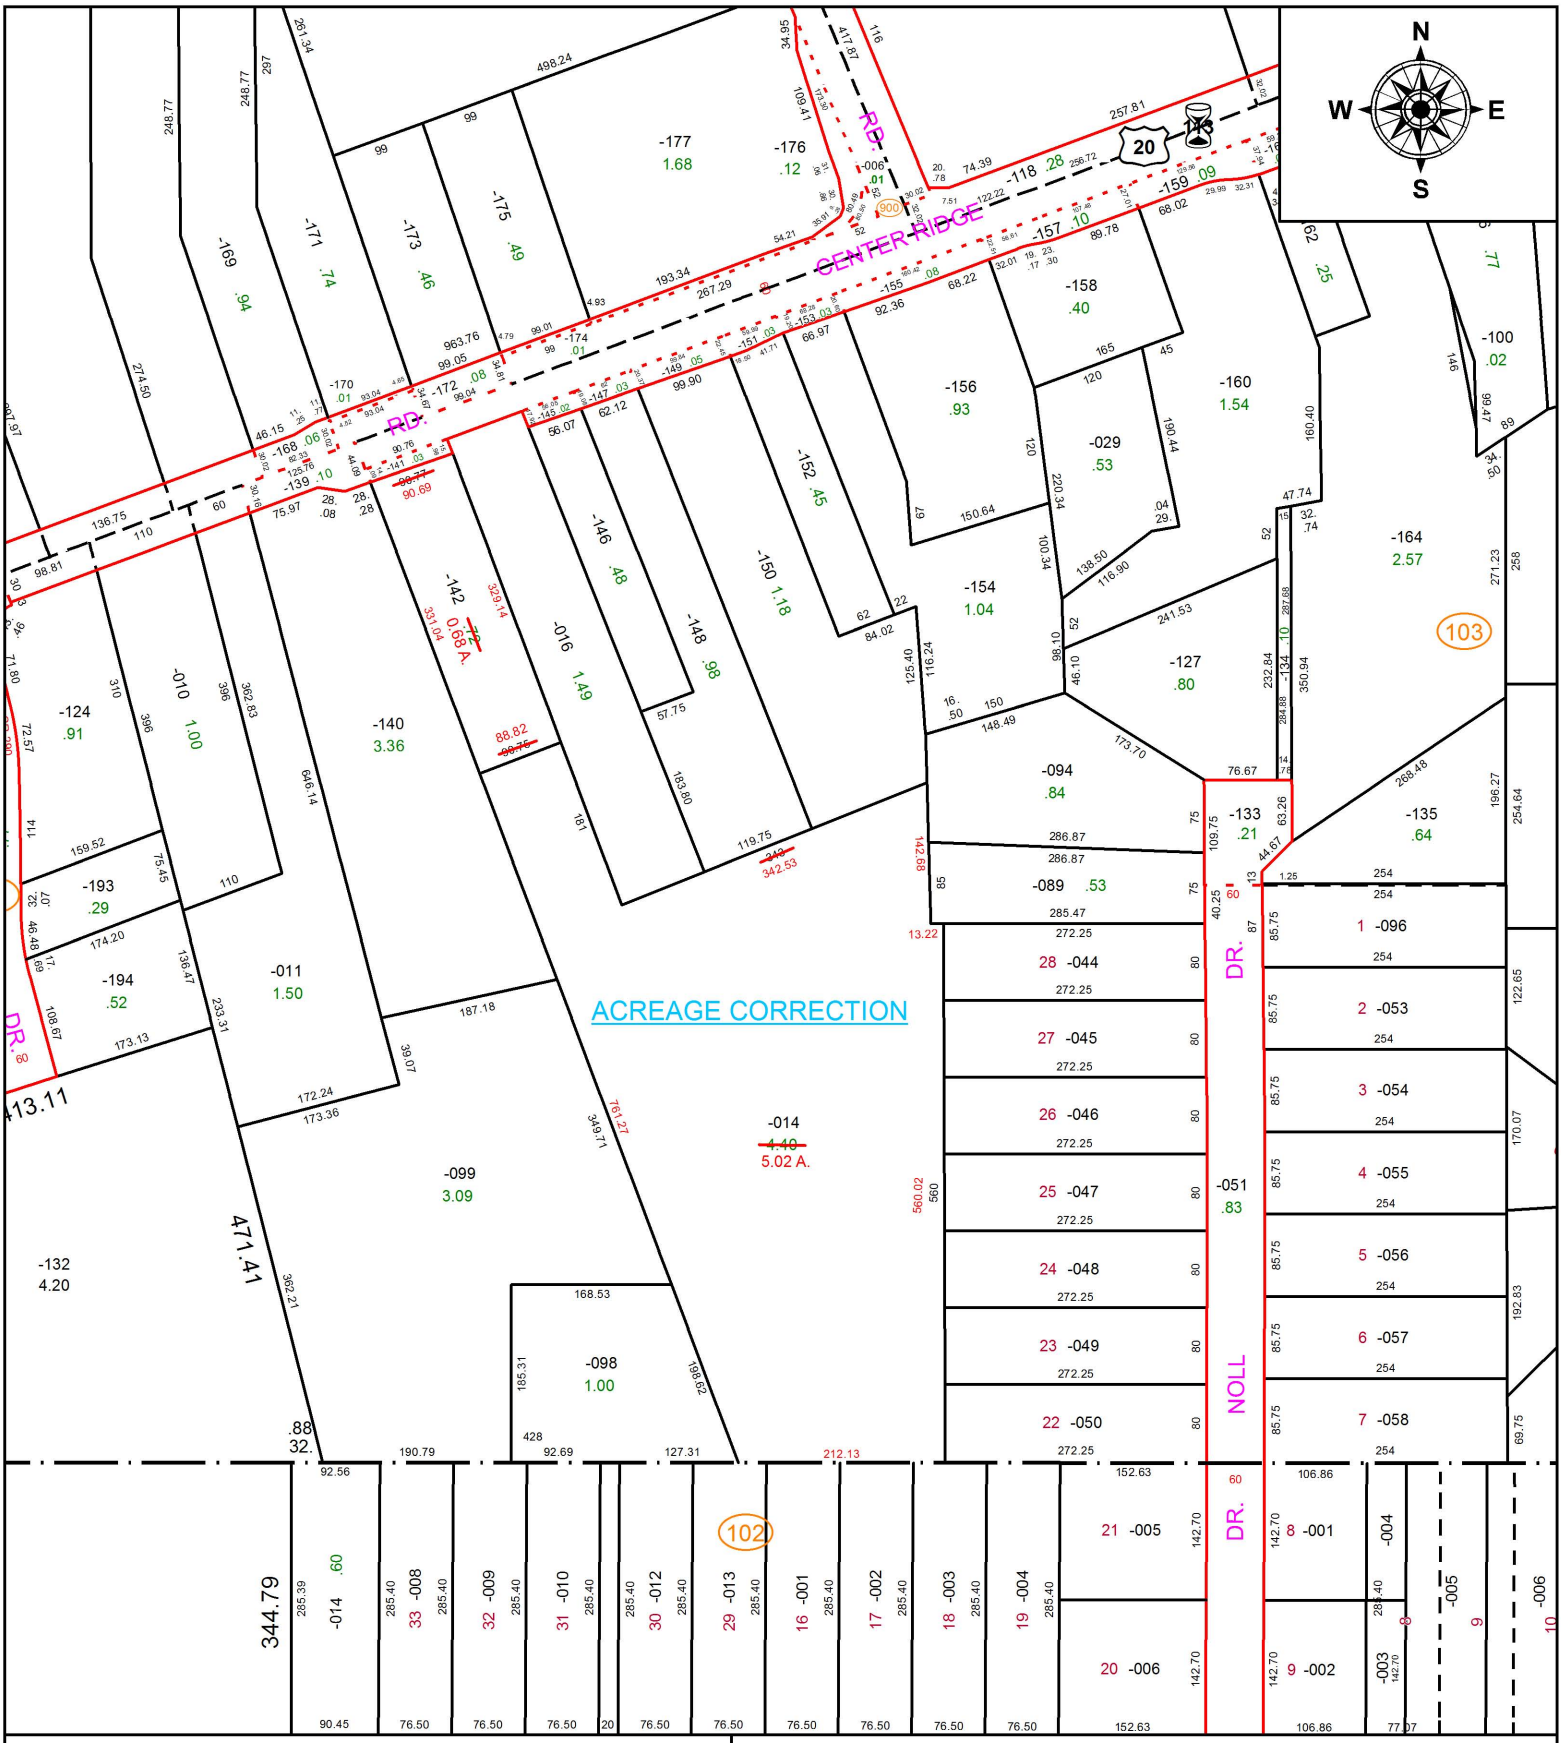

SPLITS/DEEDS PROCESSED

LORAIN COUNTY TAX MAP DEPARTMENT
226 MIDDLE AVE. ELYRIA, OH

SURVEYED BY: RICHARD D. CARLSON

CLOSURE: 1: 142,000

MAP PAGE(S): 07-00-028

APPOVED BY: TJS **DATE:** 8/8/16

SCALE: 1" = 200 **PRIOR INSTRUMENT:** DV 1397/606