PARENT PARCEL: 06-24-010-102-019 & 06-24-102-000-031
CHILD PARCEL: XX-XX-XXX-XXX-XXX
STARTING POINT: EAST R.O.W. OF GARDEN ST. & SOUTH R.O.W. OF WOODFORD AVE.

16-03479-D

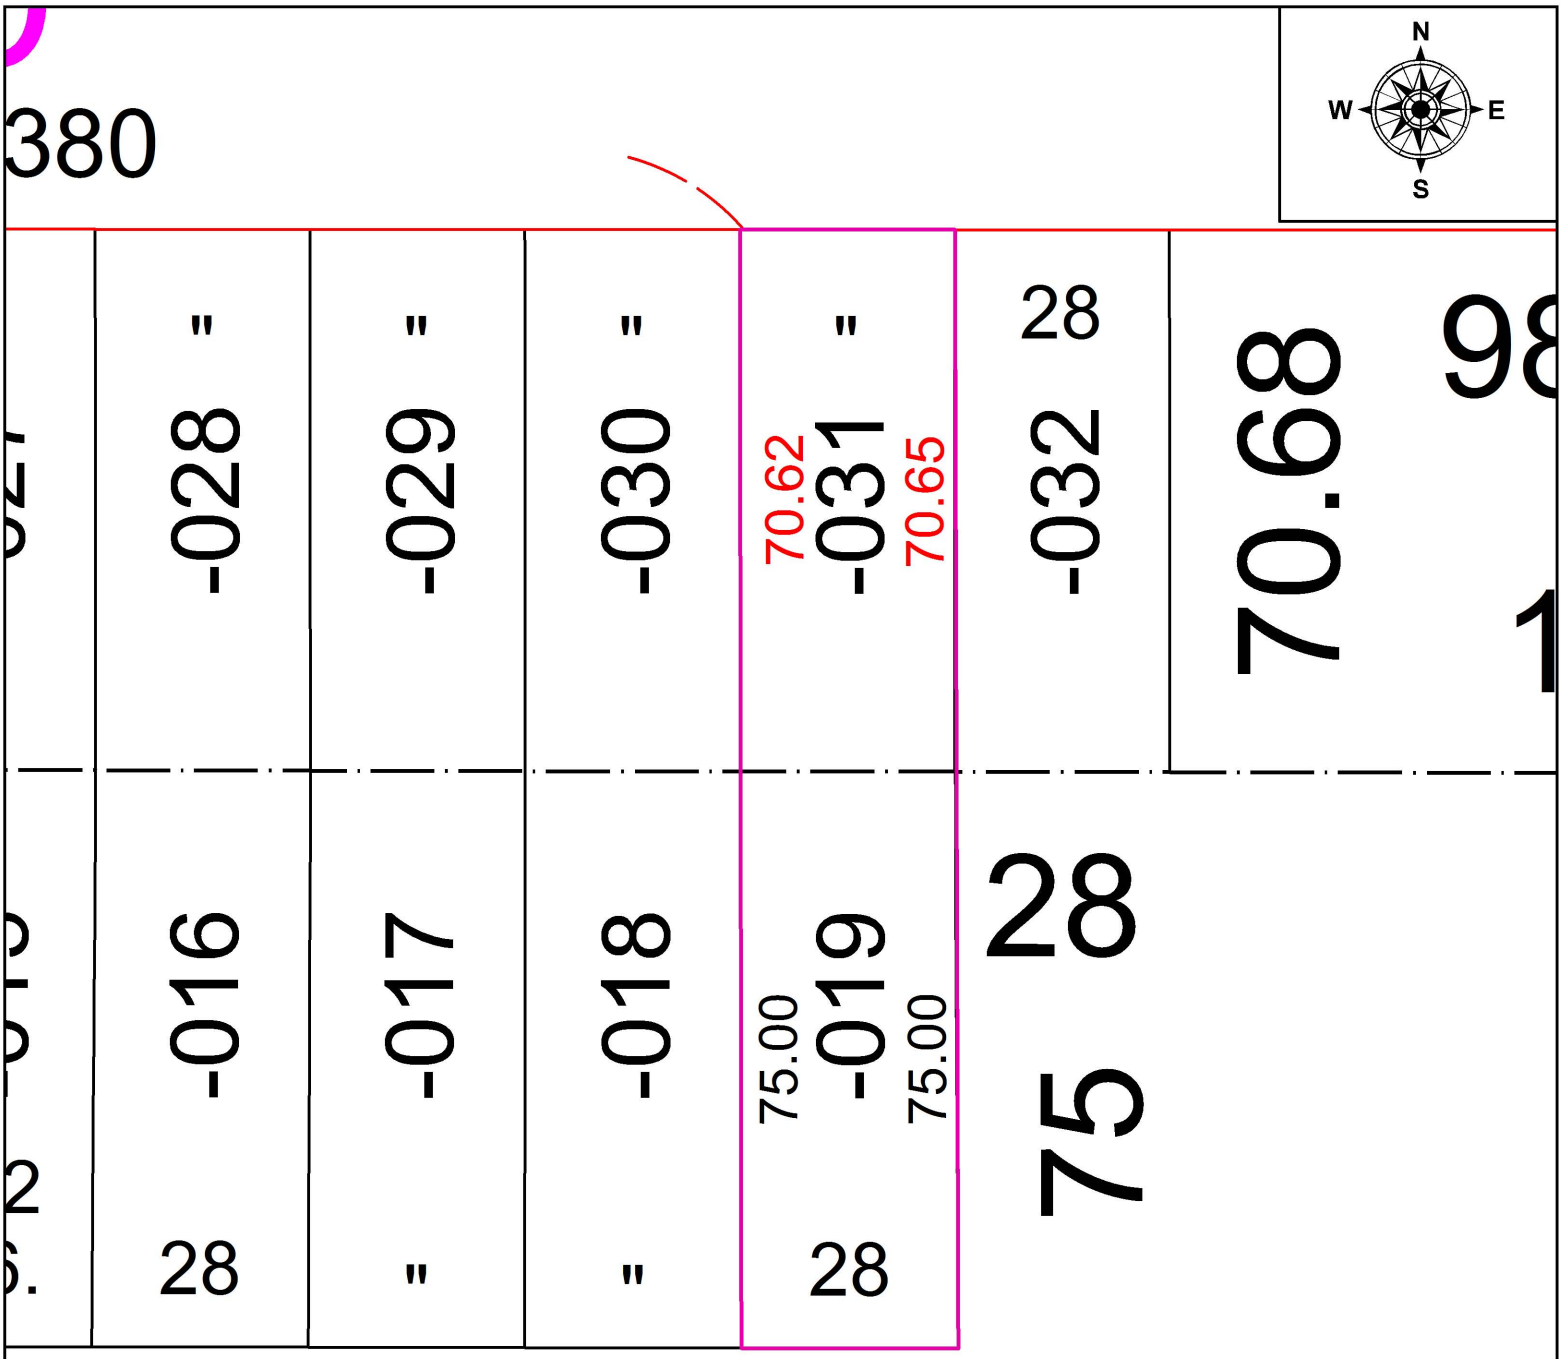

DEPTH CORRECTION

06-24-102-000-031

~~28 X 70~~

28.00 X 70.65

CORR. PER SURV.
J. YURKSCHATT

SPLITS/DEEDS PROCESSED
LORAIN COUNTY TAX MAP DEPARTMENT
226 MIDDLE AVE. ELYRIA, OH

SURVEYED BY: JAMES P. YURKSCHATT
CLOSURE: 1: 33,000
MAP PAGE(S): 06-24-010 & 06-24-102
APPOVED BY: TJS **DATE:** 7/8/16
SCALE: 1" = 25 **PRIOR INSTRUMENT:** 2016-0576836