PARENT PARCEL: 05-00-048-000-044, -012, -013, -014, -045

CHILD PARCEL: 05-00-048-000-068 THRU -071

STARTING POINT: INTERSECTION OF CENTERLINES OF TELEGRAPH RD & LEAVITT RD

16-03481

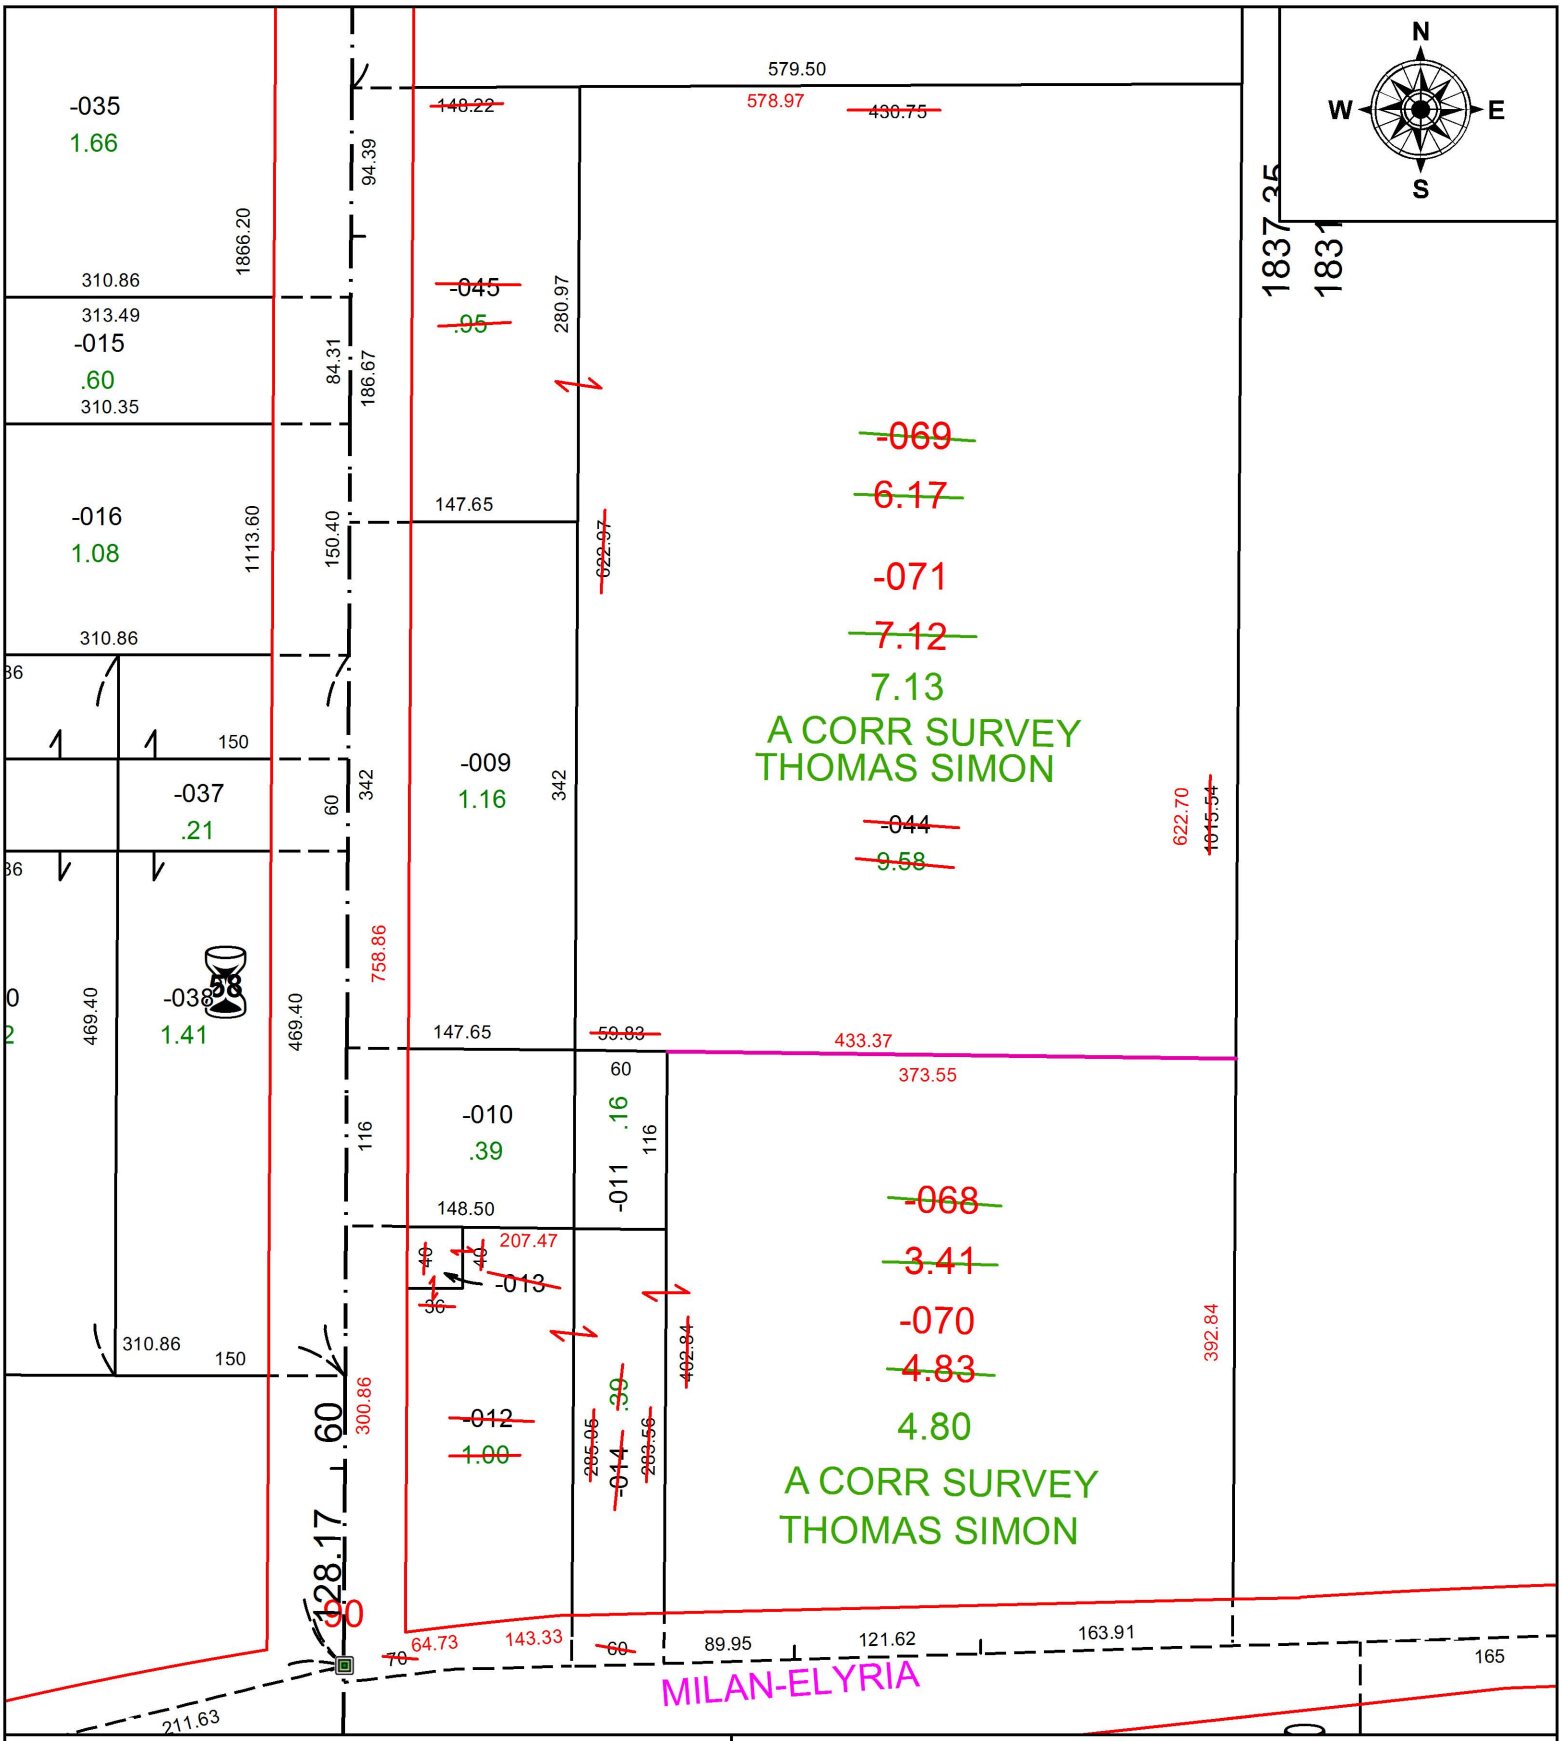

SPLITS/DEEDS PROCESSED

LORAIN COUNTY TAX MAP DEPARTMENT
226 MIDDLE AVE. ELYRIA, OH

SURVEYED BY: THOMAS SIMON
CLOSURE: 1: 33,000
MAP PAGE(S): 05-00-048
APPOVED BY: JAH **DATE:** 2/16/16
SCALE: 1 in = 125 ft **PRIOR INSTRUMENT:** 2014-0517550