PARENT PARCEL: 05-00-042-104-066 & -067

CHILD PARCEL: XX-XX-XXX-XXX-XXX

STARTING POINT: I.P. FD., N.E. CORNER OF S/L 27 IN ROCK CREEK RUN SUB. PV. 21 PG. 32

16-03482-A

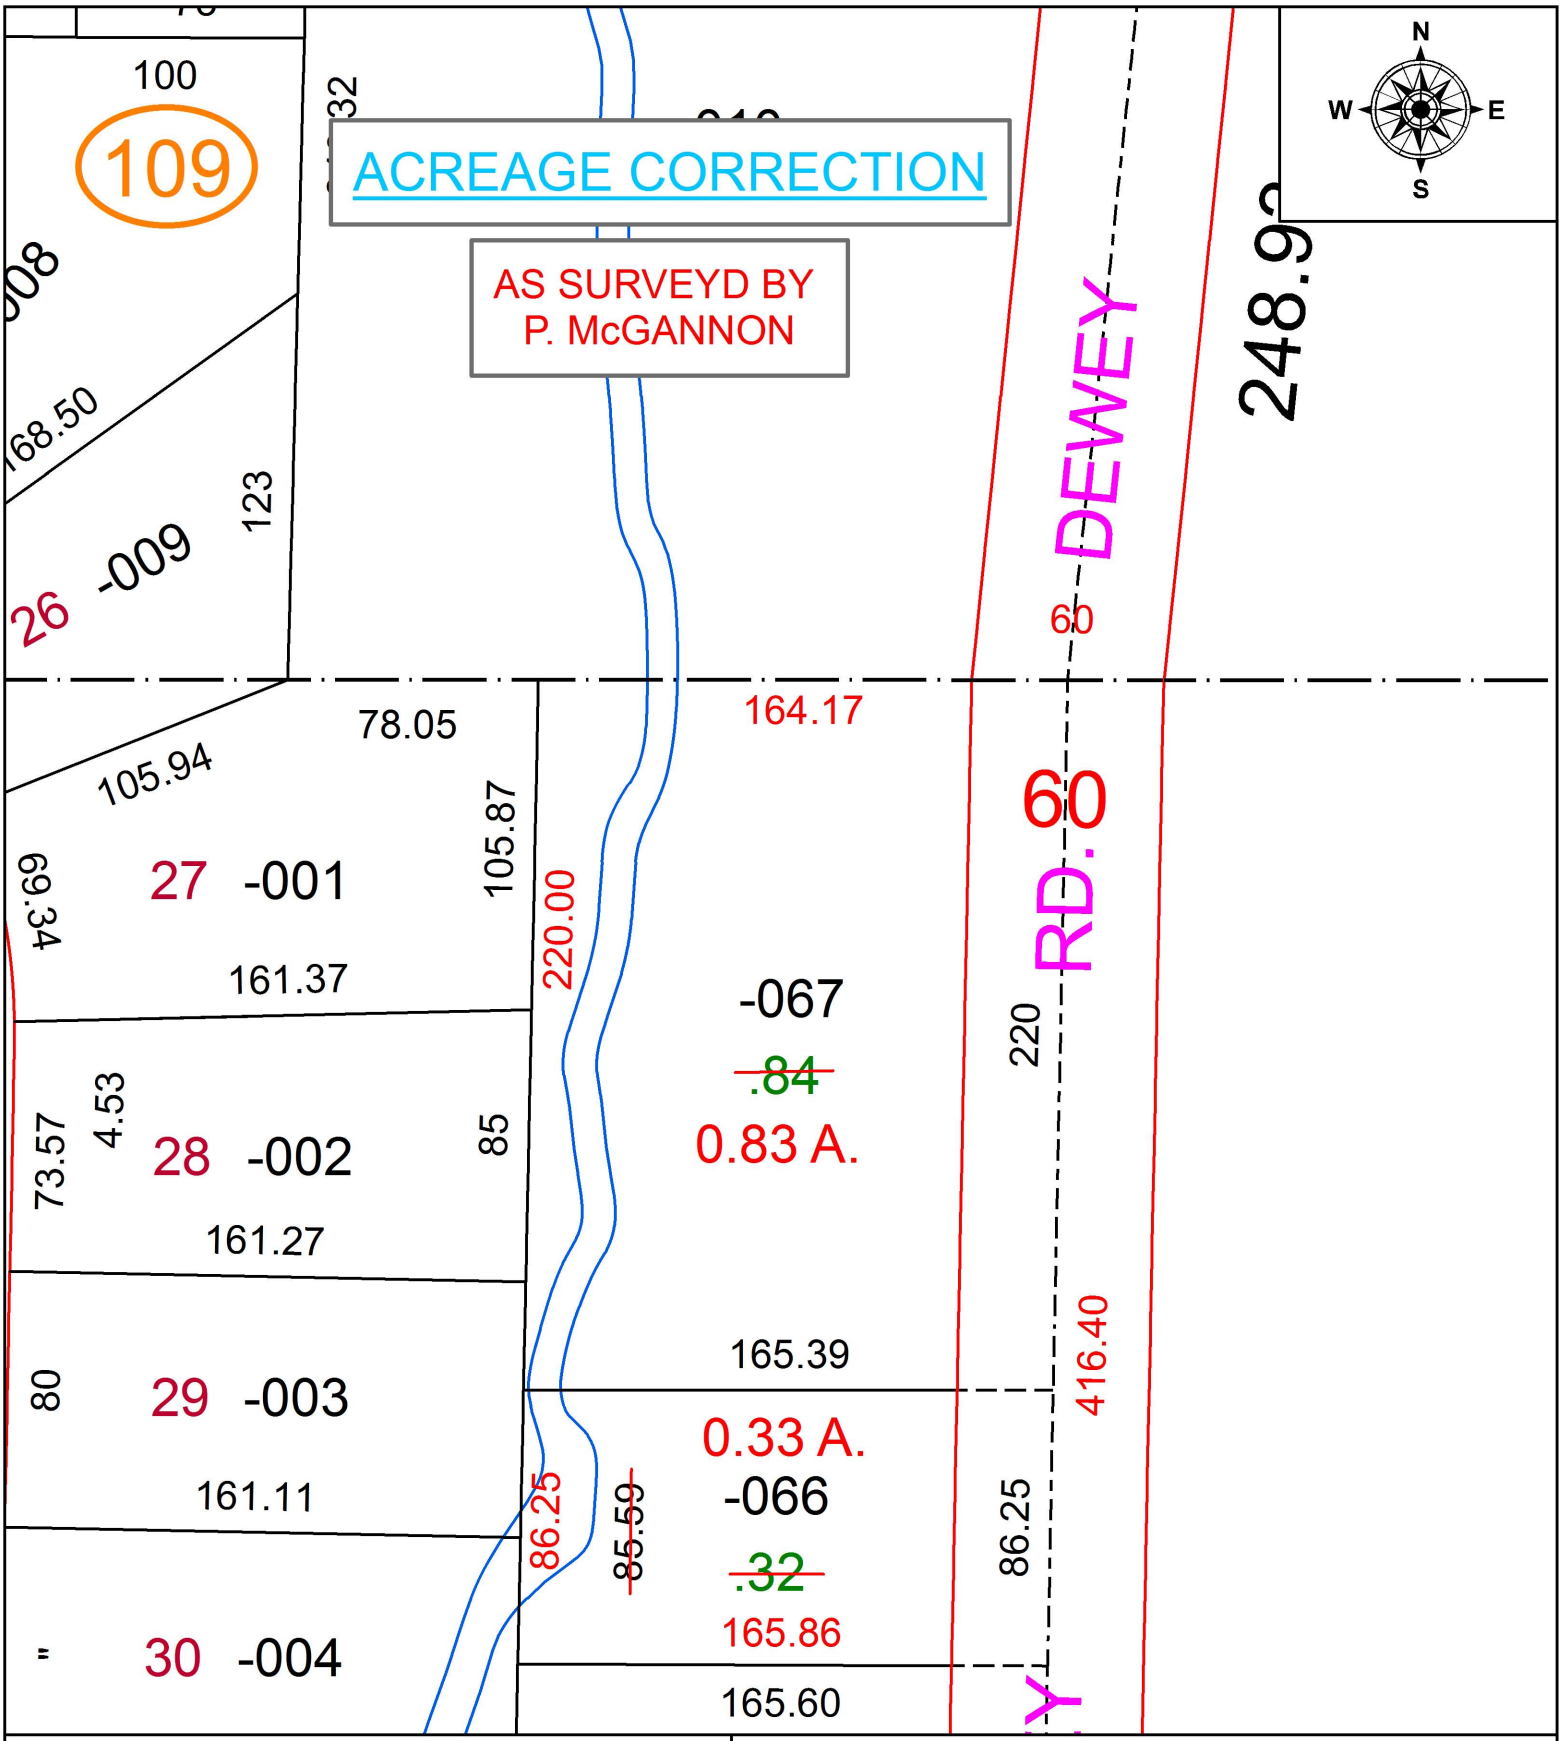

SPLITS/DEEDS PROCESSED

LORAIN COUNTY TAX MAP DEPARTMENT
226 MIDDLE AVE. ELYRIA, OH

SURVEYED BY: PATRICK A McGANNON
CLOSURE: 1: 470,000
MAP PAGE(S): 05-00-042
APPOVED BY: TJS **DATE:** 7/12/16
SCALE: 1" = 60 **PRIOR INSTRUMENT:** DV 1144/343