PARENT PARCEL: 04-00-026-109-101

CHILD PARCEL: 04-00-026-109-304, -305, -306, -307, -308

STARTING POINT: CENTERLINE OF STREAM VIEW DR & LEAR NAGEL RD

16-03482

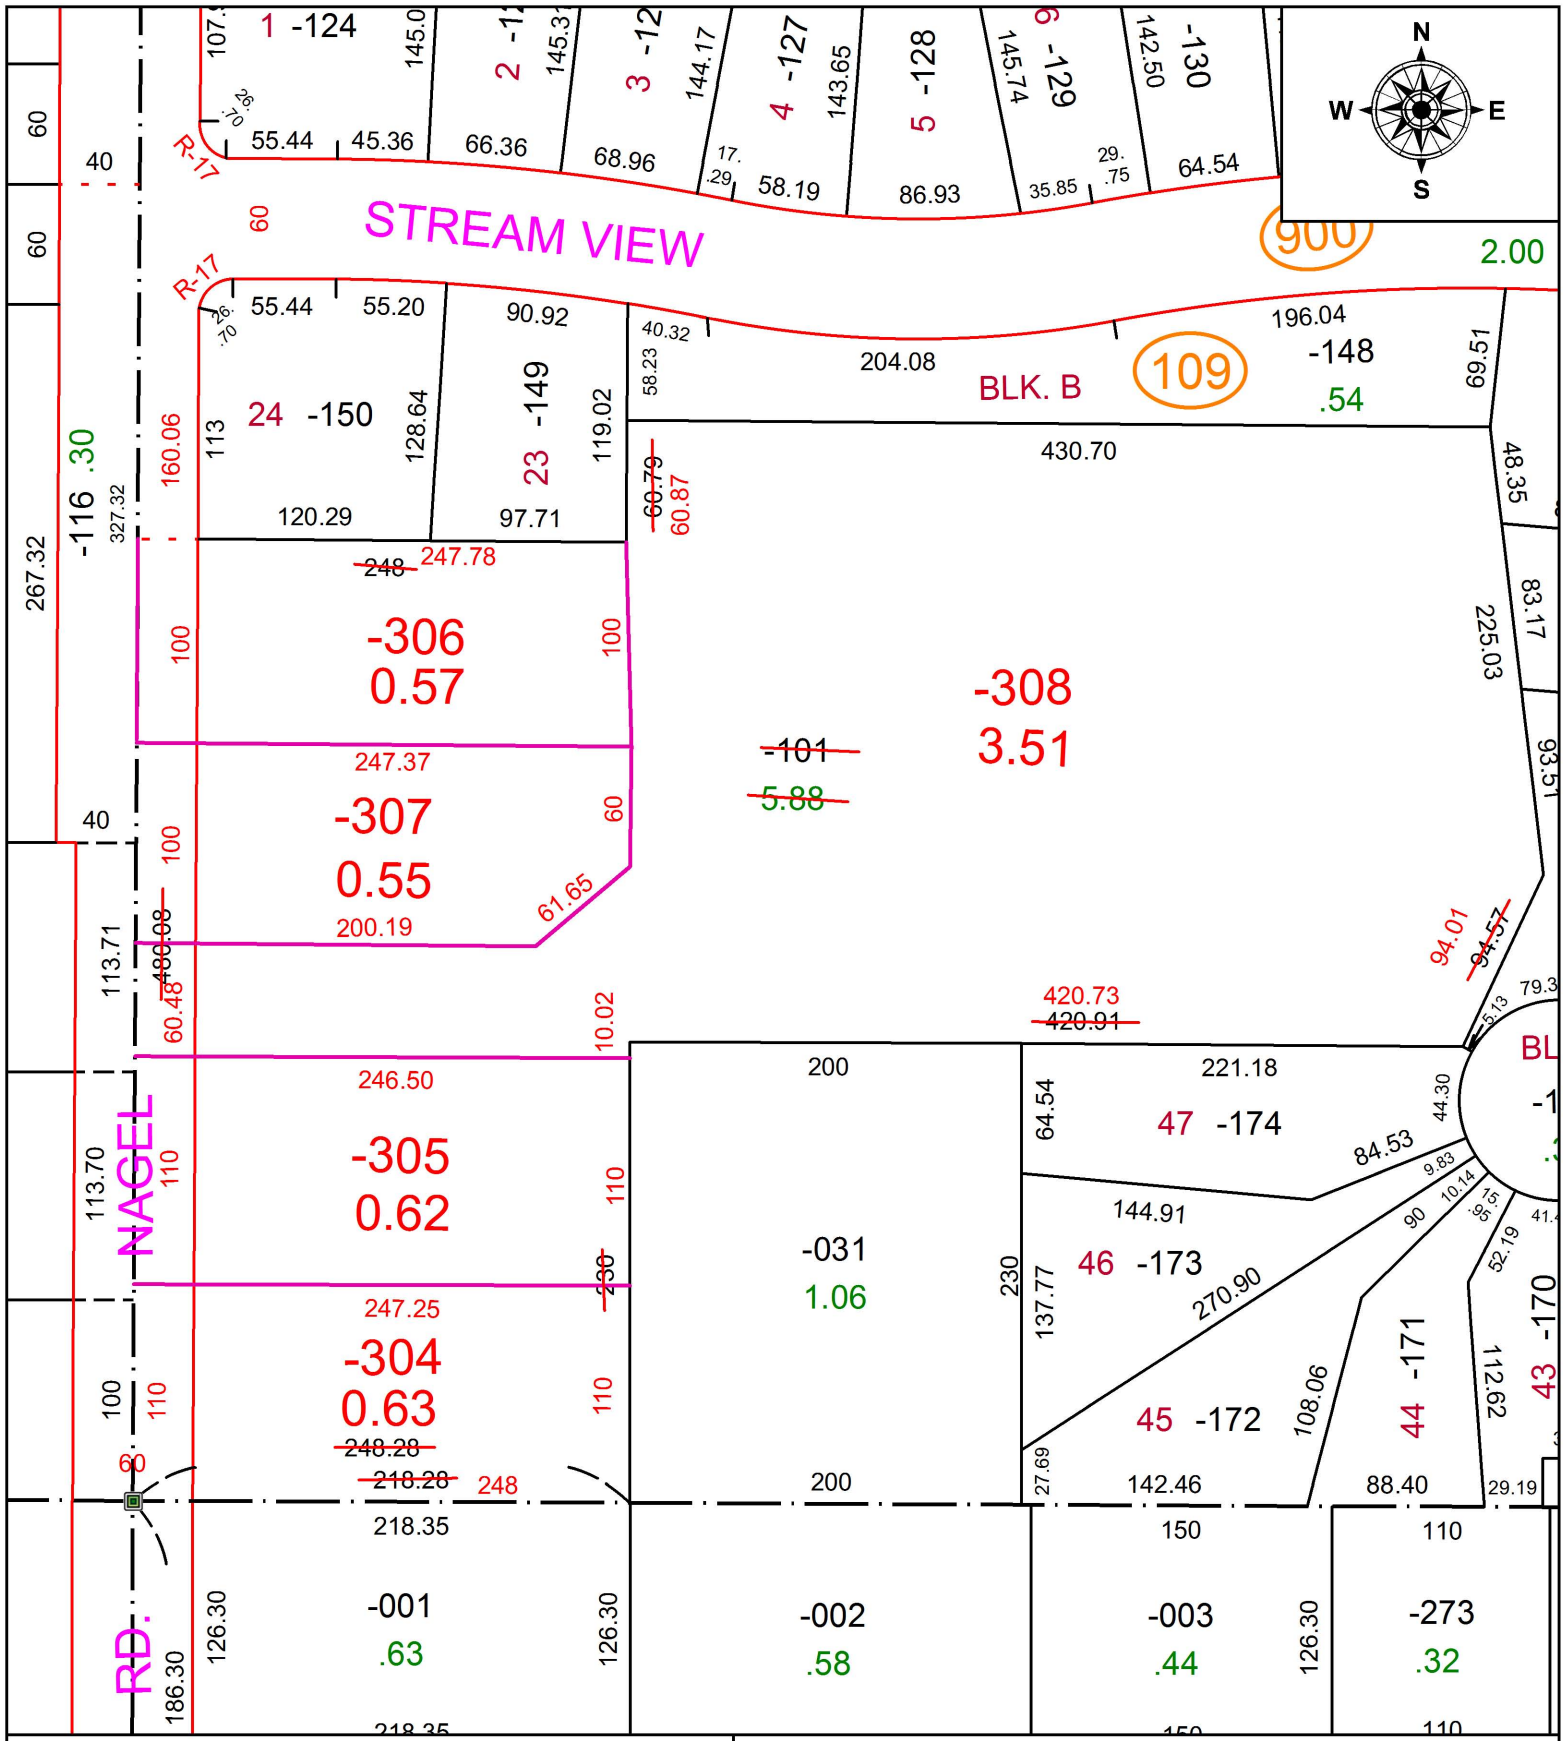

SPLITS/DEEDS PROCESSED

LORAIN COUNTY TAX MAP DEPARTMENT
226 MIDDLE AVE. ELYRIA, OH

SURVEYED BY: AMY KELLY
CLOSURE: 1:442508
MAP PAGE(S): 04-00-026
APPOVED BY: JAH **DATE:** 2/22/2016
SCALE: 1 in = 96 ft **PRIOR INSTRUMENT:** 2002-0853077