PARENT PARCEL: 05-00-022-115-001
CHILD PARCEL: XX-XX-XXX-XXX-XXX
STARTING POINT: CL OF LINCOLD ST. & CL OF BRANDT ST.

16-03484-D

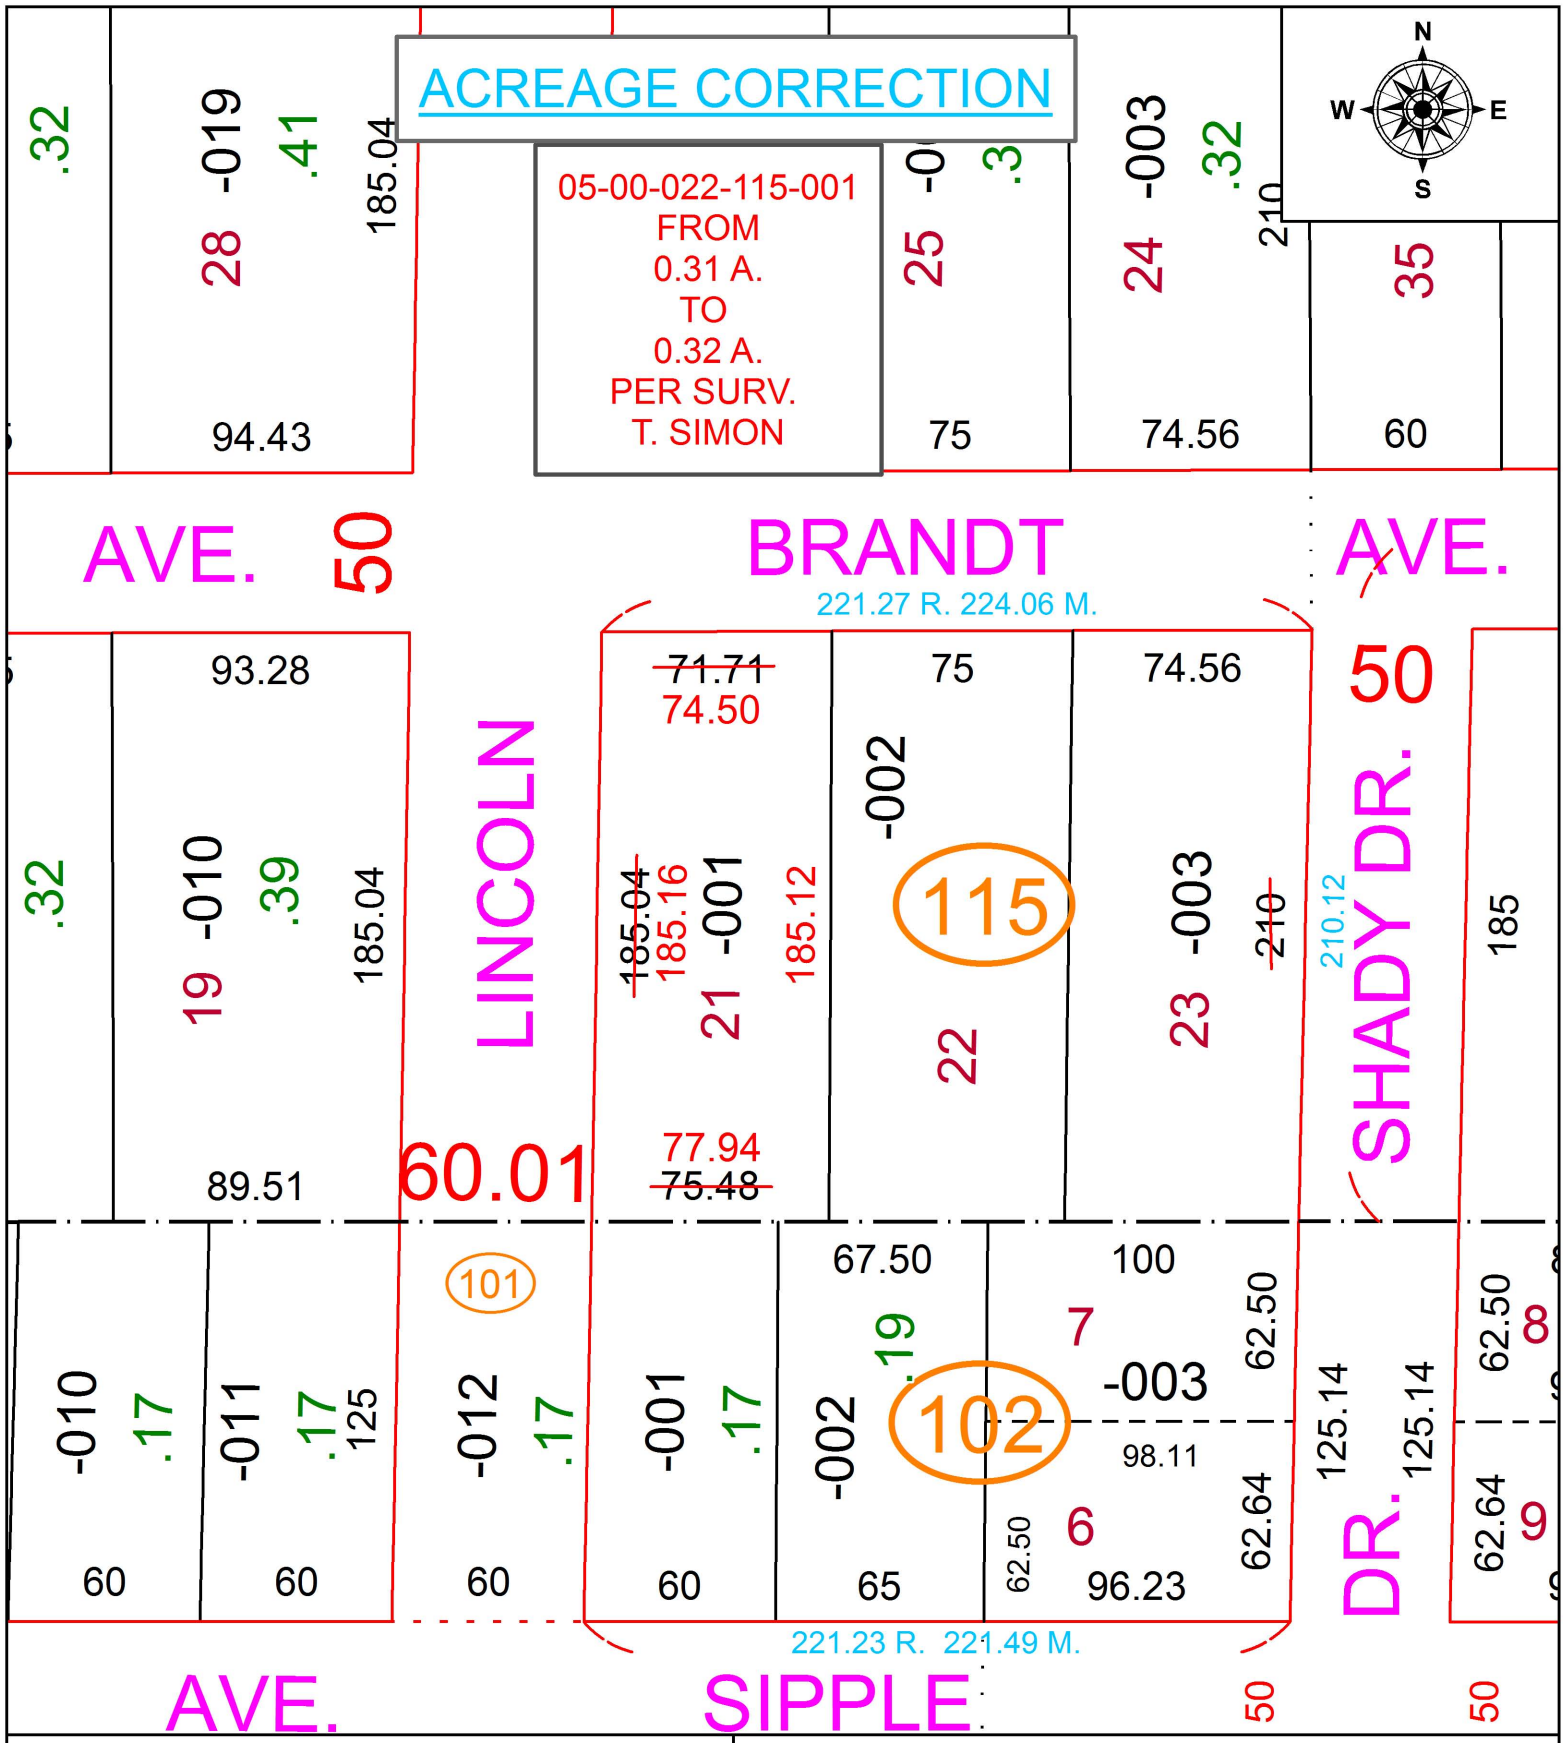

SPLITS/DEEDS PROCESSED
LORAIN COUNTY TAX MAP DEPARTMENT
226 MIDDLE AVE. ELYRIA, OH

SURVEYED BY: THOMAS SIMON
CLOSURE: 1: 33,000
MAP PAGE(S): 05-00-022
APPOVED BY: TJS **DATE:** 7/11/16
SCALE: 1" = 60 **PRIOR INSTRUMENT:** 2013-0481318