PARENT PARCEL: 10-00-004-139-009
CHILD PARCEL: XX-XX-XXX-XXX-XXX
STARTING POINT: INTERSECTION OF C/L OF FULLER RD. AND C/L OF EAST RIVER RD.

16-03489-D

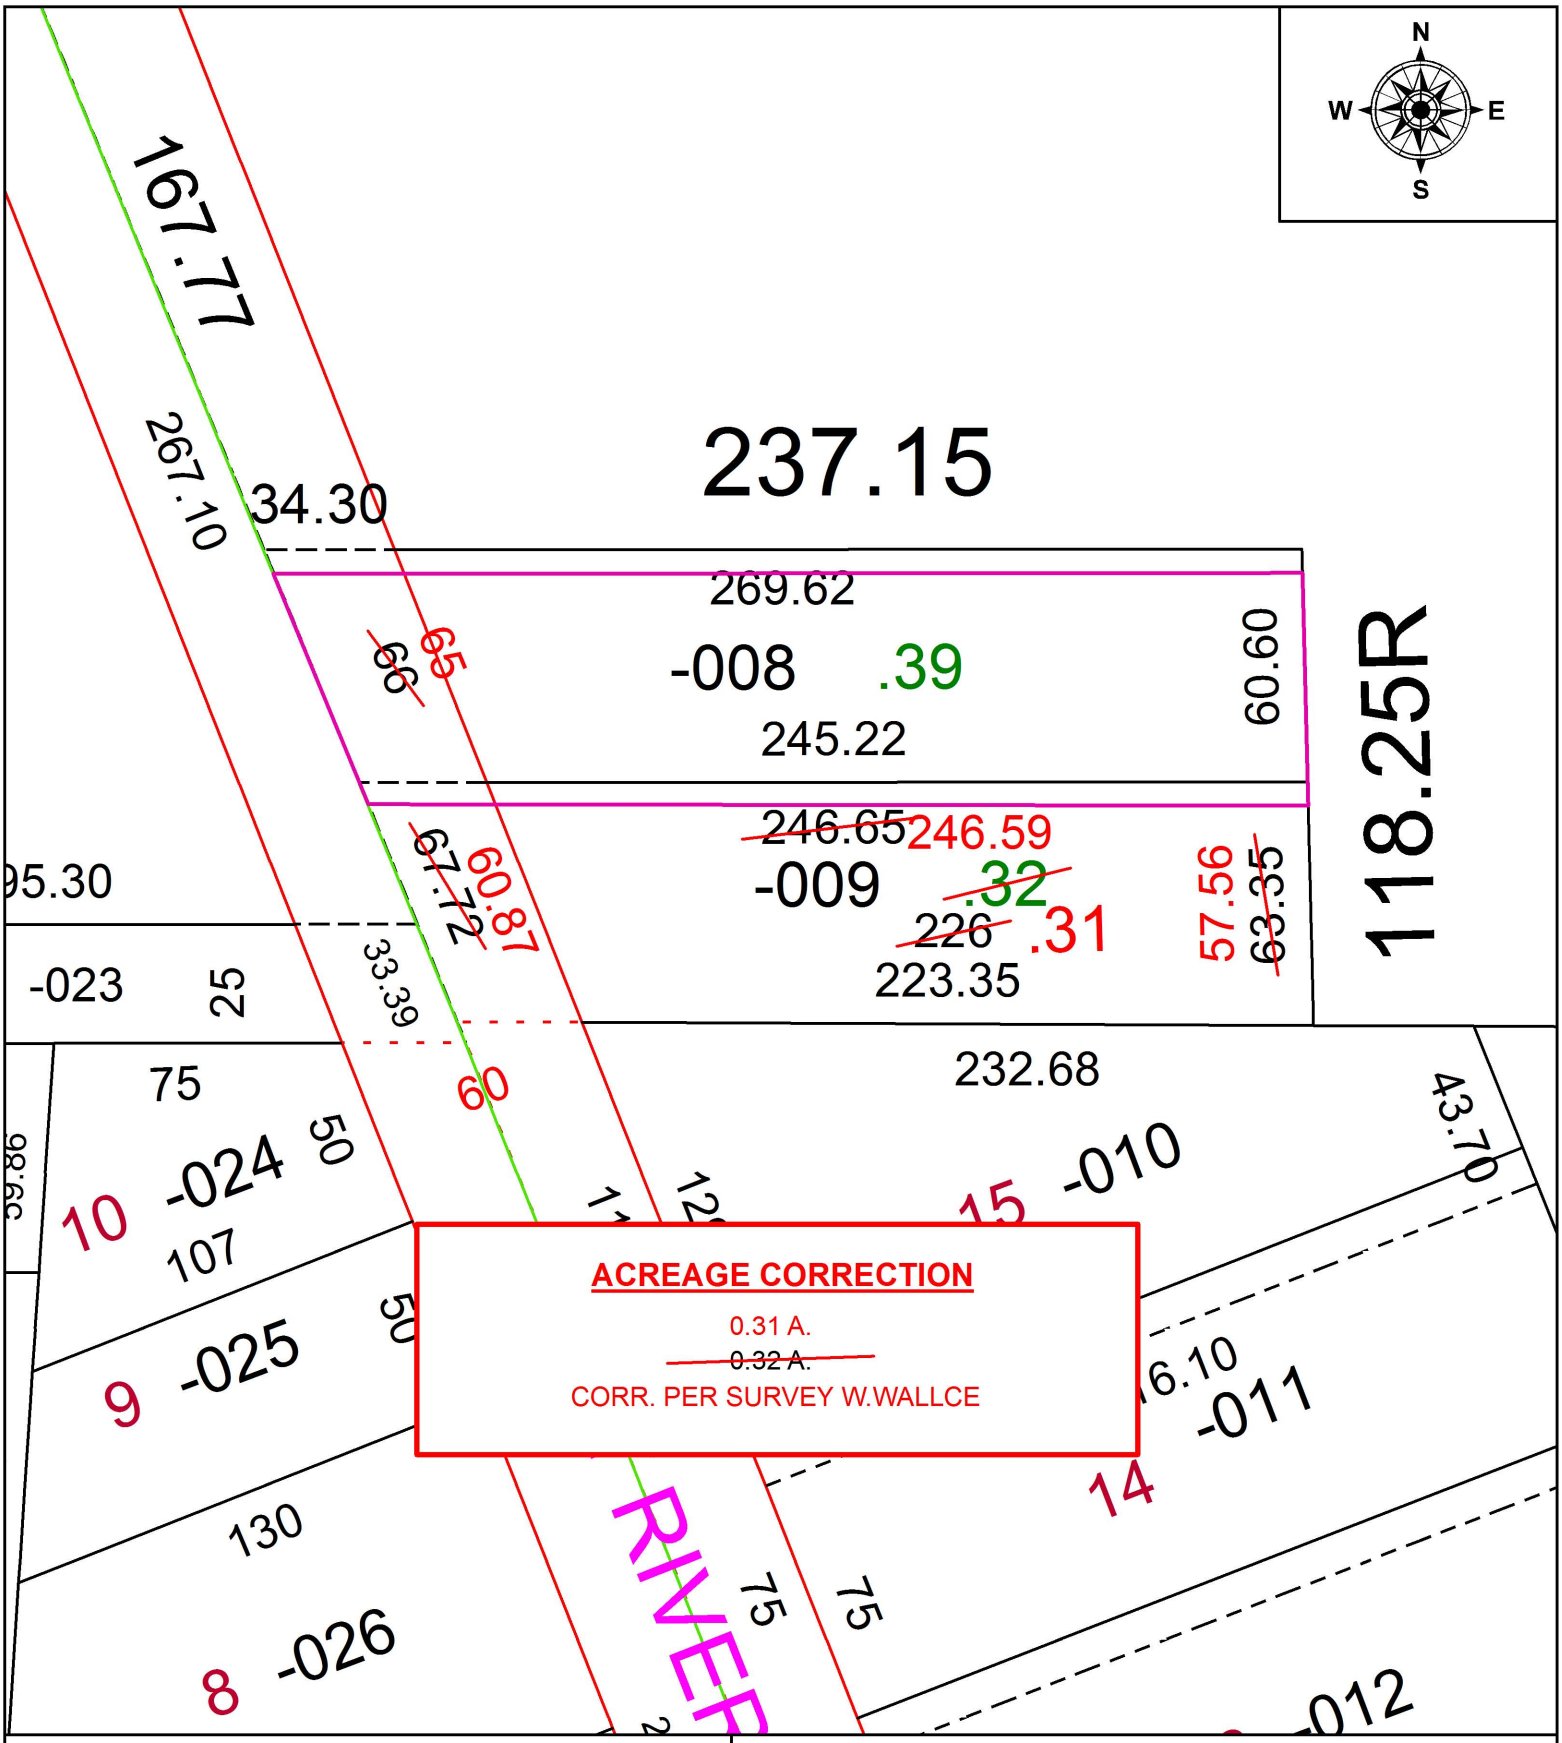

ACREAGE CORRECTION

0.31 A.
~~0.32 A.~~
CORR. PER SURVEY W.WALLCE

SPLITS/DEEDS PROCESSED
LORAIN COUNTY TAX MAP DEPARTMENT
226 MIDDLE AVE. ELYRIA, OH

SURVEYED BY: WILLIAM R. WALLACE
CLOSURE: 1: 577,638
MAP PAGE(S): 10-00-004
APPOVED BY: RRM **DATE:** 7-28-16
SCALE: 1" = 50 **PRIOR INSTRUMENT:** 20000686141