**PARENT PARCEL:** ADD TO DUP

**CHILD PARCEL:** 06-21-001-101-066

**STARTING POINT:** CENTERLINES OF OLD WEST RIDGE RD & MIDDLE RIDGE RD

# 16-03490-X

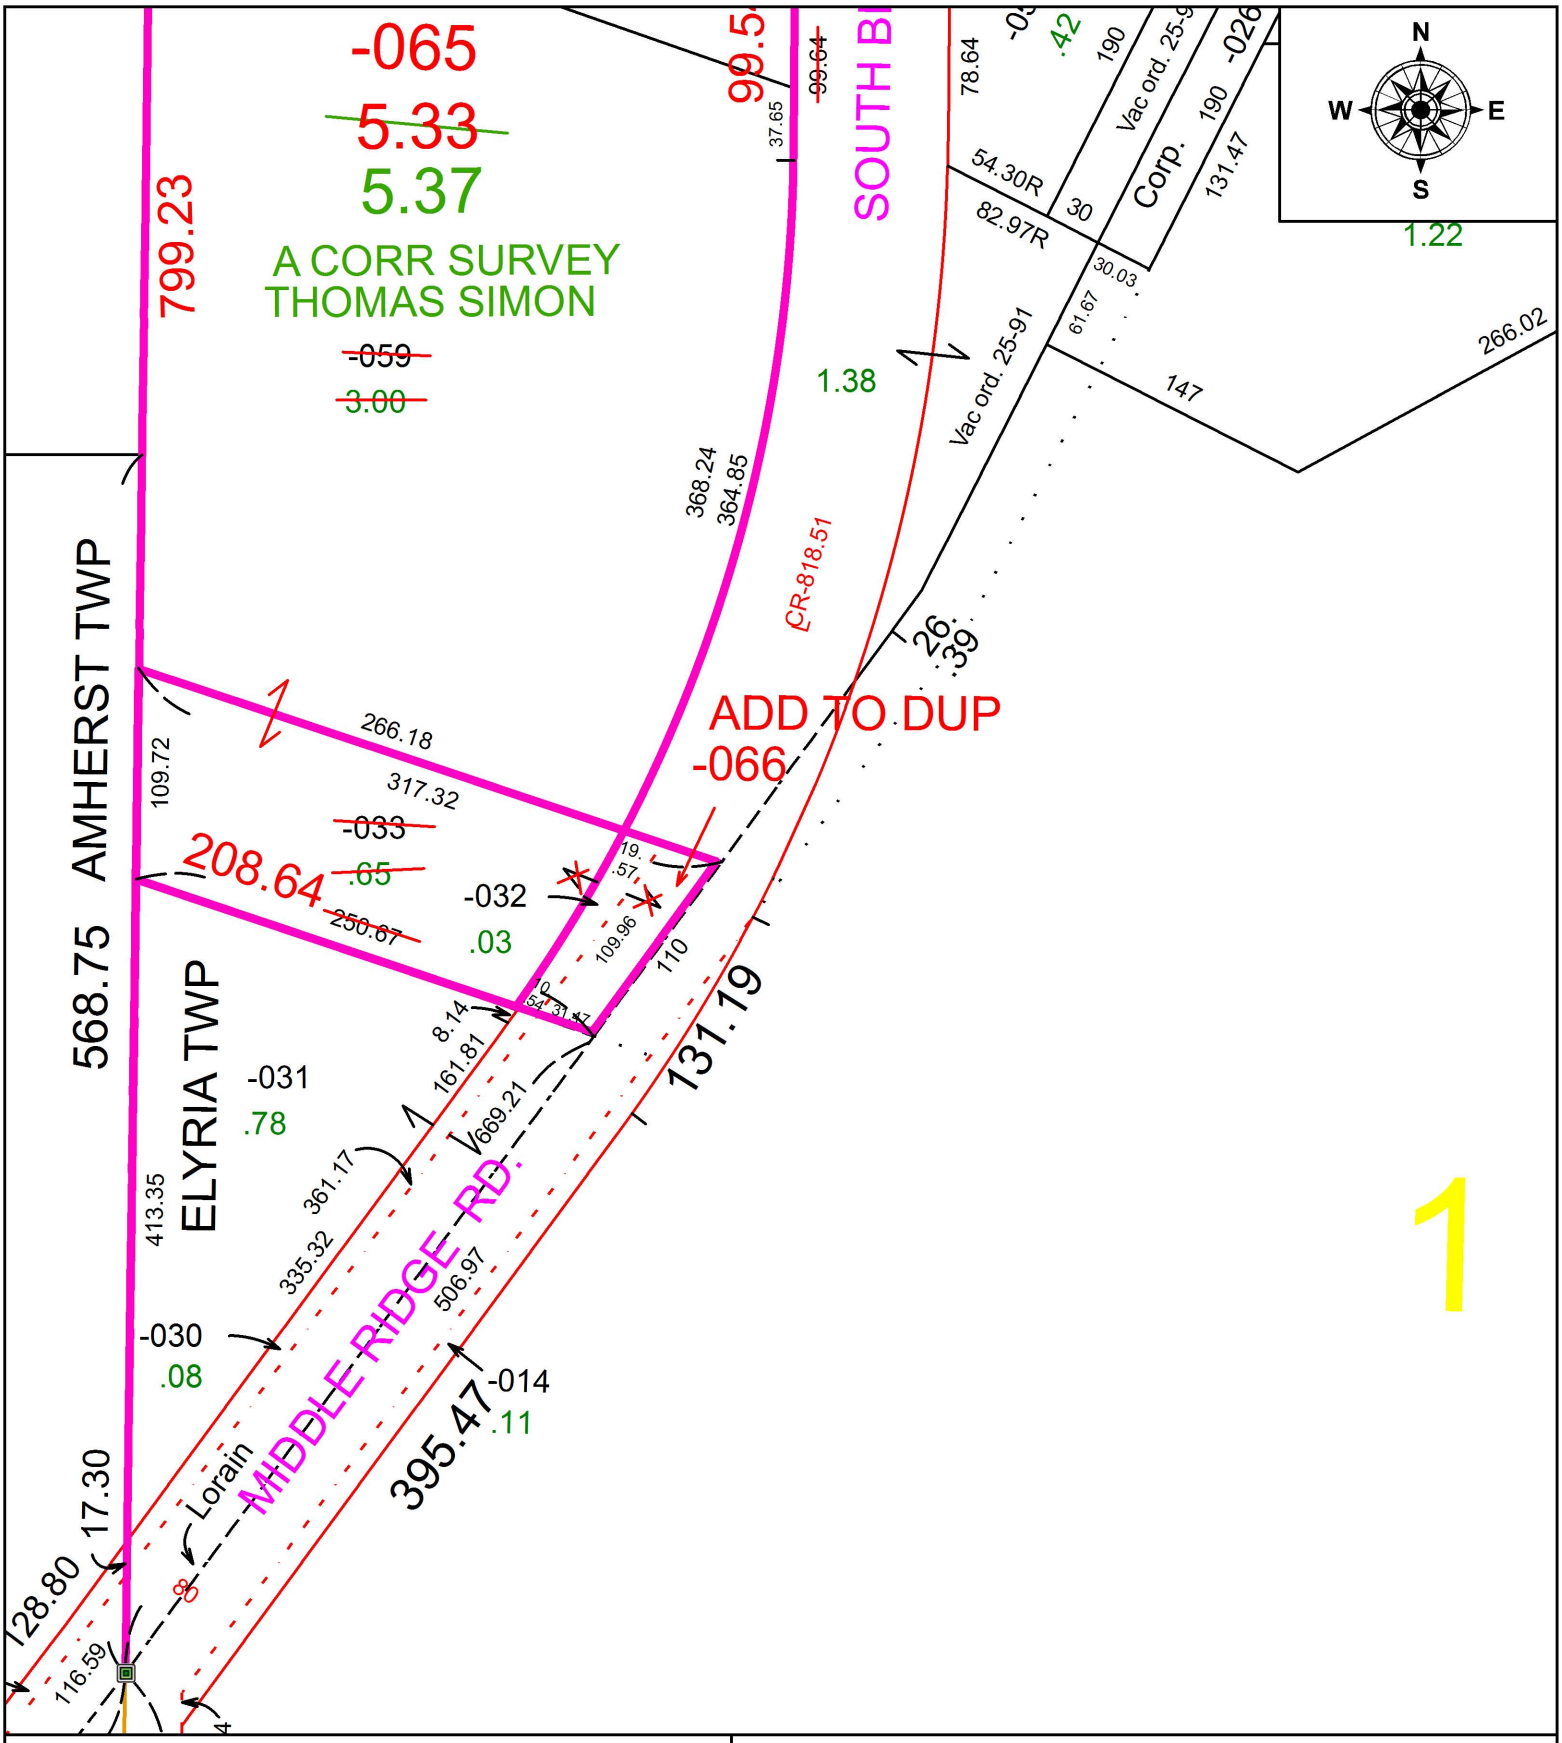


**SPLITS/DEEDS PROCESSED**

LORAIN COUNTY TAX MAP DEPARTMENT
226 MIDDLE AVE. ELYRIA, OH

**SURVEYED BY:** THOMAS SIMON
**CLOSURE:** 1:347458
**MAP PAGE(S):** 6-21
**APPOVED BY:** JAH **DATE:** 7/28/2016
**SCALE:** 1 in = 100 ft **PRIOR INSTRUMENT:** 20060178428