PARENT PARCEL: 07-00-027-102-010, -012, 07-00-028-103-098

CHILD PARCEL: 07-00-027-102-010, -012, -015, -016, 07-00-028-103-195, -196

STARTING POINT: INTERSECTION OF NORTH LINE OF AURENSEN RD. AND WEST LINE OF NOLL DR.

16-03495

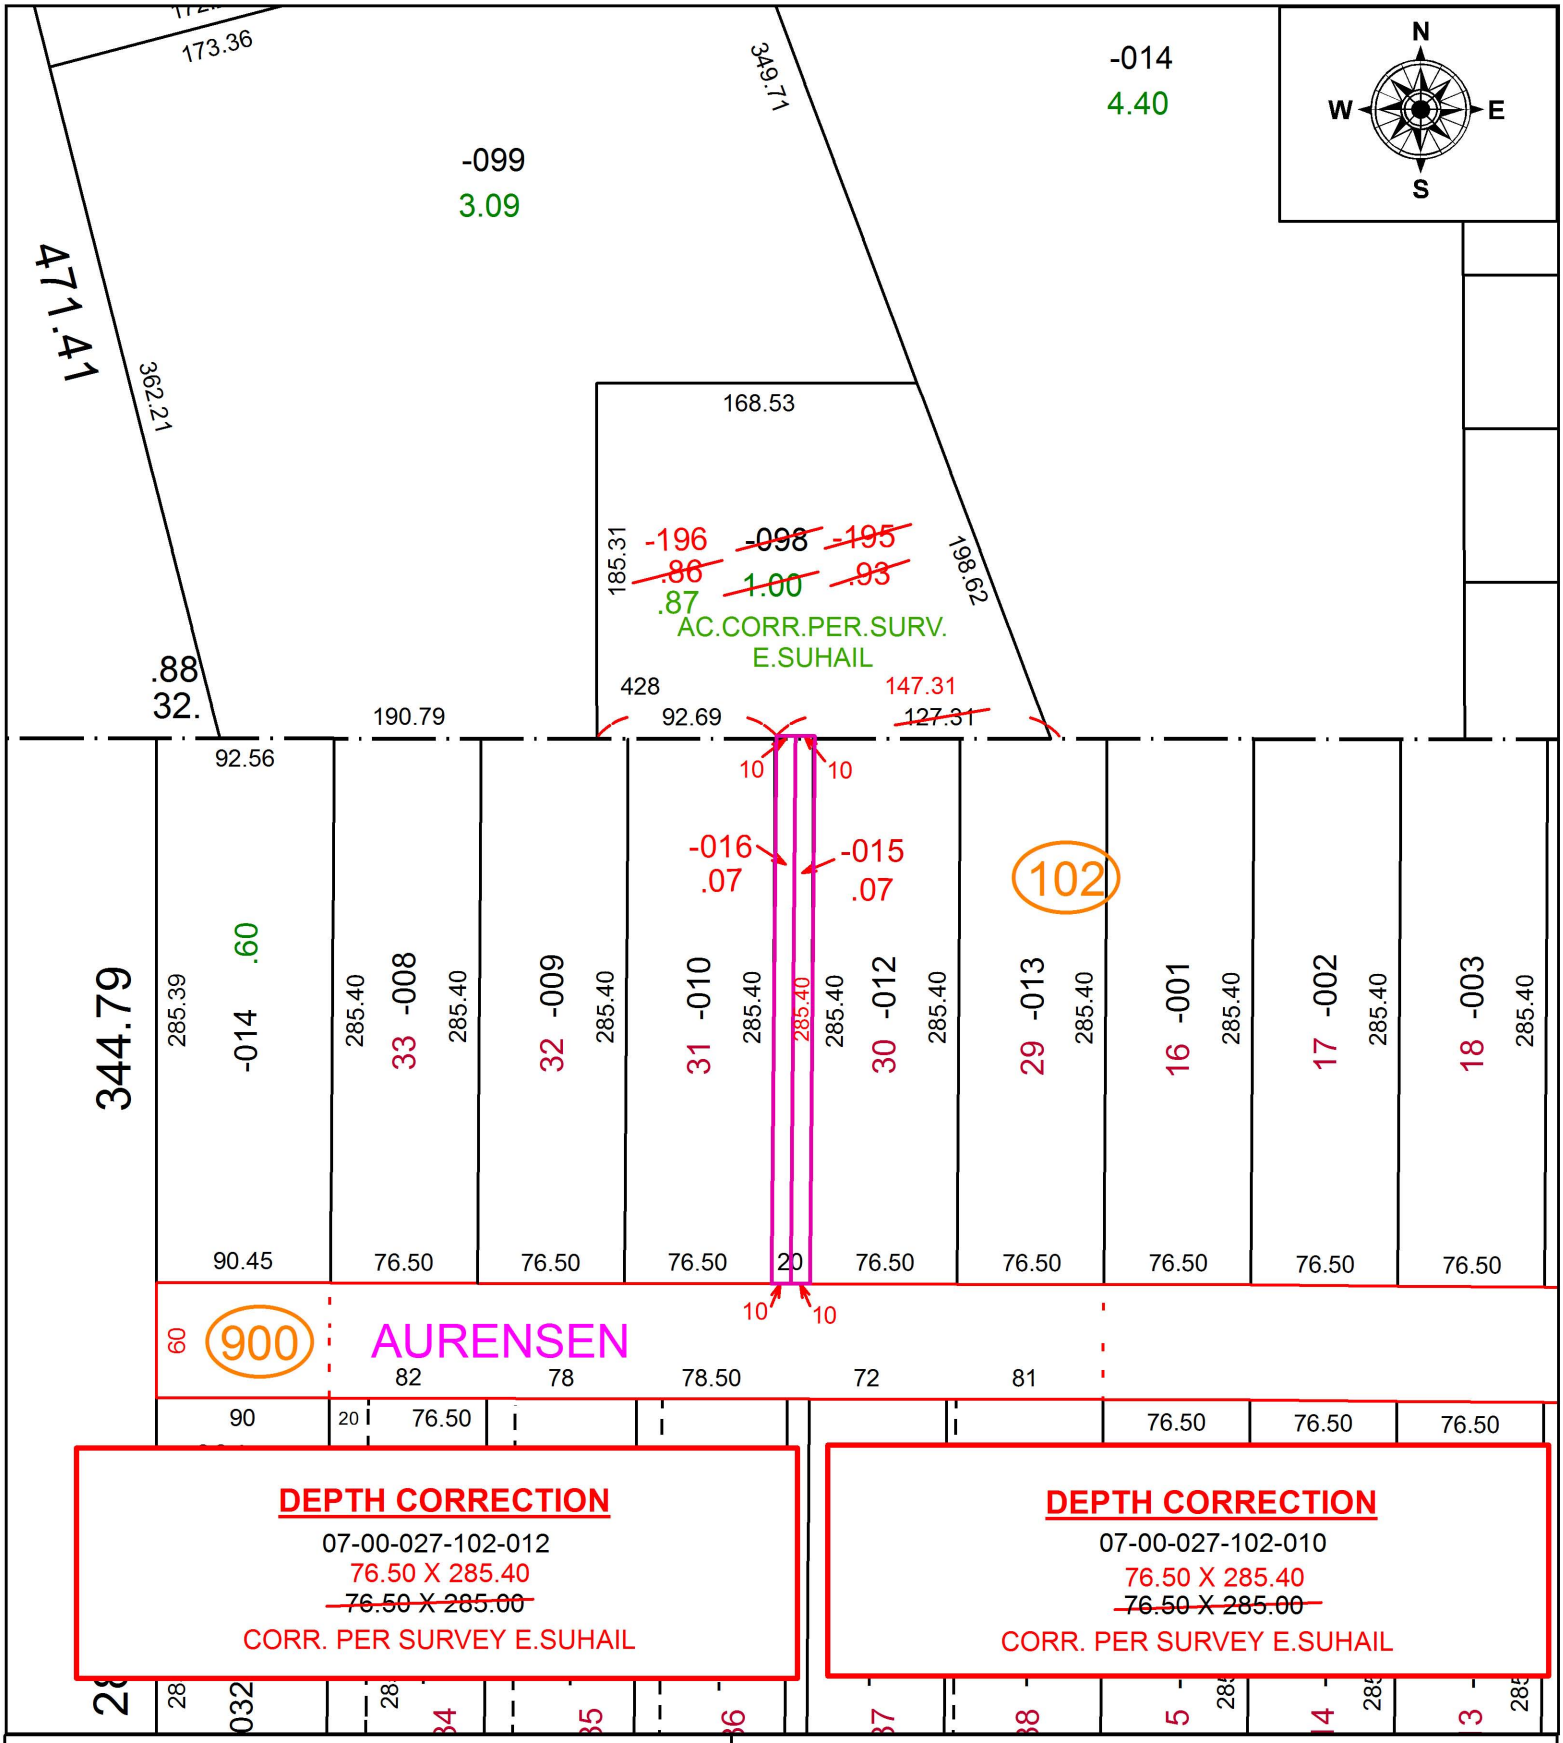

SPLITS/DEEDS PROCESSED

LORAIN COUNTY TAX MAP DEPARTMENT
226 MIDDLE AVE. ELYRIA, OH

SURVEYED BY: EHTESHAM M. SUHAIL
CLOSURE: 1: 130,771
MAP PAGE(S): 7-00-028
APPOVED BY: RRM **DATE:** 3-23-16
SCALE: 1" = 100 **PRIOR INSTRUMENT:** 20150570802