PARENT PARCEL: 19-04-034-000-003 & 19-04-011-000-042

CHILD PARCEL:

STARTING POINT: INT INDIAN HOLLOW ROAD AND N LINE OF O.L.9

16-03496-C

ACREAGE CORRECTION

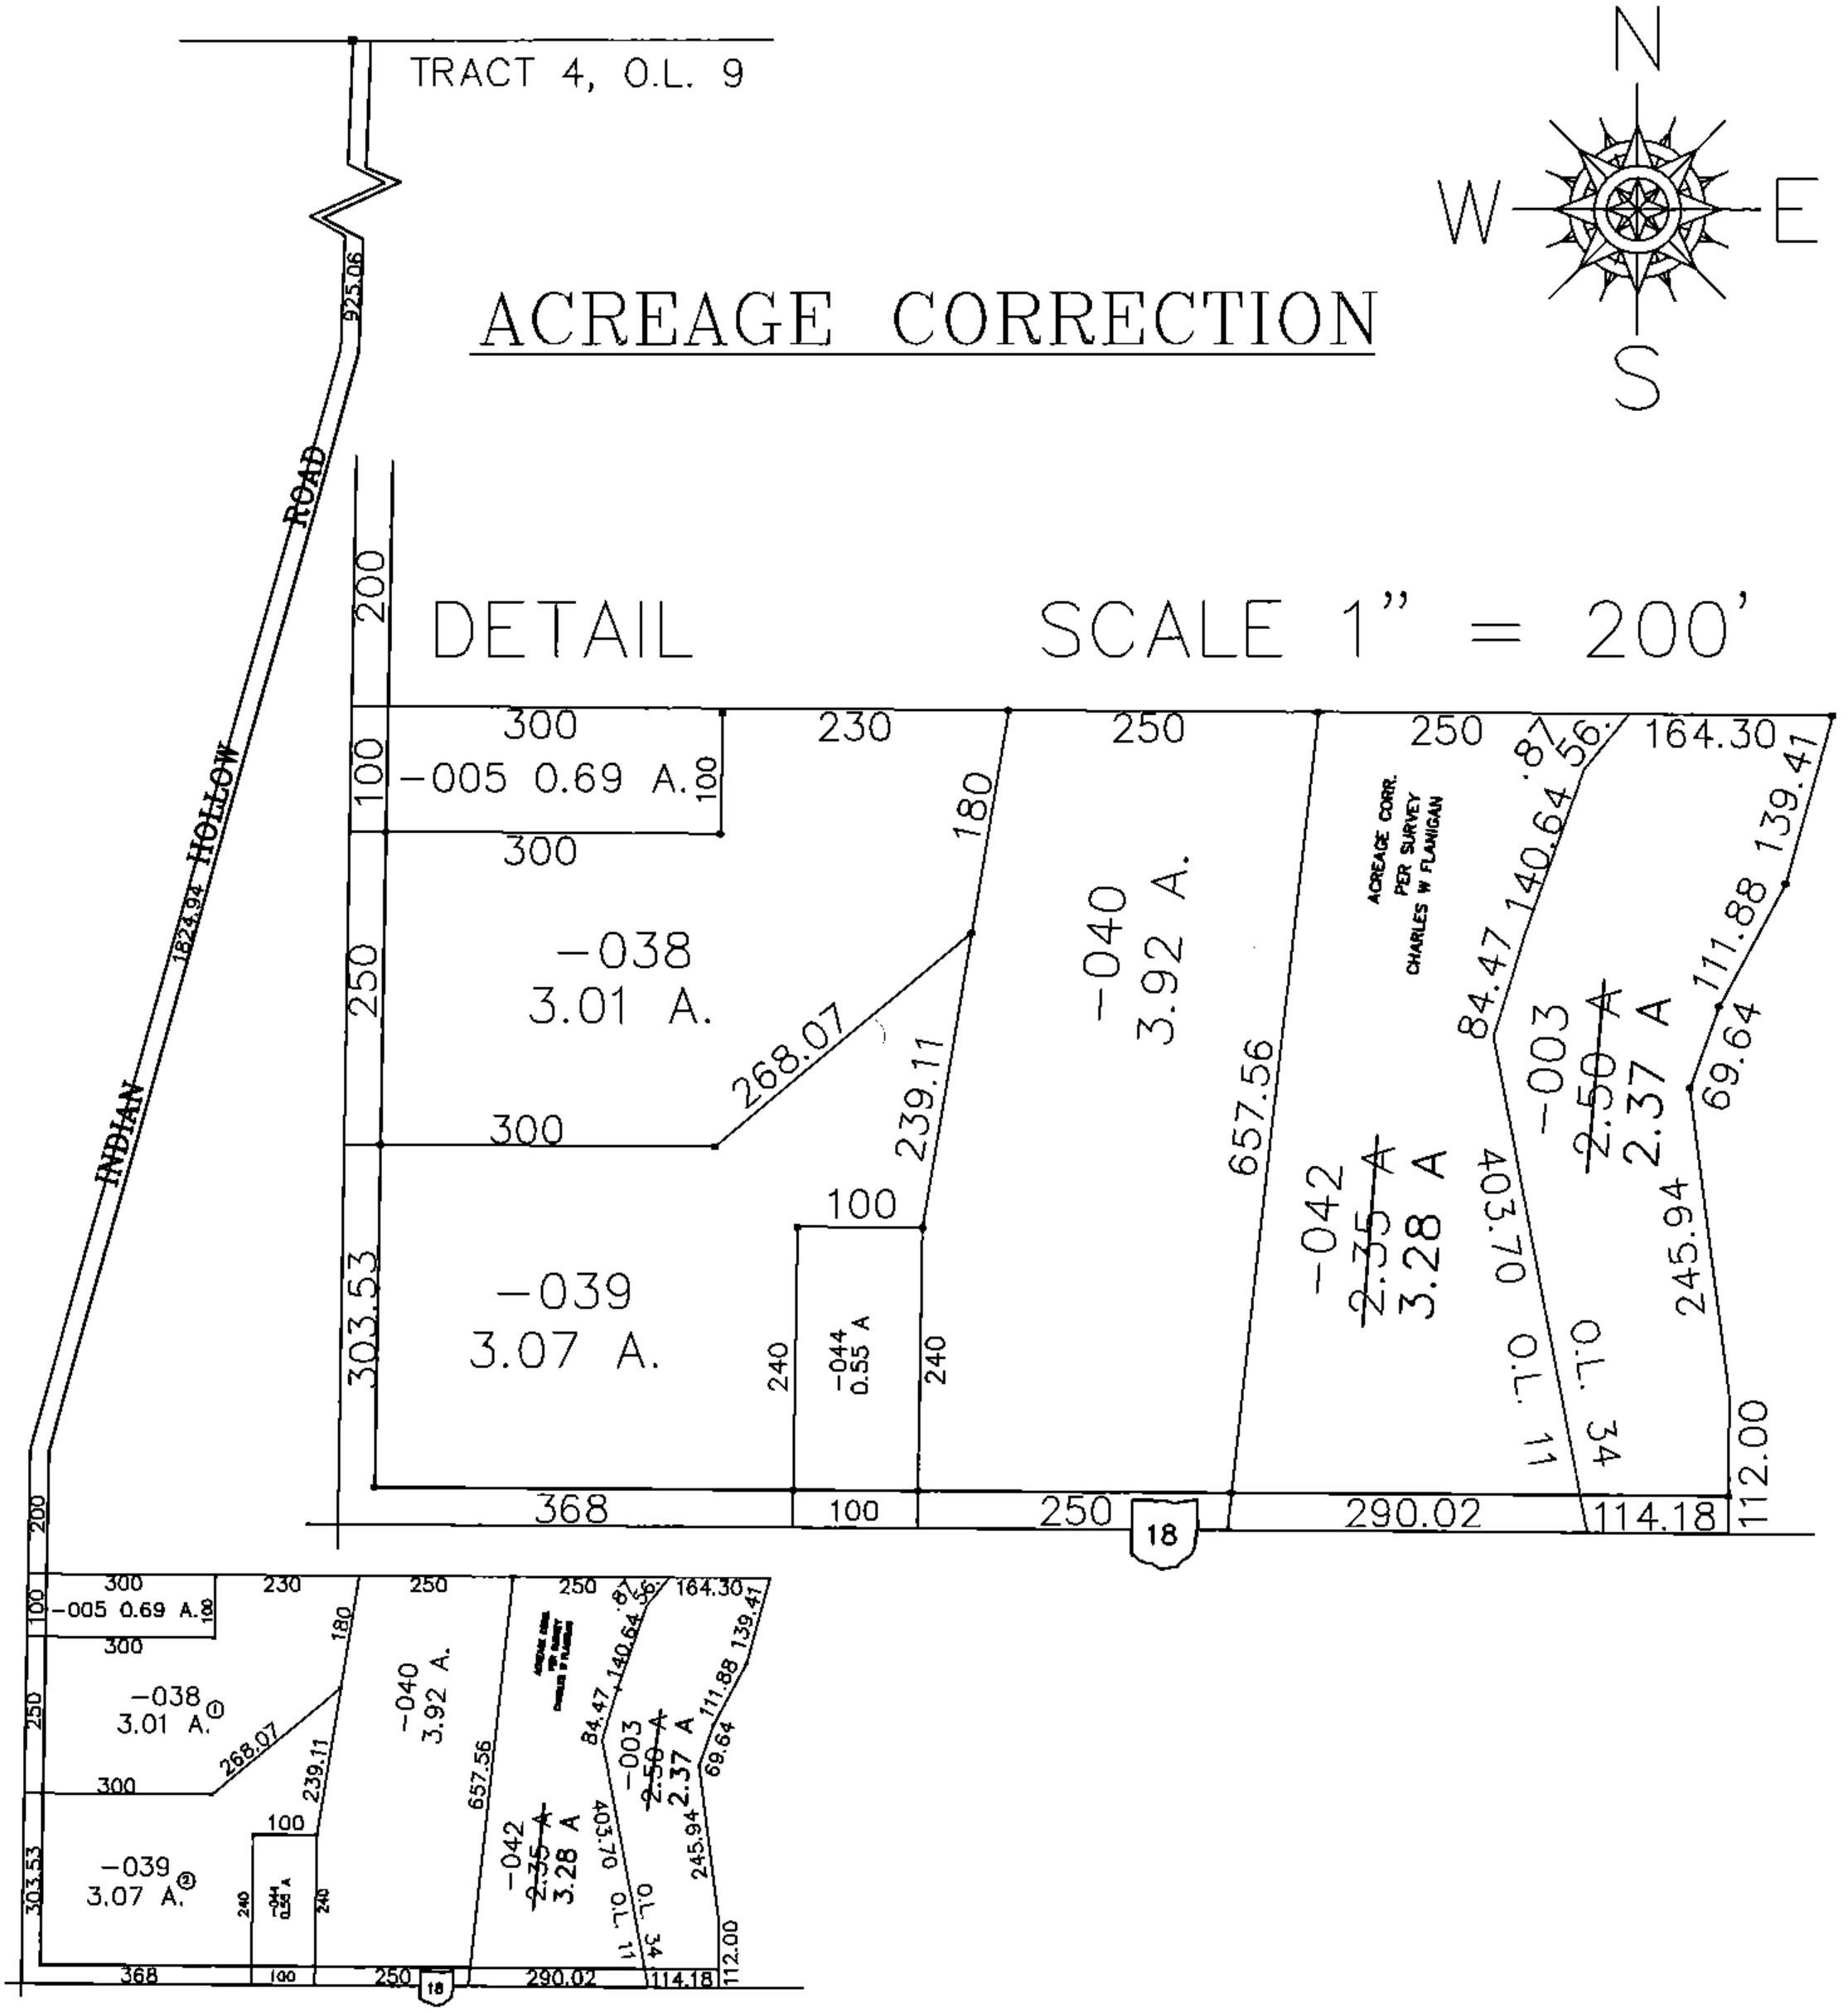

SPLITS/DEEDS PROCESSED

LORAIN COUNTY TAX MAP DEPARTMENT
226 MIDDLE AVE. ELYRIA, OHIO

SURVEYED BY: CHARLES W. FLANIGAN

CLOSURE: 0.02 : 10,000

MAP PAGE(S): 19-C

APPROVED BY: DRH DATE: 8/17/16

SCALE: 1"= 400 PRIOR INSTRUMENT: OR 1192/561