PARENT PARCEL: 03-00-018-000-007

CHILD PARCEL: XX-XX-XXX-XXX-XXX

STARTING POINT: SOUTHWEST CORNER OF O.L.8

16-03497-D

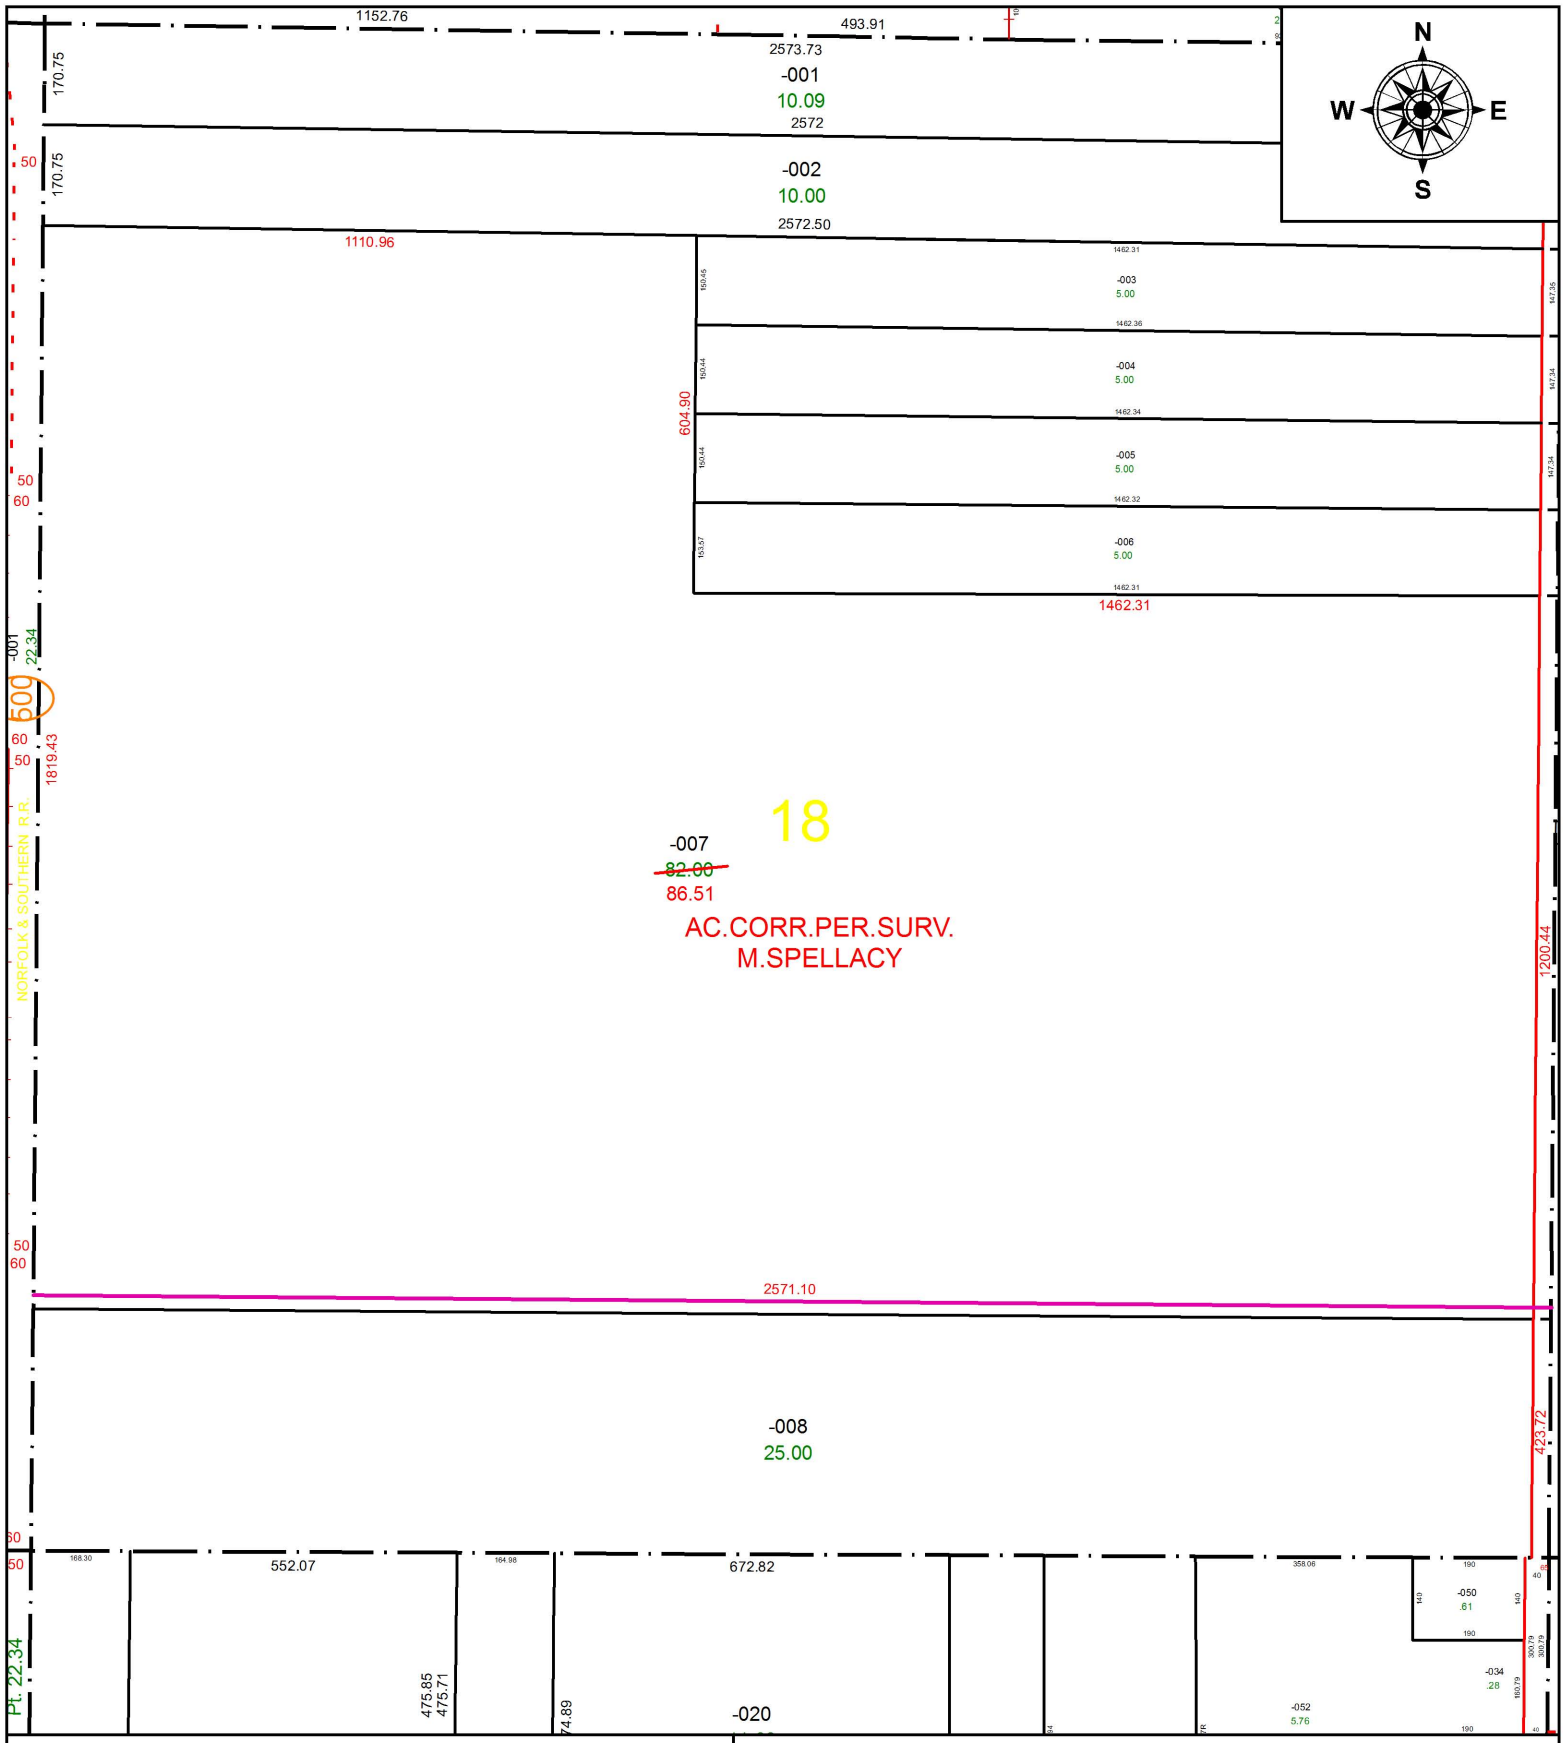

SPLITS/DEEDS PROCESSED

LORAIN COUNTY TAX MAP DEPARTMENT
226 MIDDLE AVE. ELYRIA, OH

SURVEYED BY: MICHAEL P. SPELLACY
CLOSURE: 1: 1,130,088
MAP PAGE(S): 3-00-018
APPOVED BY: RRM **DATE:** 8-18-16
SCALE: 1" = 325 **PRIOR INSTRUMENT:** 20150549558