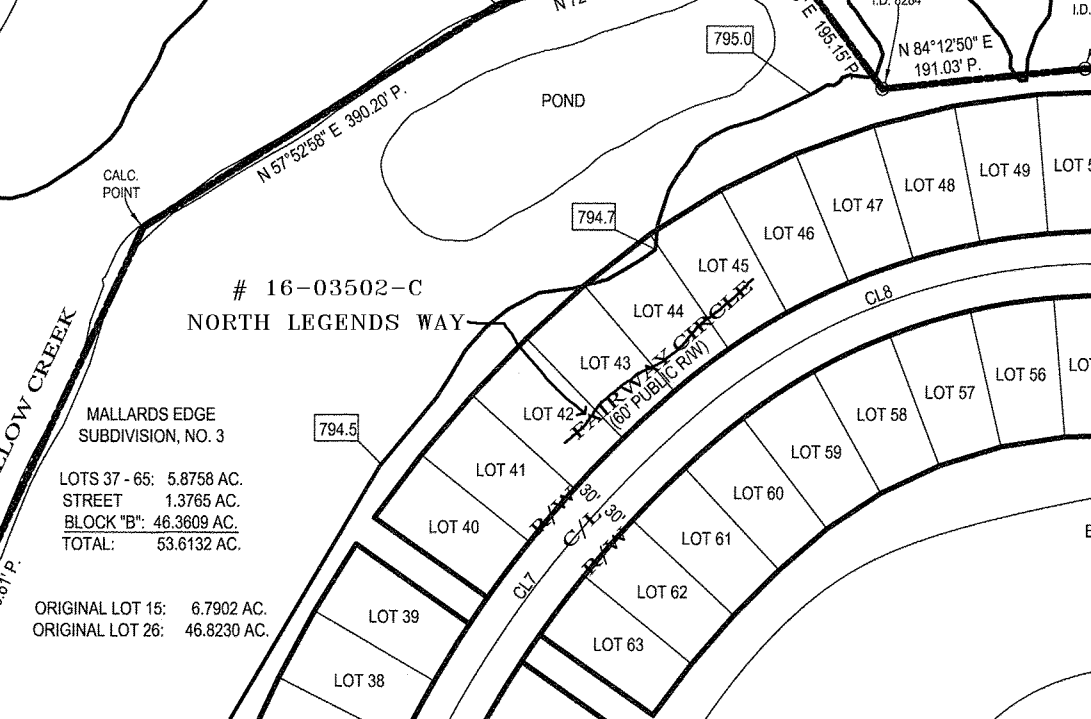
16-03502-C
NORTH LEGENDS WAY
MALLARDS EDGE
SUBDIVISION, NO. 3
LOTS 37 - 65: 5.8758 AC.
STREET 1.3765 AC.
BLOCK "B": 46.3609 AC.
TOTAL: 53.6132 AC.
ORIGINAL LOT 15: 6.7902 AC.
ORIGINAL LOT 26: 46.8230 AC.
POND
CALC. POINT
N 57°52'58" E 390.20' P.
N 84°12'50" E
191.03' P.
795.0
794.7
794.5
LOT 38
LOT 39
LOT 40
LOT 41
LOT 42
LOT 43
LOT 44
LOT 45
LOT 46
LOT 47
LOT 48
LOT 49
LOT 56
LOT 57
LOT 58
LOT 59
LOT 60
LOT 61
LOT 62
LOT 63
CL7
CL8
C/L 30'
P/W
FAIRWAY CIRCLE
(60' PUBLIC R/W)