PARENT PARCEL: 14-00-046-000-002
CHILD PARCEL: 14-00-046-000-015, -016
STARTING POINT: CENTERLINE OF ST RT 58 & HUGHES RD

16-03503

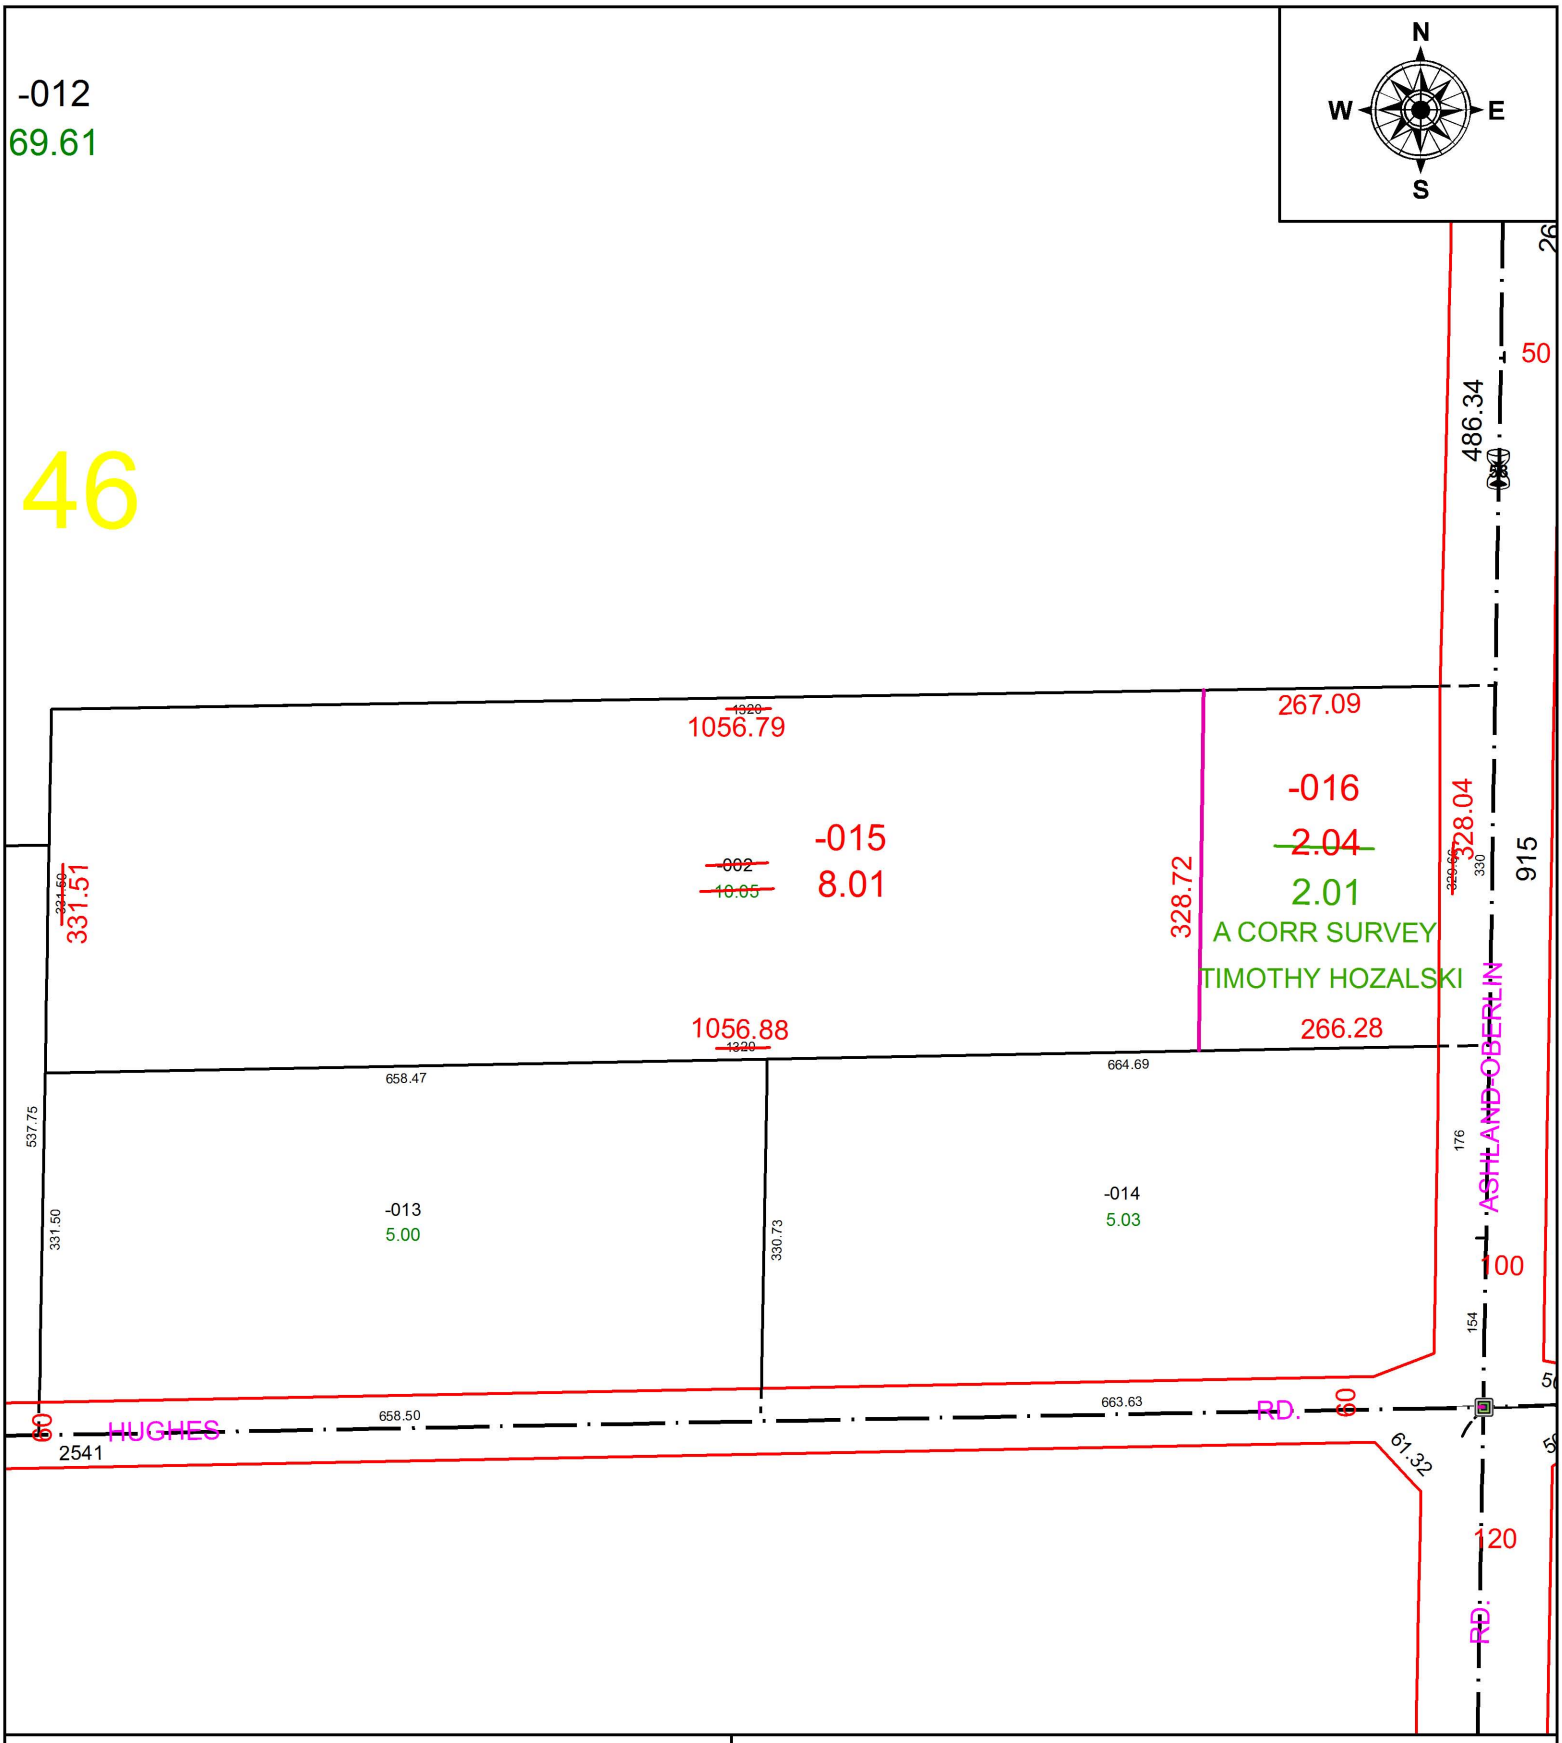

SPLITS/DEEDS PROCESSED
LORAIN COUNTY TAX MAP DEPARTMENT
226 MIDDLE AVE. ELYRIA, OH

SURVEYED BY: TIMOTHY HOZALSKI
CLOSURE: 1:588323
MAP PAGE(S): 14-B
APPOVED BY: JAH **DATE:** 4/5/2016
SCALE: 1 in = 175 ft **PRIOR INSTRUMENT:** 20010744977