PARENT PARCEL: 05-00-034-000-021

CHILD PARCEL: 05-00-034-000-031 & -032

STARTING POINT: N.E.CORNER OF O.L. 34 & CL OF LEAVITT RD. (S.R. 58)

16-03504

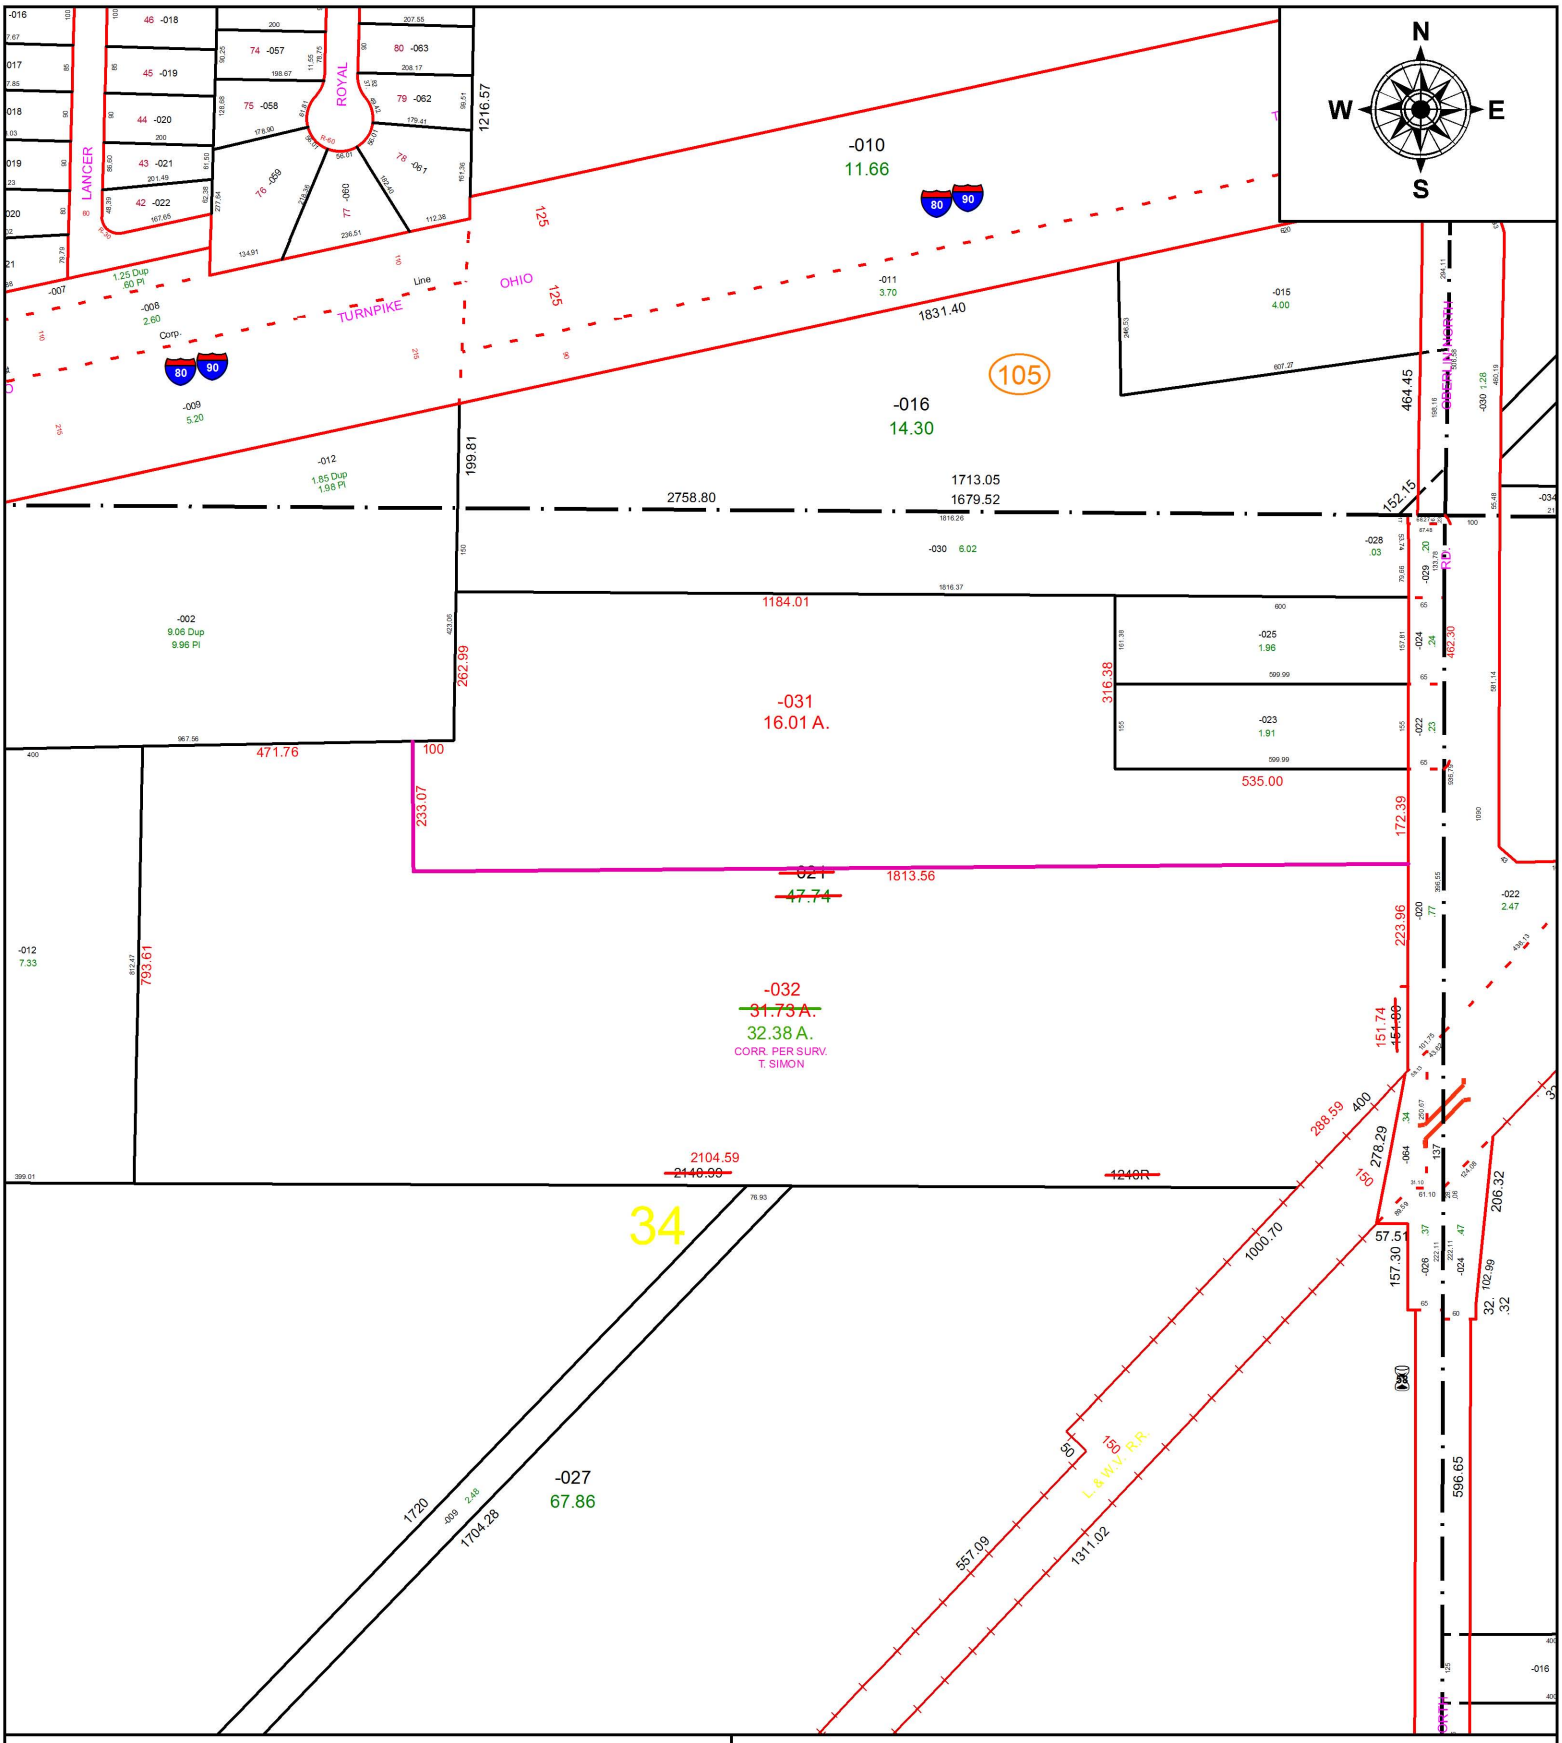

SPLITS/DEEDS PROCESSED

LORAIN COUNTY TAX MAP DEPARTMENT
226 MIDDLE AVE. ELYRIA, OH

SURVEYED BY: THOMAS SIMON
CLOSURE: 1: 33,000
MAP PAGE(S): 05-00-034
APPOVED BY: TJS **DATE:** 4/8/16
SCALE: 1" = 350 **PRIOR INSTRUMENT:** 2008-0268988