PARENT PARCEL: 07-00-025-106-049
CHILD PARCEL: 07-00-025-106-070, -071
STARTING POINT: NORTHEAST CORNER OF LAND CONVEYED TO ALFRED & ANGELICA RITSKO

16-03506-U

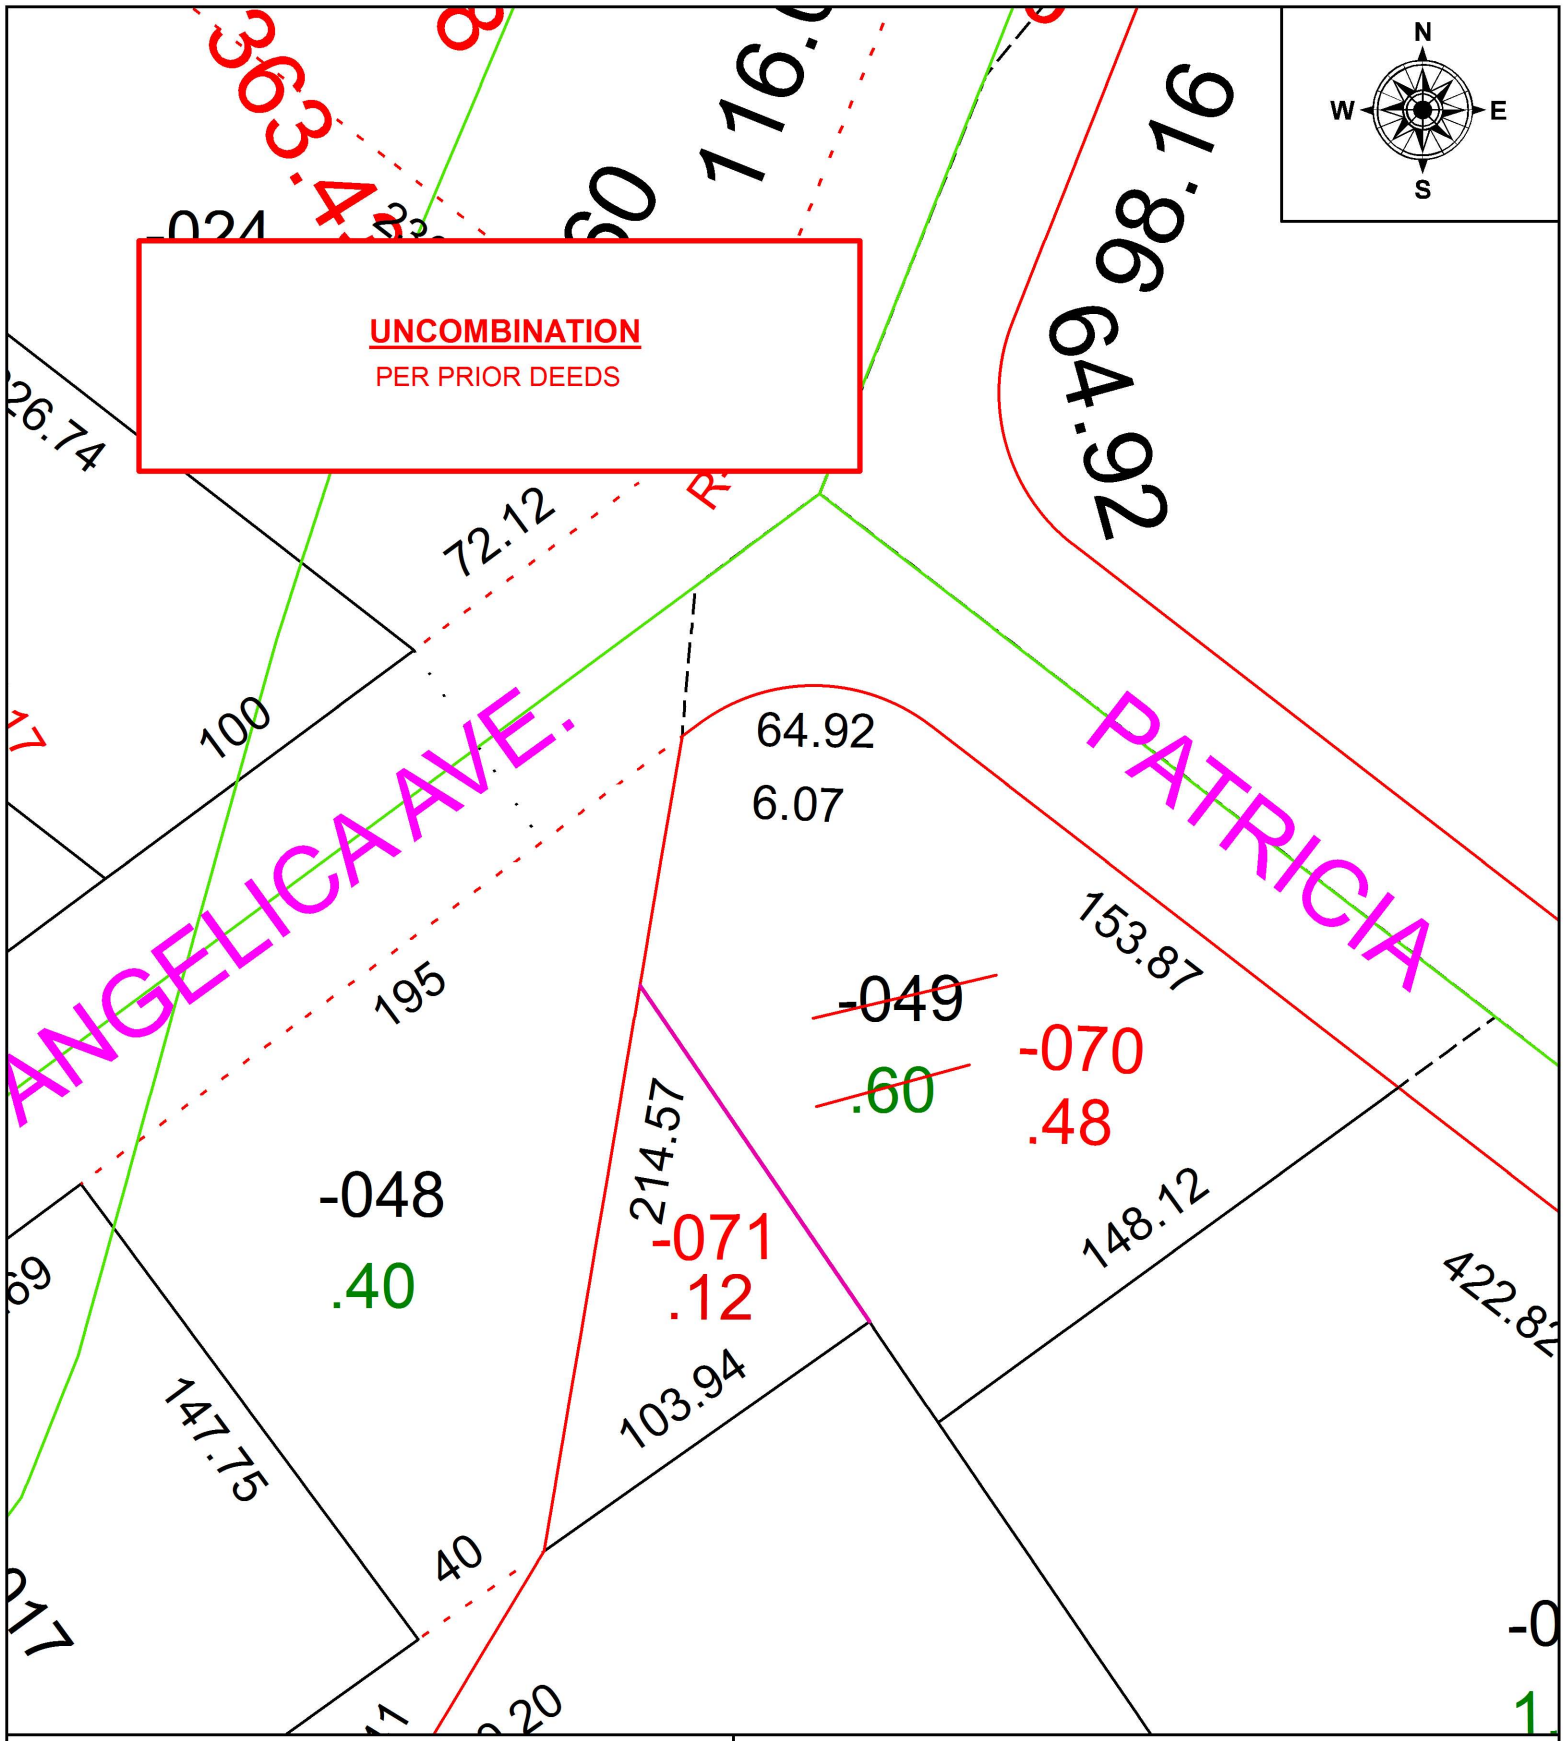

SPLITS/DEEDS PROCESSED
LORAIN COUNTY TAX MAP DEPARTMENT
226 MIDDLE AVE. ELYRIA, OH

SURVEYED BY: N/A
CLOSURE: 1: 64,638.03
MAP PAGE(S): 7-00-025
APPOVED BY: RRM **DATE:** 8-29-16
SCALE: 1" = 50 **PRIOR INSTRUMENT:** 20060181115