PARENT PARCEL: 07-00-001-000-016
CHILD PARCEL: XX-XX-XXX-XXX-XXX
STARTING POINT: INTERSECTION OF C/L OF ROOT RD. AND C/L OF SPRAGUE RD.

16-03507-D

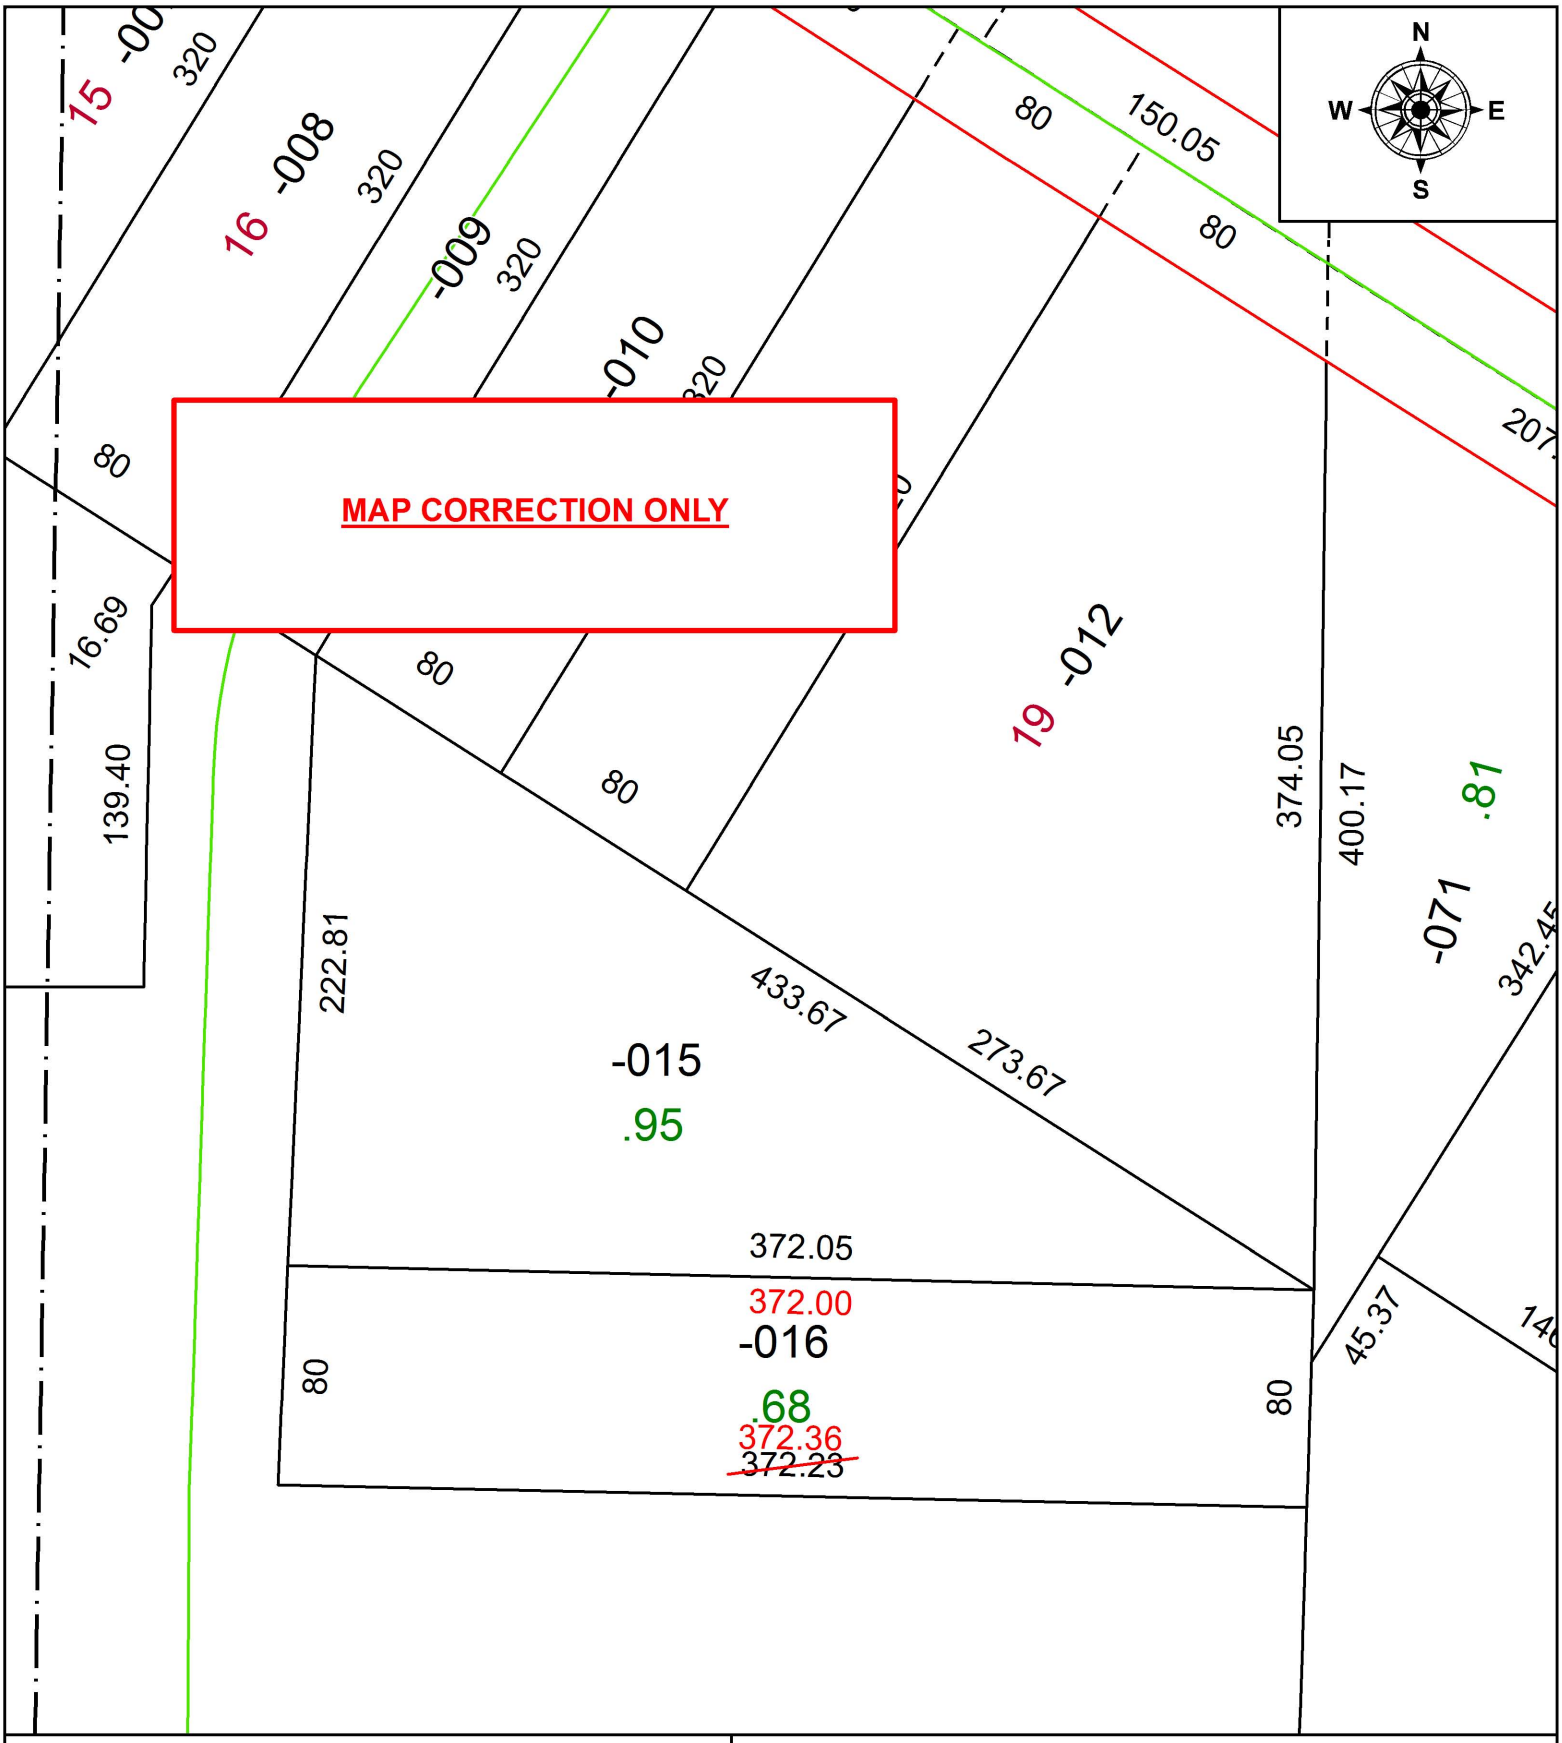

SPLITS/DEEDS PROCESSED
LORAIN COUNTY TAX MAP DEPARTMENT
226 MIDDLE AVE. ELYRIA, OH

SURVEYED BY: WILLIAM R. WALLACE
CLOSURE: 1:1,112,127
MAP PAGE(S): 7-00-001
APPOVED BY: RRM **DATE:** 8-29-16
SCALE: 1" = 70 **PRIOR INSTRUMENT:** 20140526336