PARENT PARCEL: 15-00-099-103-148
CHILD PARCEL: 15-00-099-103-162, -163
STARTING POINT: Northeast corner of S/L 18 of Pheasant run village PH 1 in Vol 27 pg 16

16-03508

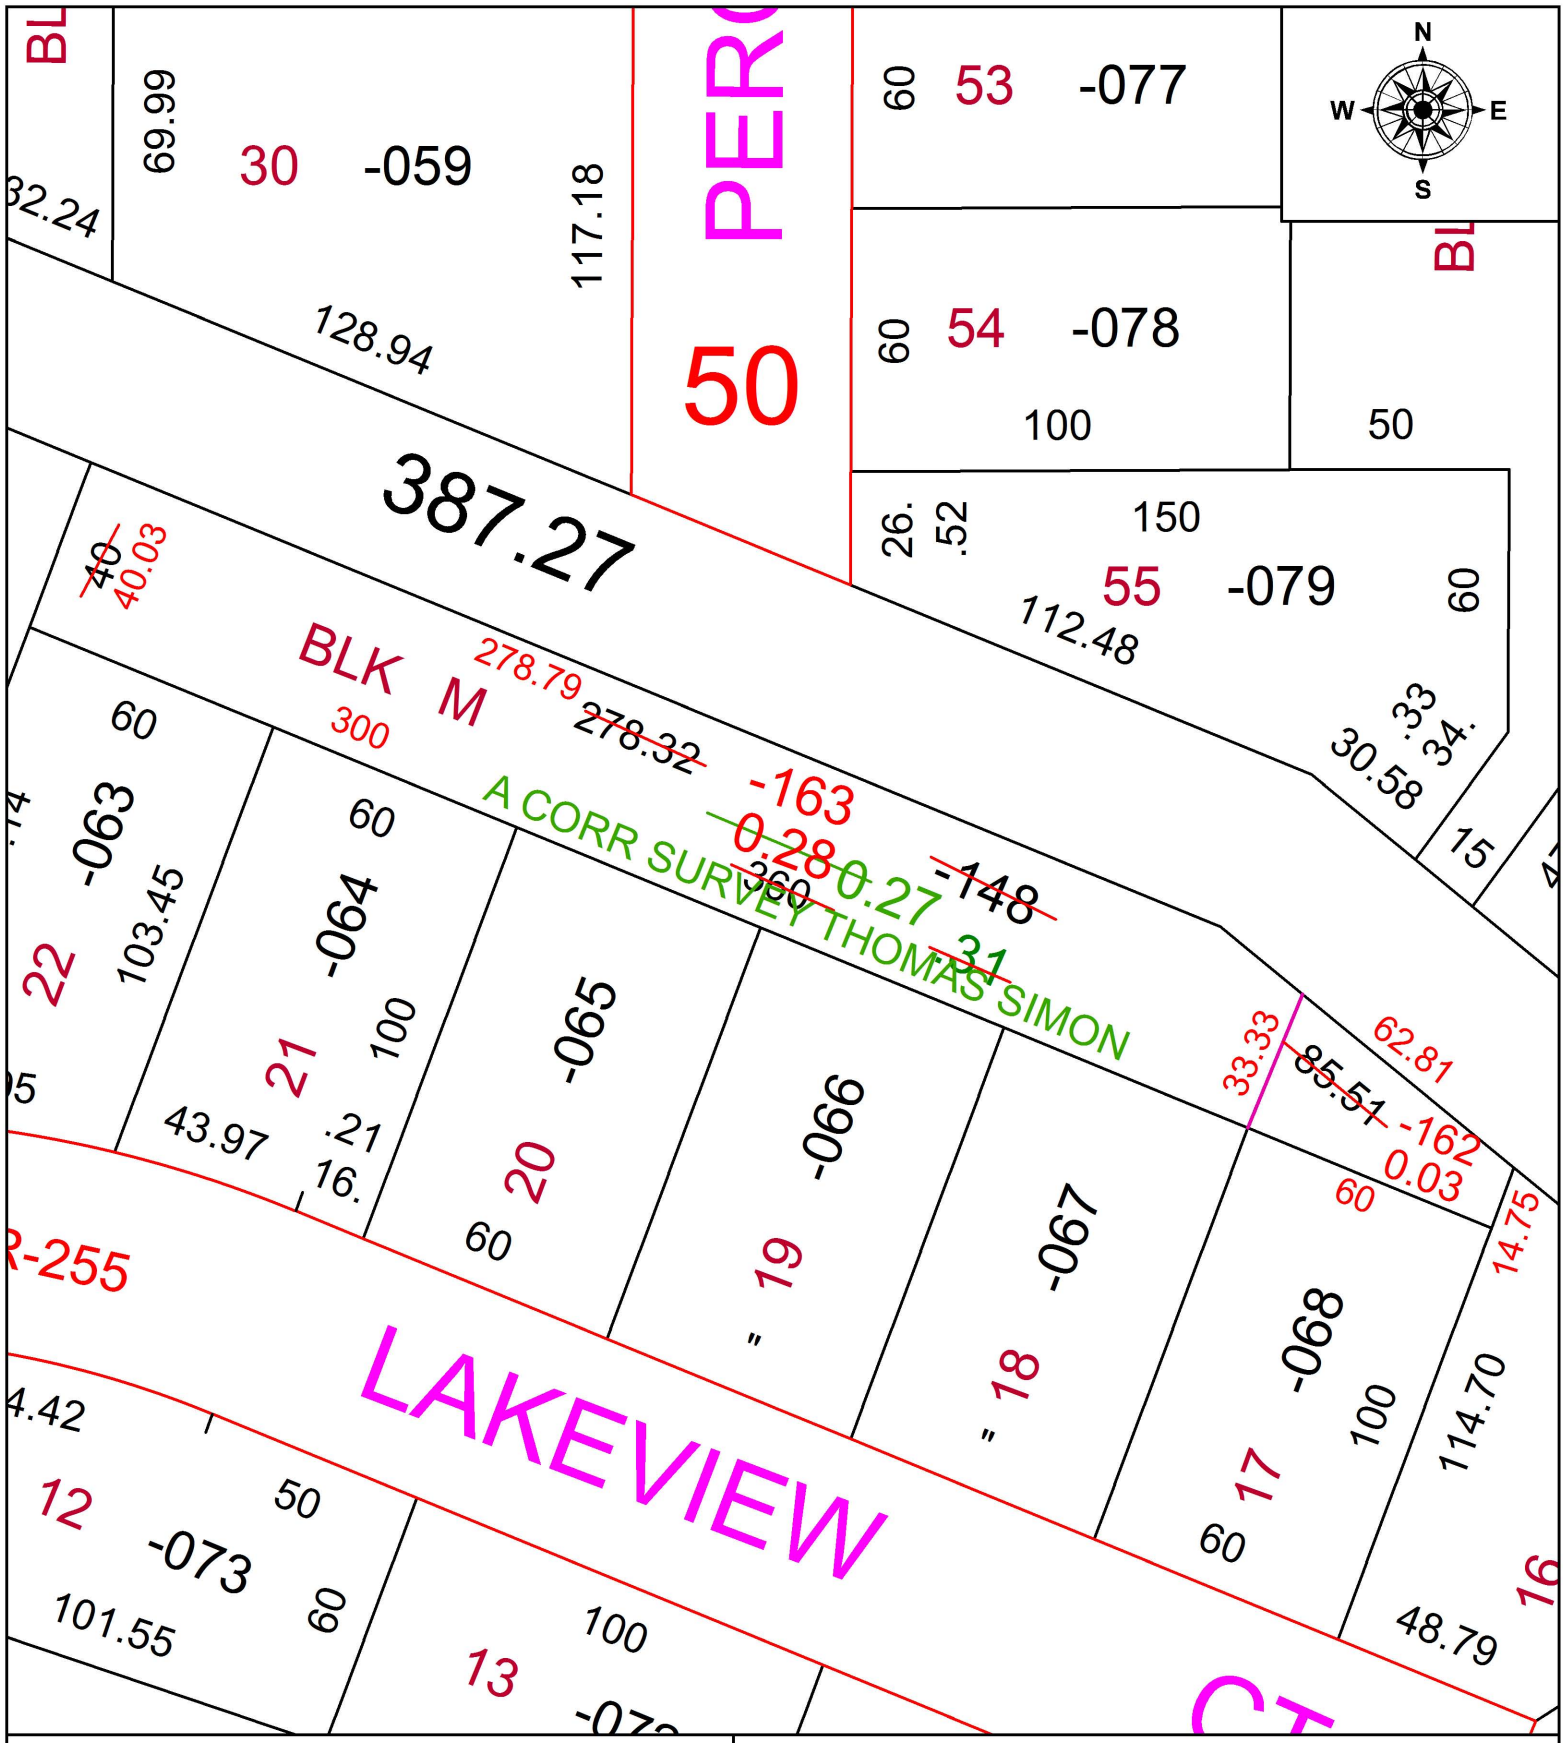

SPLITS/DEEDS PROCESSED
LORAIN COUNTY TAX MAP DEPARTMENT
226 MIDDLE AVE. ELYRIA, OH

SURVEYED BY: THOMAS SIMON
CLOSURE: 1:165089
MAP PAGE(S): 15-00-099
APPOVED BY: JAH **DATE:** 4/19/2016
SCALE: 1 in = 44 ft **PRIOR INSTRUMENT:** 20150554268