PARENT PARCEL: ADD TO DUP.
CHILD PARCEL: 03-00-107-104-045
STARTING POINT: C/L OF ELYRIA AVE. AND STATION 52-10.68

16-03509-C

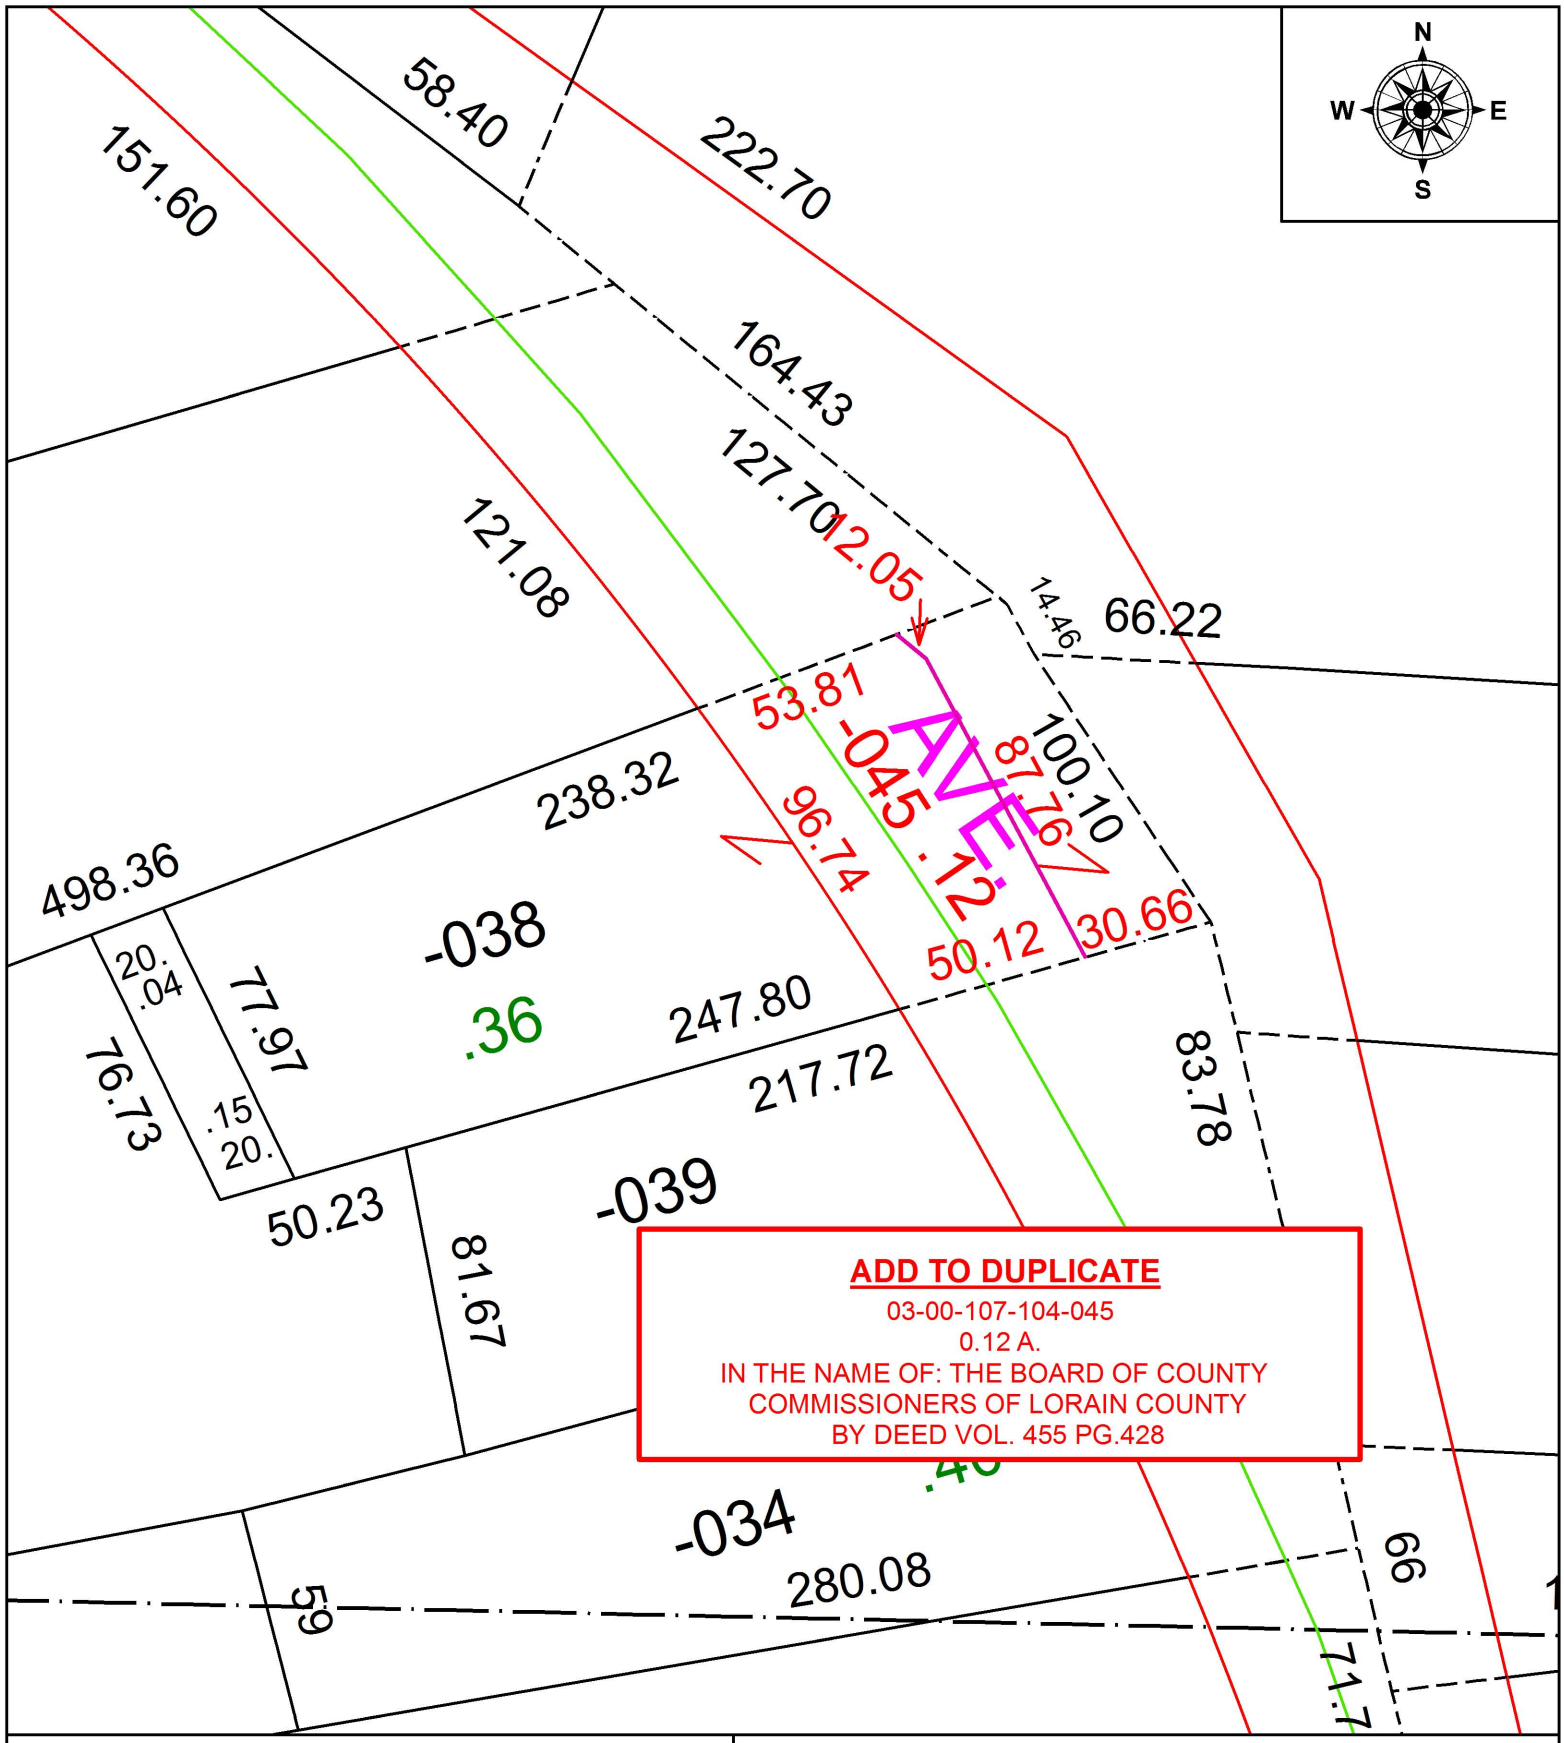

ADD TO DUPLICATE
03-00-107-104-045
0.12 A.
IN THE NAME OF: THE BOARD OF COUNTY COMMISSIONERS OF LORAIN COUNTY
BY DEED VOL. 455 PG.428

SPLITS/DEEDS PROCESSED
LORAIN COUNTY TAX MAP DEPARTMENT
226 MIDDLE AVE. ELYRIA, OH

SURVEYED BY: N/A
CLOSURE: 1: 3359
MAP PAGE(S): 3-00-107
APPOVED BY: RRM **DATE:** 8-30-16
SCALE: 1" = 50 **PRIOR INSTRUMENT:** DV 455/428