PARENT PARCEL: 06-25-004-110-002 & -039
CHILD PARCEL: XX-XX-XXX-XXX-XXX
STARTING POINT: NA

16-03510-C

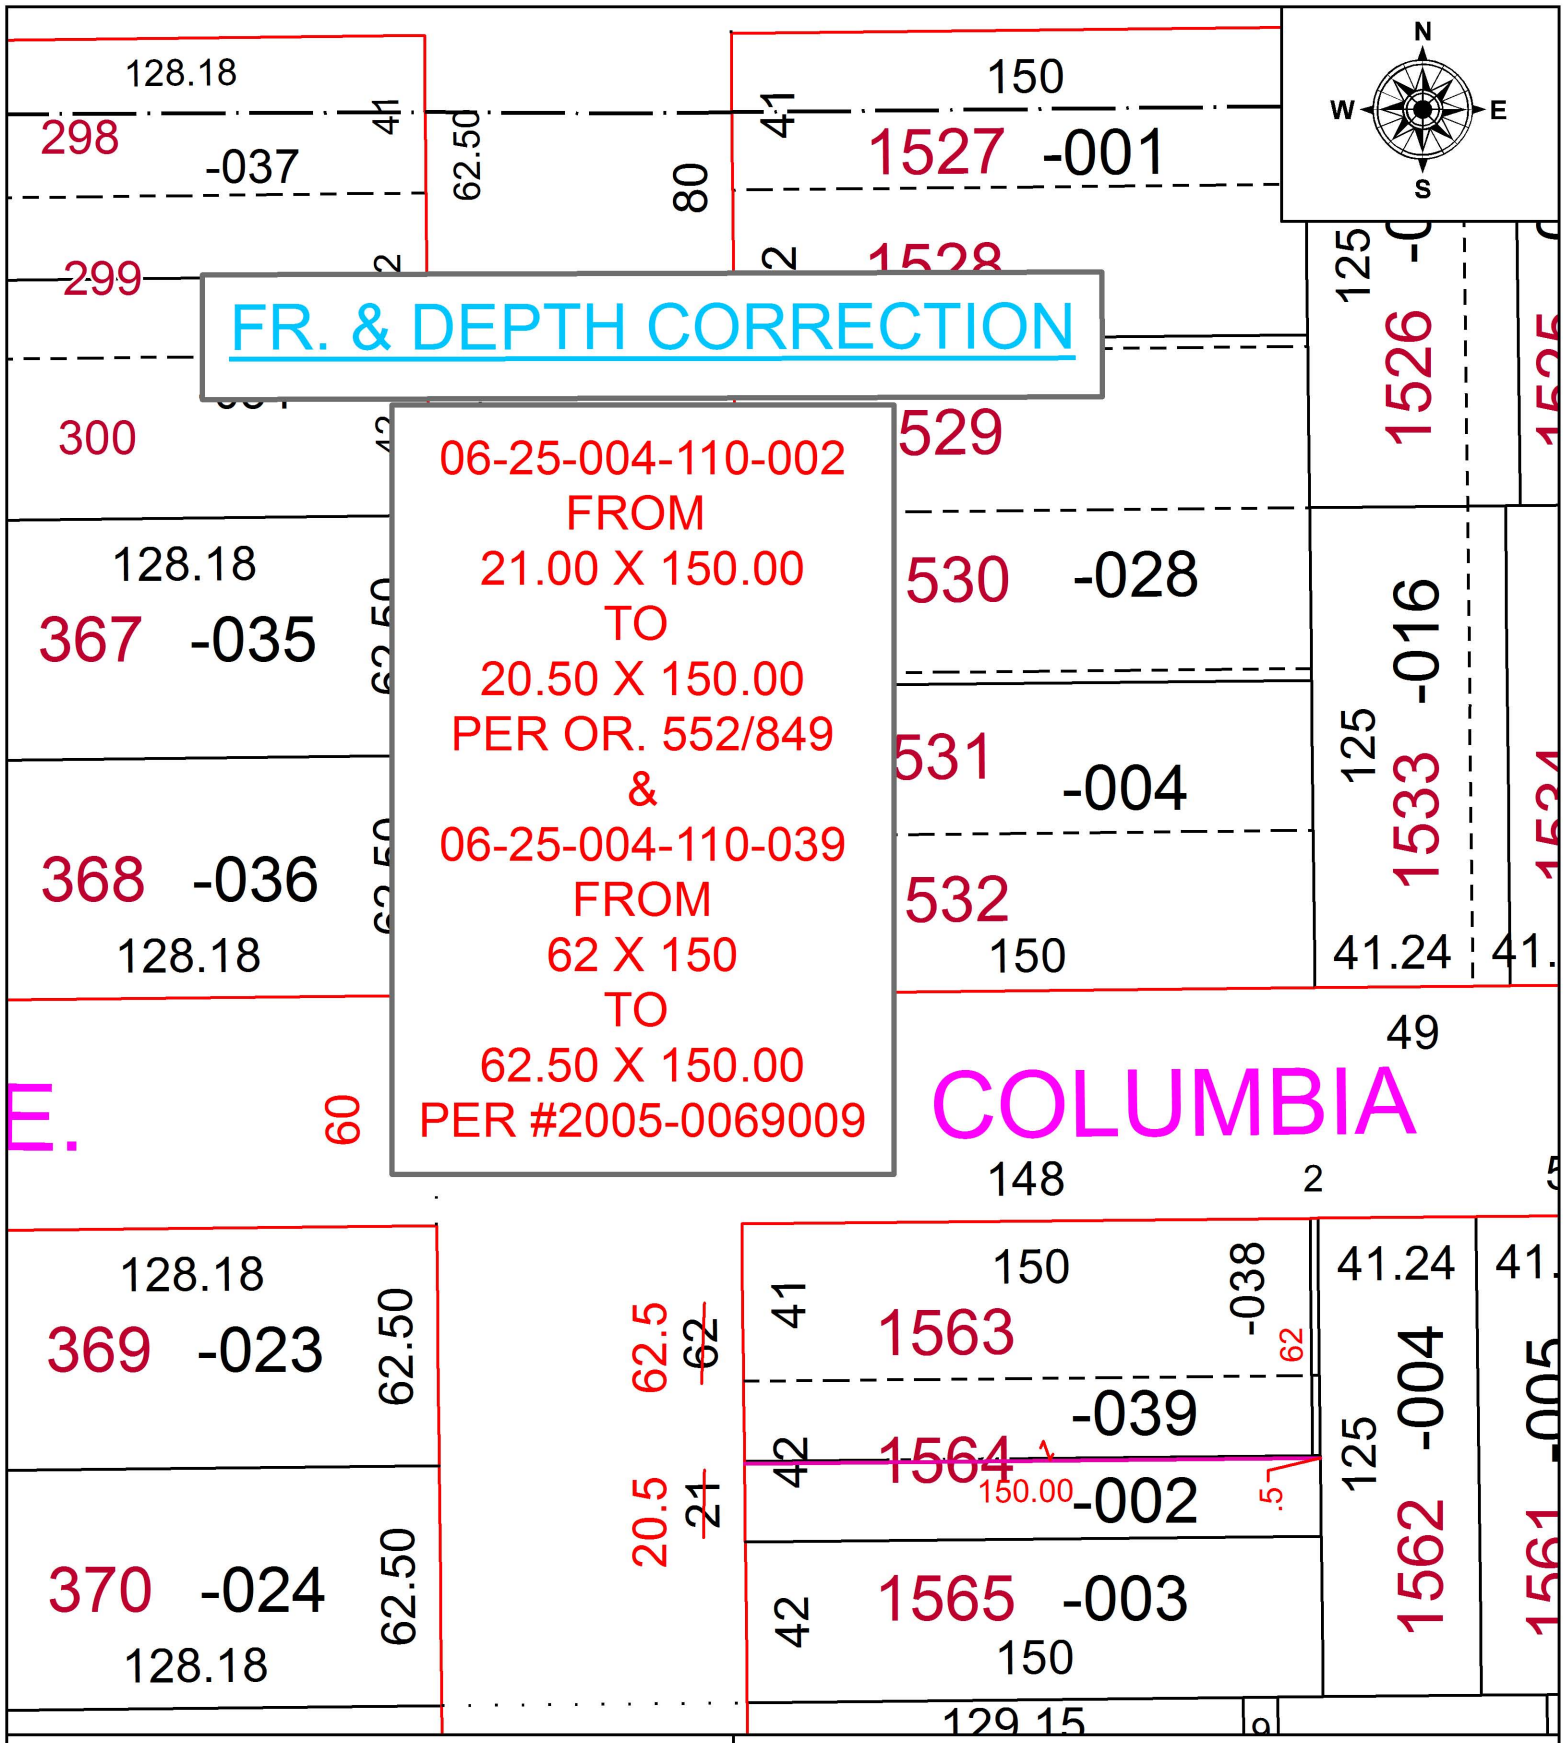

SPLITS/DEEDS PROCESSED
LORAIN COUNTY TAX MAP DEPARTMENT
226 MIDDLE AVE. ELYRIA, OH

SURVEYED BY: NA
CLOSURE: 1: 33,000
MAP PAGE(S): 06-25-004
APPOVED BY: TJS DATE: 9/1/16
SCALE: 1" = 50 PRIOR INSTRUMENT: OR 552/849