PARENT PARCEL: 04-00-002-101-032
CHILD PARCEL: XX-XX-XXX-XXX-XXX
STARTING POINT: INTERSECTION OF C/L OF MOON RD. AND C/L OF S.R.254

16-03511-D

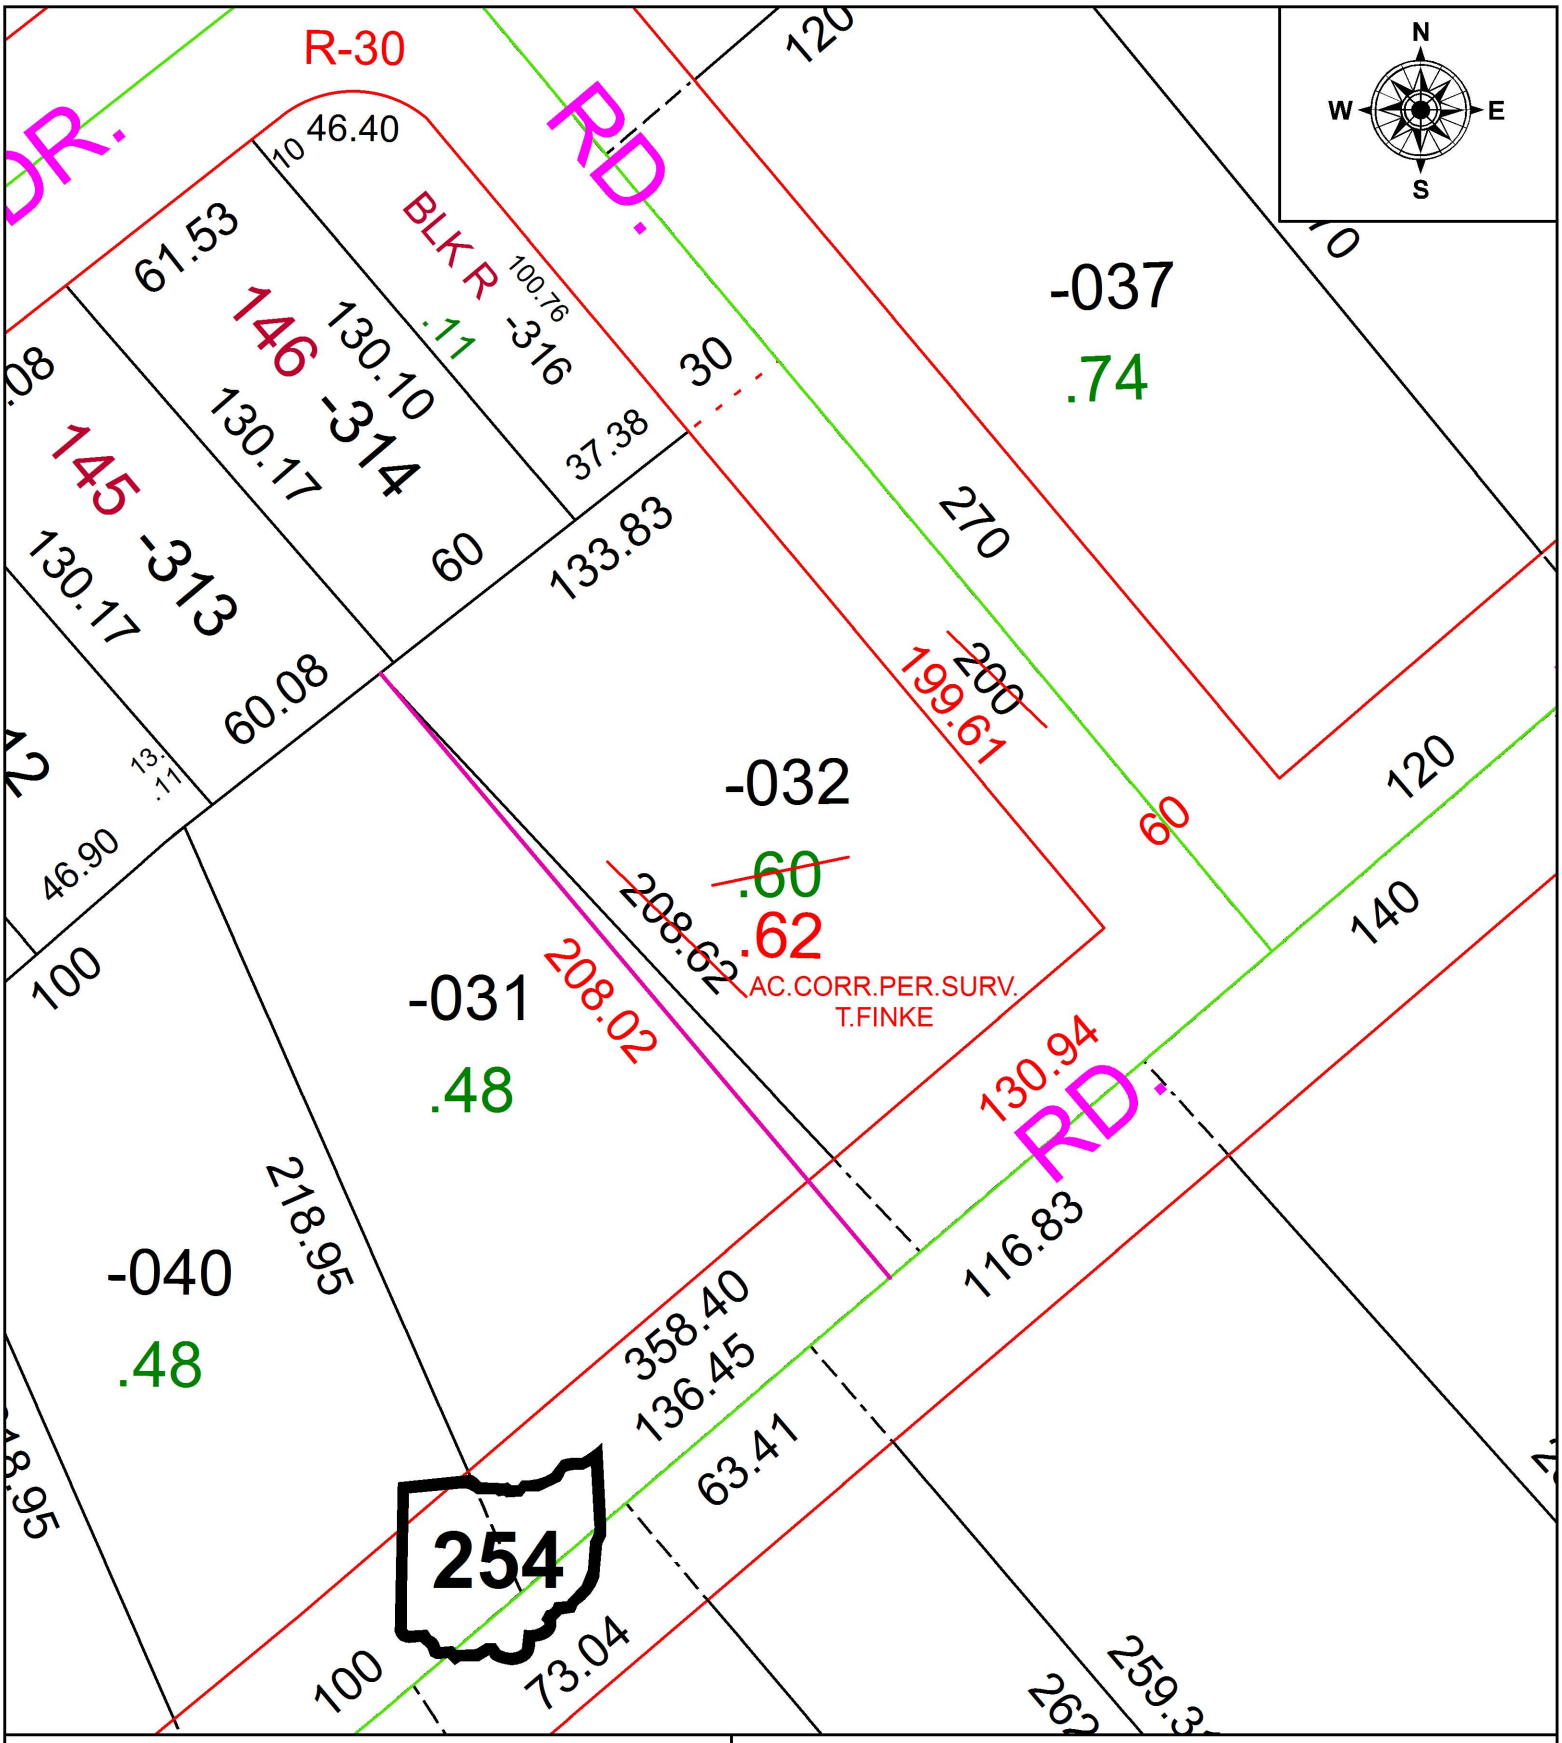

SPLITS/DEEDS PROCESSED
LORAIN COUNTY TAX MAP DEPARTMENT
226 MIDDLE AVE. ELYRIA, OH

SURVEYED BY: TIMOTHY A. FINKE
CLOSURE: 1: 2,787,444
MAP PAGE(S): 4-00-002
APPOVED BY: RRM **DATE:** 9-7-16
SCALE: 1" = 50 **PRIOR INSTRUMENT:** 20110391390