PARENT PARCEL: 07-00-045-110-014
CHILD PARCEL: XX-XX-XXX-XXX-XXX
STARTING POINT: SOUTHEAST CORNER OF RUNNING BROOK SUB. NO.1

16-03515-D

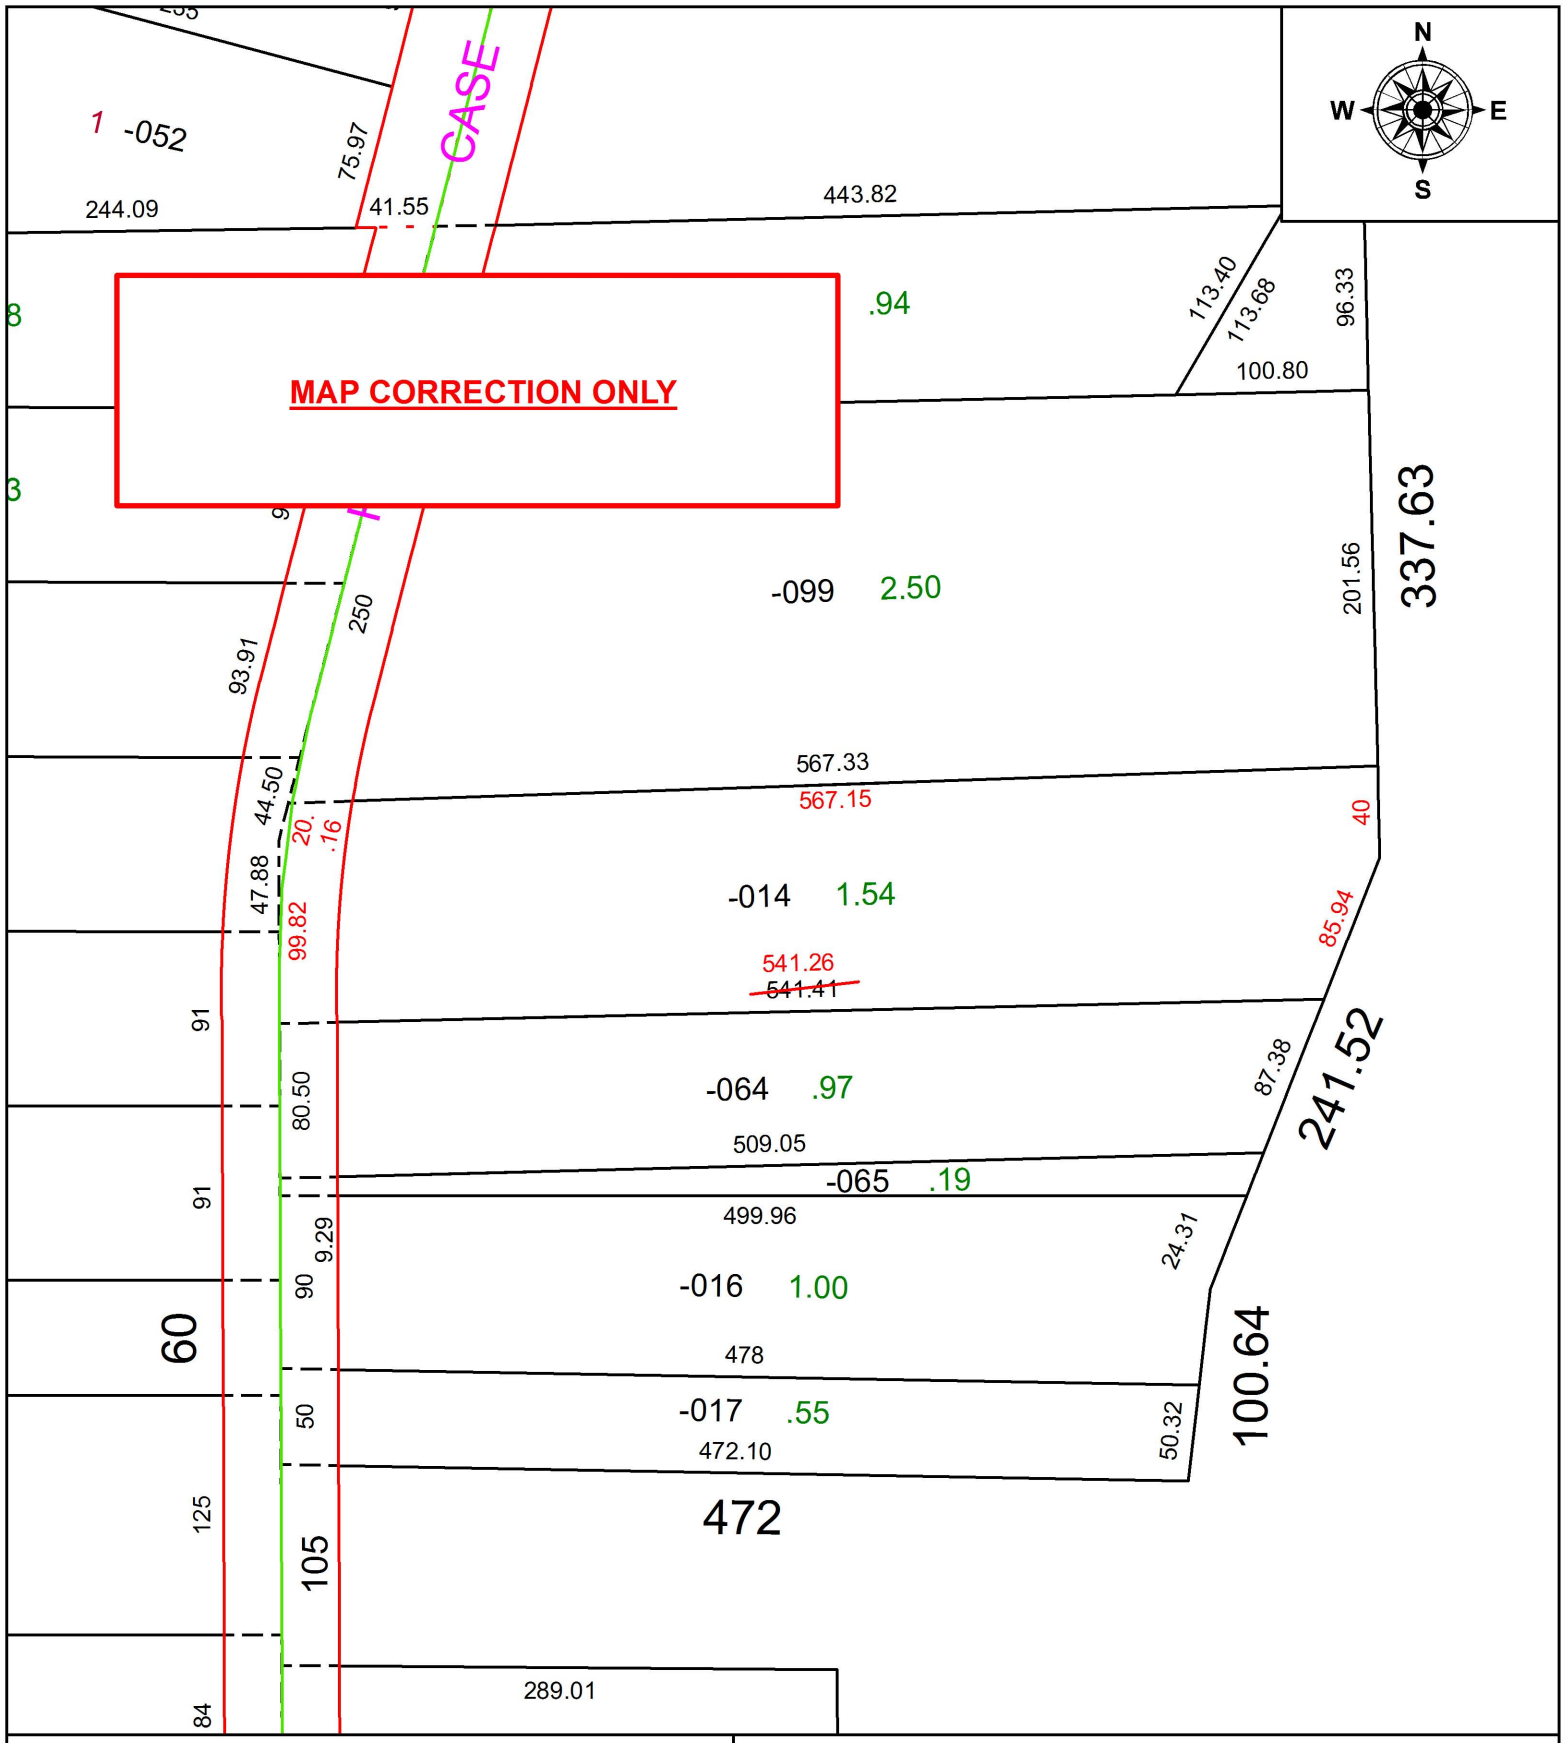

SPLITS/DEEDS PROCESSED
LORAIN COUNTY TAX MAP DEPARTMENT
226 MIDDLE AVE. ELYRIA, OH

SURVEYED BY: WILFREDO BARBOSA
CLOSURE: 1: 200,390
MAP PAGE(S): 7-00-045
APPOVED BY: RRM **DATE:** 9-12-16
SCALE: 1" = 100 **PRIOR INSTRUMENT:** 20130477382