**PARENT PARCEL:** 10-00-020-103-059
**CHILD PARCEL:** XX-XX-XXX-XXX-XXX
**STARTING POINT:** CL OF HALE RD. & CL OF HASTINGS RD.

# 16-03516-C

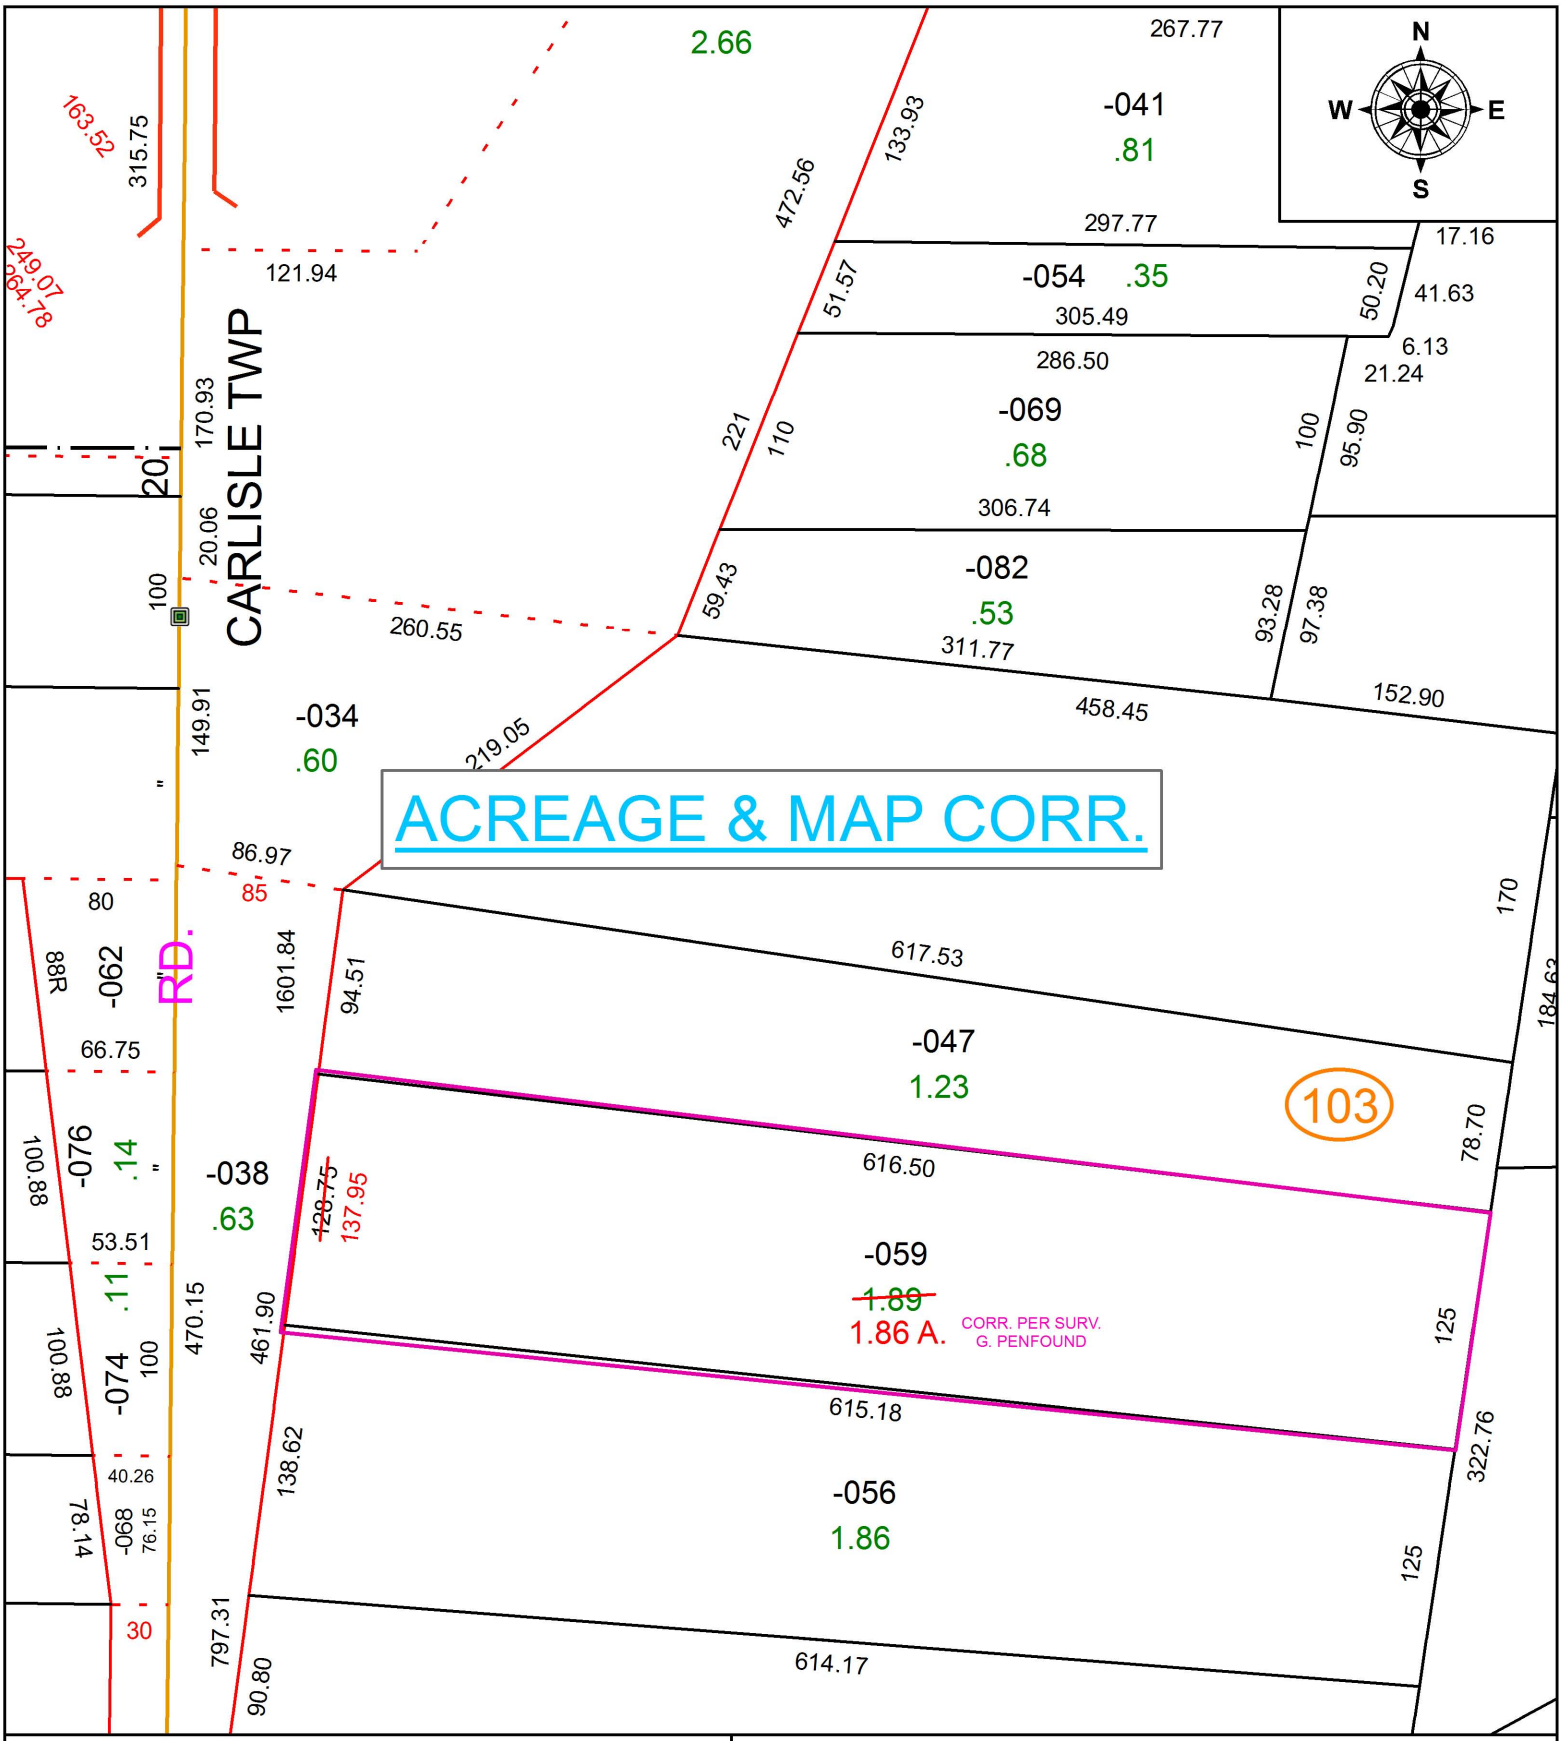


**SPLITS/DEEDS PROCESSED**
LORAIN COUNTY TAX MAP DEPARTMENT
226 MIDDLE AVE. ELYRIA, OH

**SURVEYED BY:** GARY E. PENFOUND
**CLOSURE:** 1: 33,000
**MAP PAGE(S):** 10-00-020
**APPOVED BY:** TJS **DATE:** 9/9/16
**SCALE:** 1" = 100 **PRIOR INSTRUMENT:** DV XXXX/XXXX