PARENT PARCEL: 09-00-075-102-059
CHILD PARCEL: XX-XX-XXX-XXX-XXX
STARTING POINT: INTERSECTION OF C/L OF UNION ST AND C/L OF HOLLYWOOD ST.

16-03517-D

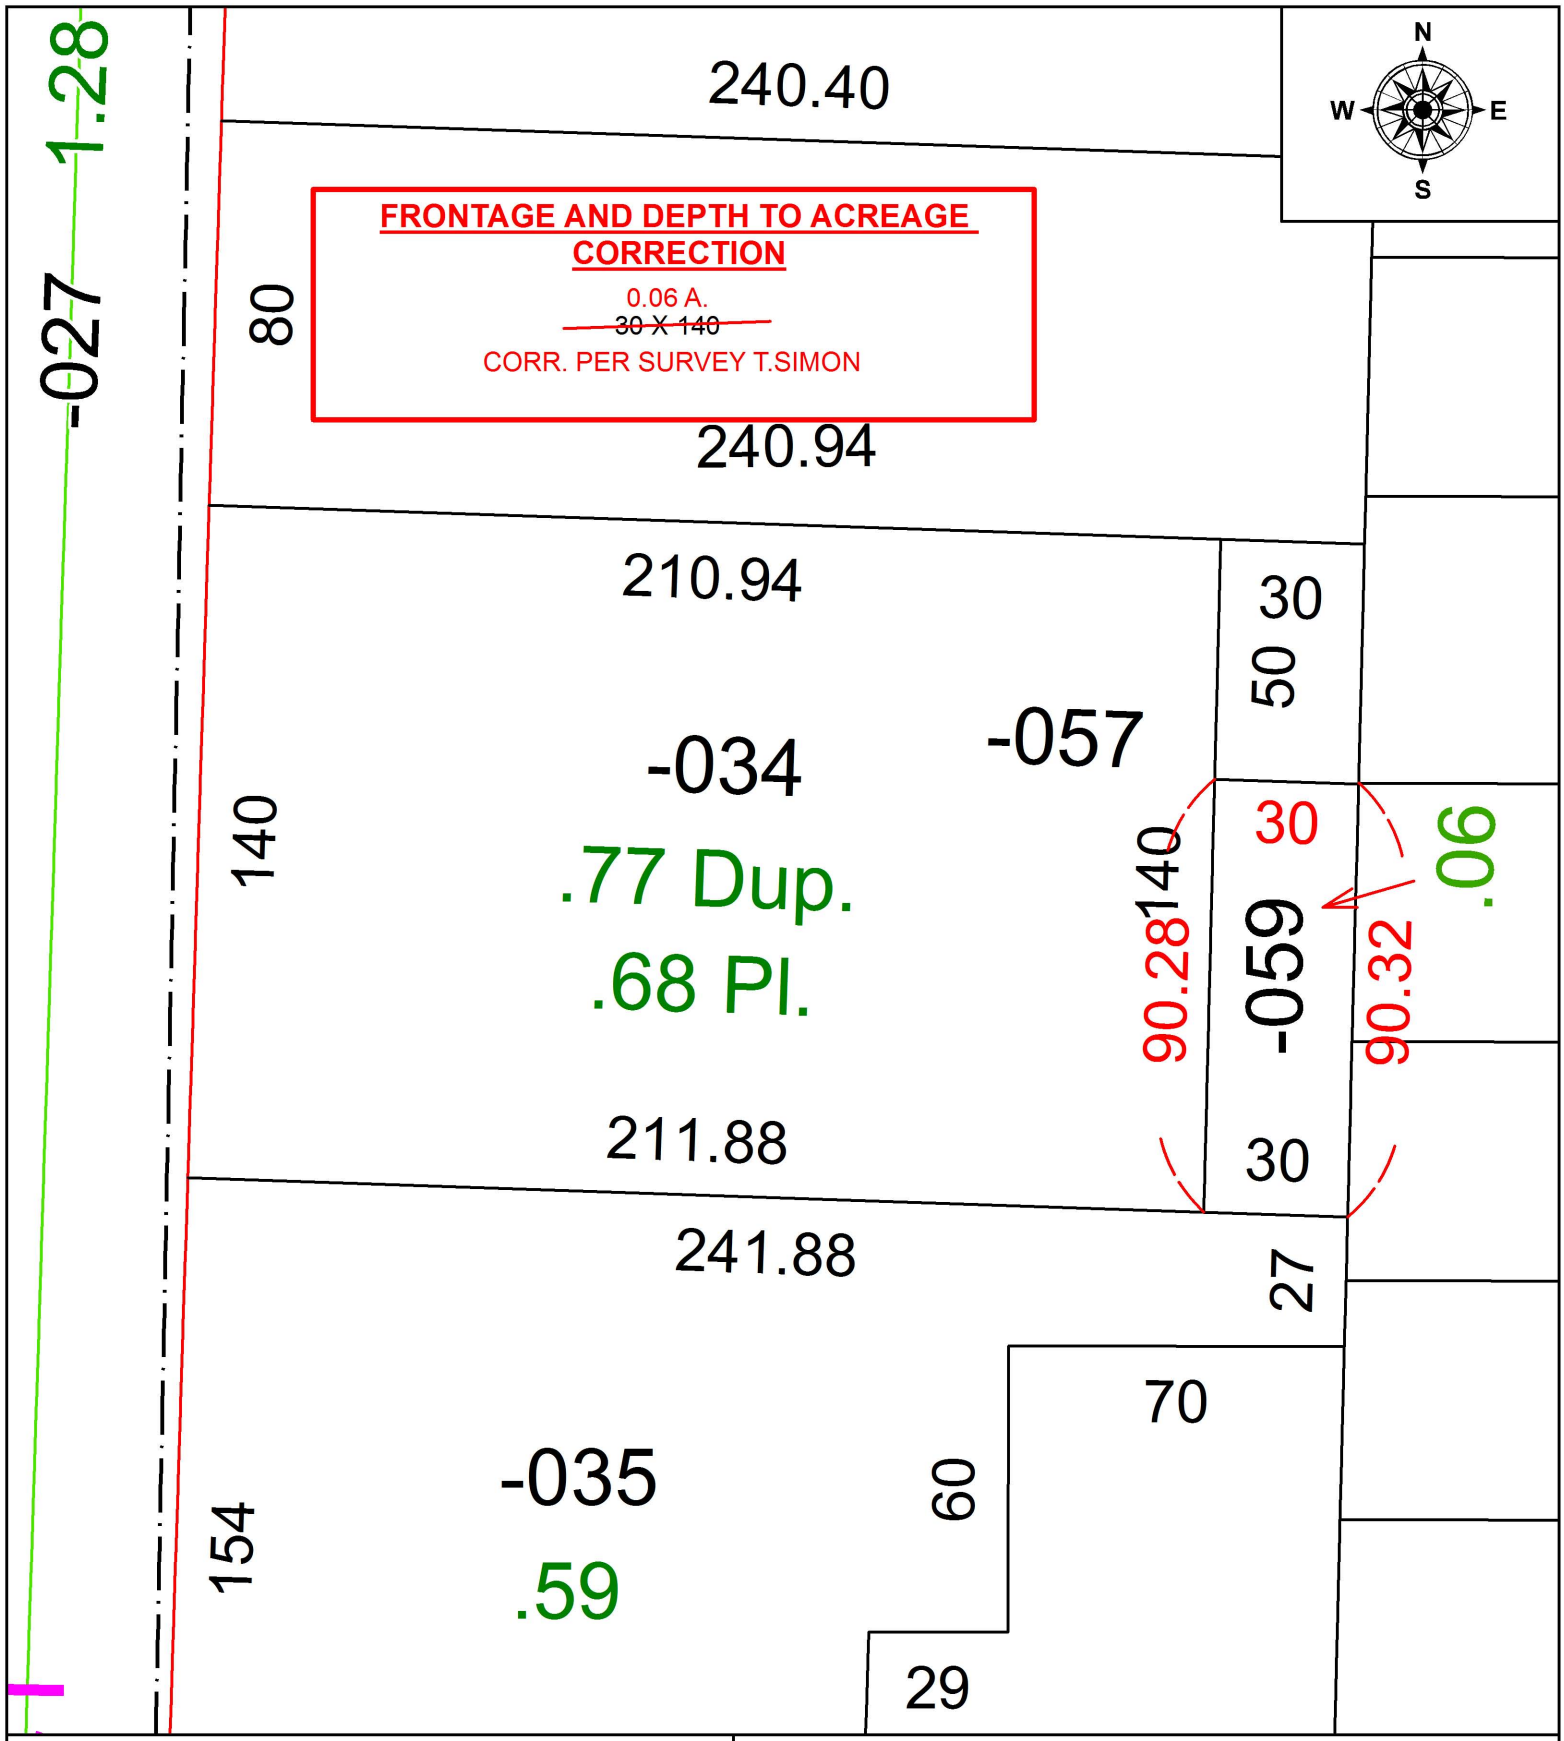

SPLITS/DEEDS PROCESSED
LORAIN COUNTY TAX MAP DEPARTMENT
226 MIDDLE AVE. ELYRIA, OH

SURVEYED BY: THOMAS A. SIMON
CLOSURE: 1: 71,374
MAP PAGE(S): 9-00-075
APPOVED BY: RRM **DATE:** 9-12-16
SCALE: 1" = 40 **PRIOR INSTRUMENT:** 20140503358