PARENT PARCEL: 07-00-044-102-035, -034

CHILD PARCEL: 07-00-044-102-051, -052, -053

STARTING POINT: CENTERLINE OF CASE RD & OTTEN RD

16-03519

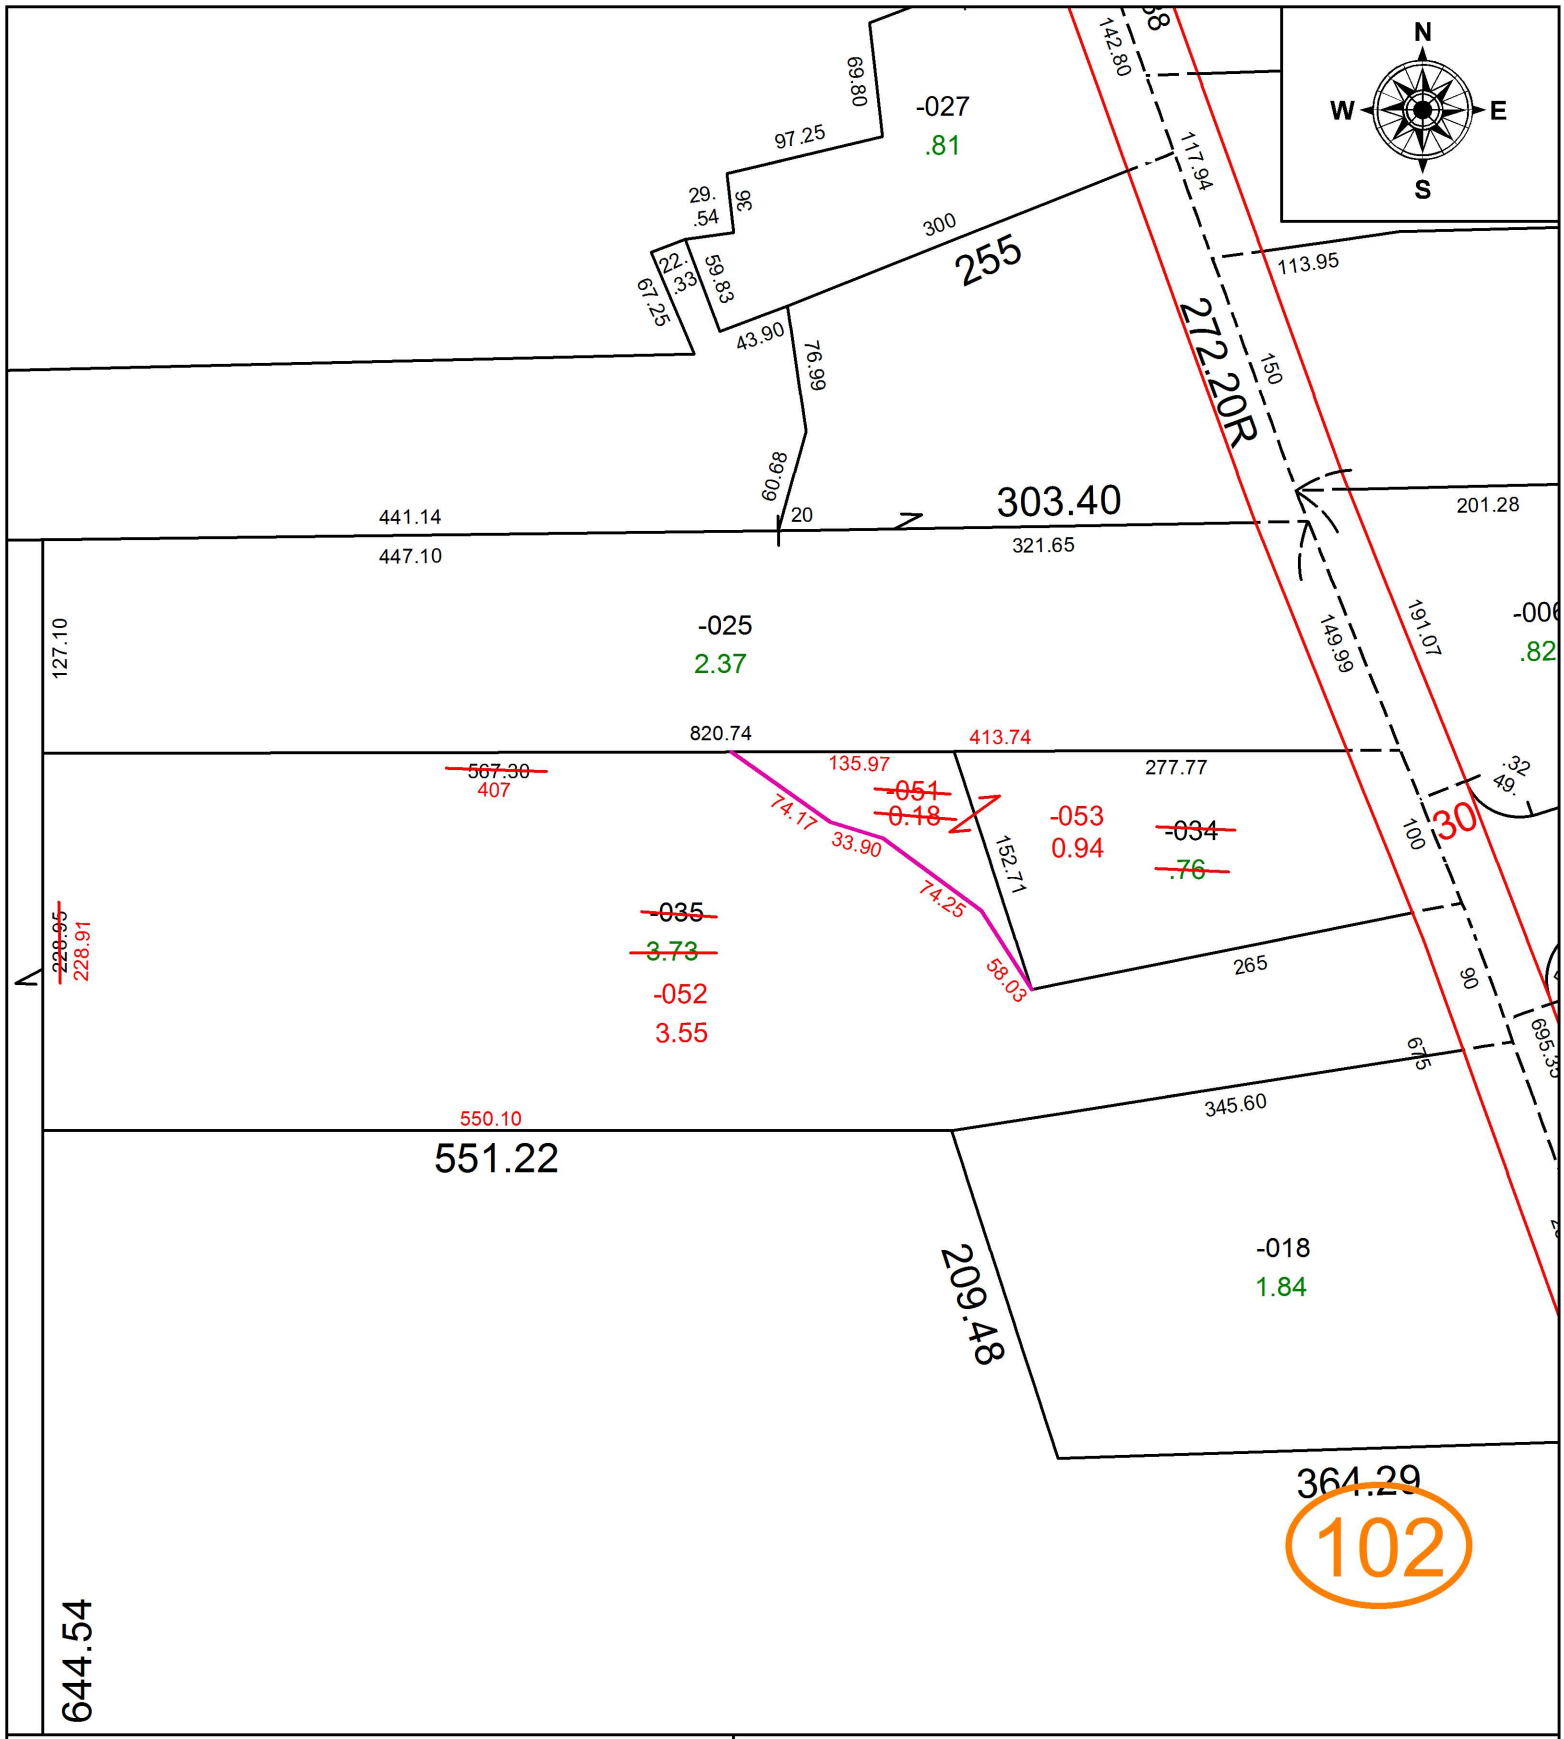

SPLITS/DEEDS PROCESSED

LORAIN COUNTY TAX MAP DEPARTMENT
226 MIDDLE AVE. ELYRIA, OH

SURVEYED BY: ROBERT DORNER
CLOSURE: 1:67810
MAP PAGE(S): 07-00-044
APPOVED BY: JAH **DATE:** 05-13-2016
SCALE: 1 in = 117 ft **PRIOR INSTRUMENT:** 20100341975