**PARENT PARCEL:** 04-00-010-117-003
**CHILD PARCEL:** XX-XX-XXX-XXX-XXX
**STARTING POINT:** INTERSECTION OF C/L OF JULIAN ST. AND C/L OF STONEY RIDGE RD.

16-03523-D

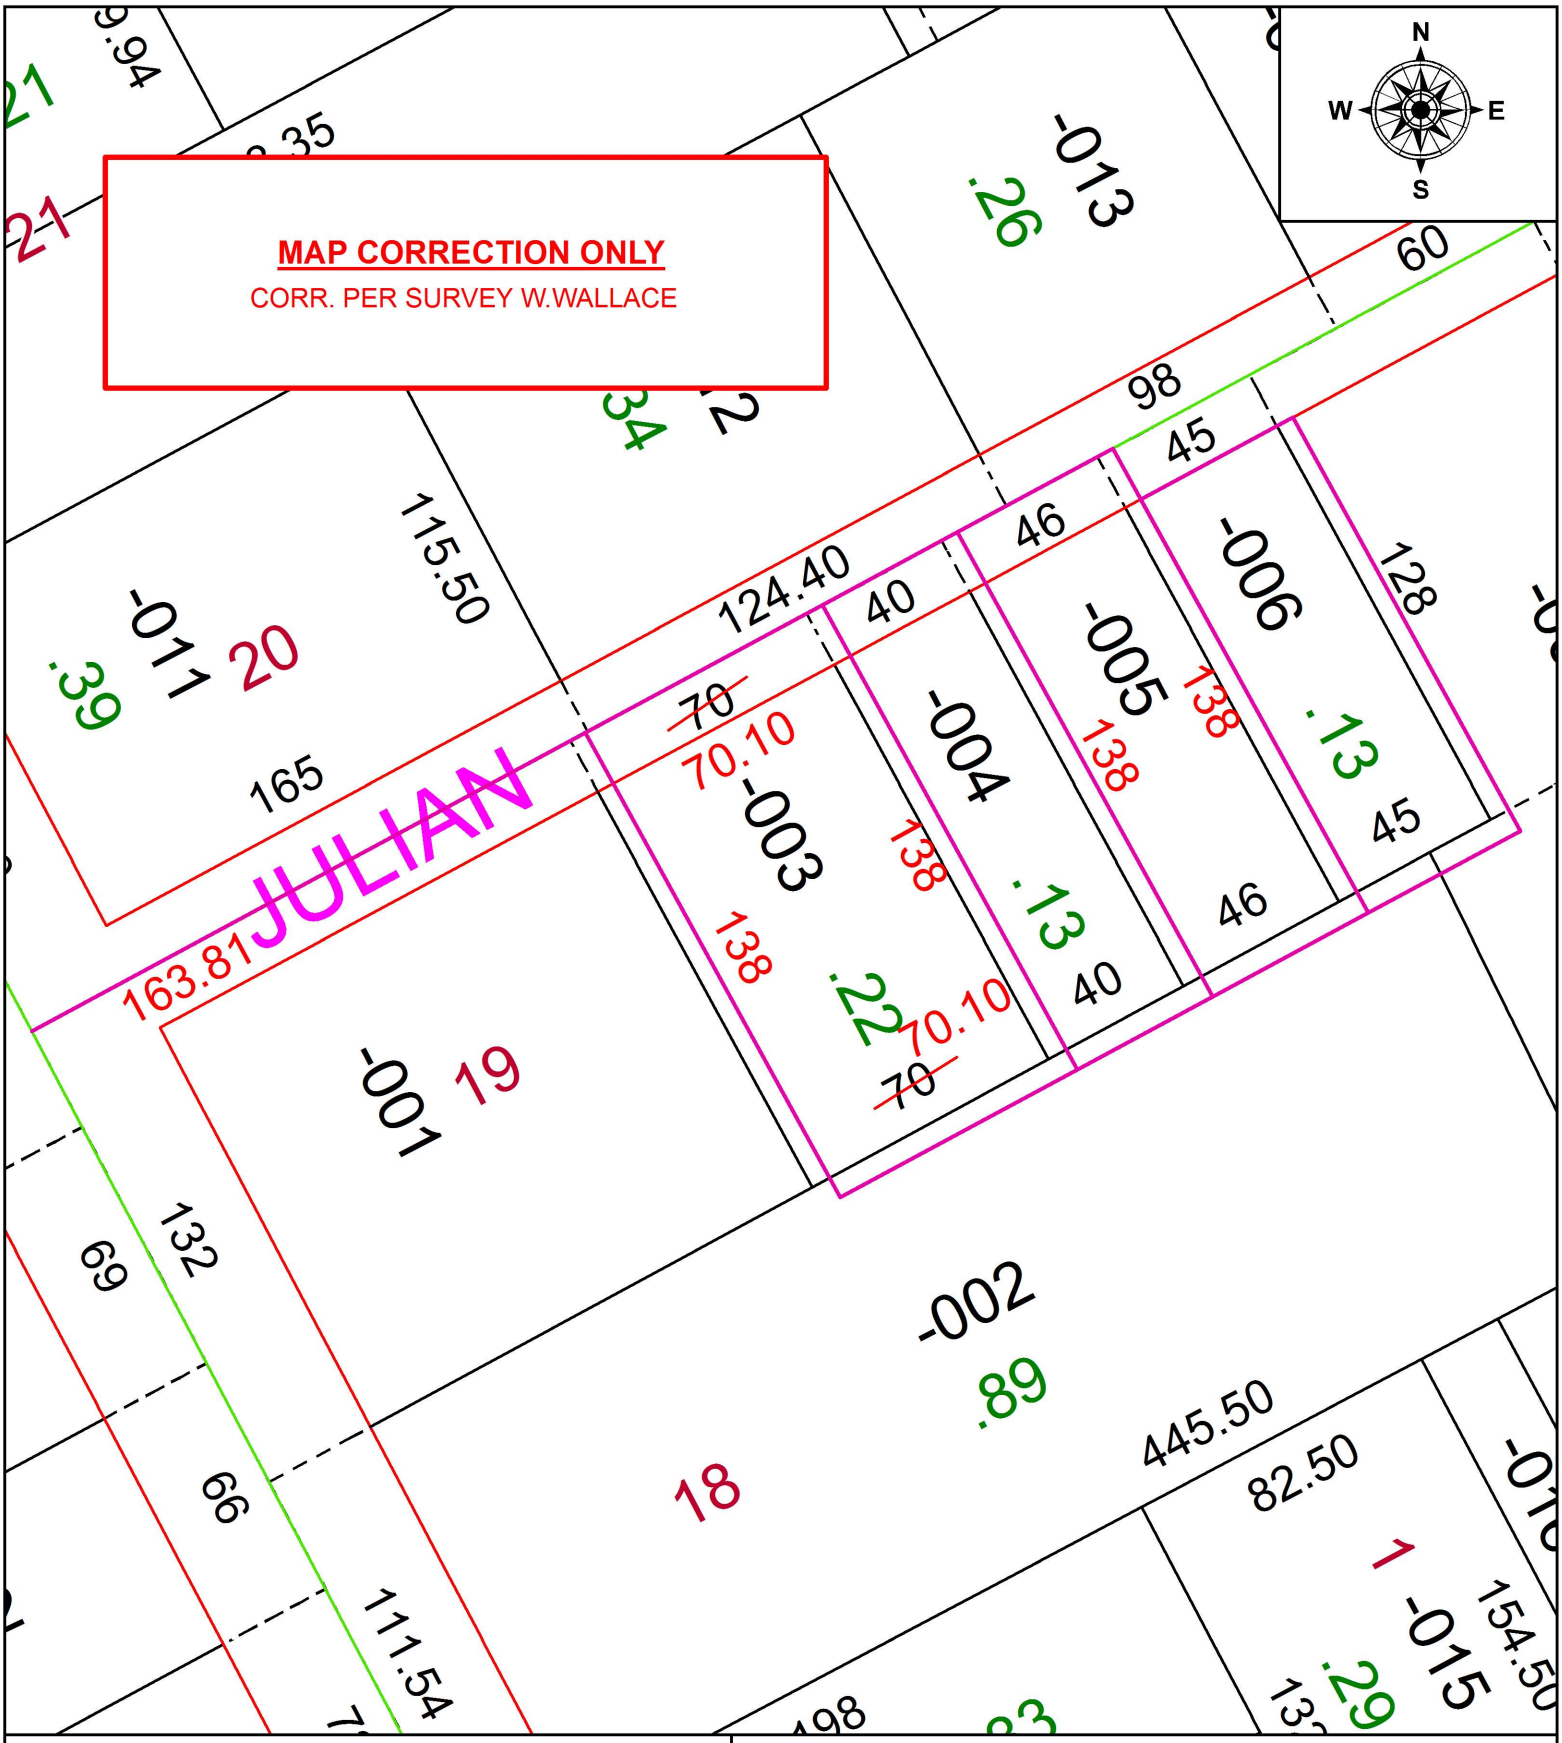


**SPLITS/DEEDS PROCESSED**
LORAIN COUNTY TAX MAP DEPARTMENT
226 MIDDLE AVE. ELYRIA, OH

**SURVEYED BY:** WILLIAM R. WALLACE
**CLOSURE:** 1: 2147483648
**MAP PAGE(S):** 4-00-010
**APPOVED BY:** RRM **DATE:** 9-21-16
**SCALE:** 1" = 50 **PRIOR INSTRUMENT:** 20110364466