PARENT PARCEL: 07-00-023-102-058, -059, -060

CHILD PARCEL: 07-00-023-102-071

STARTING POINT: CENTERLINE OF CHESTNUT RIDGE RD & FOREST GLEN WAY

16-03526

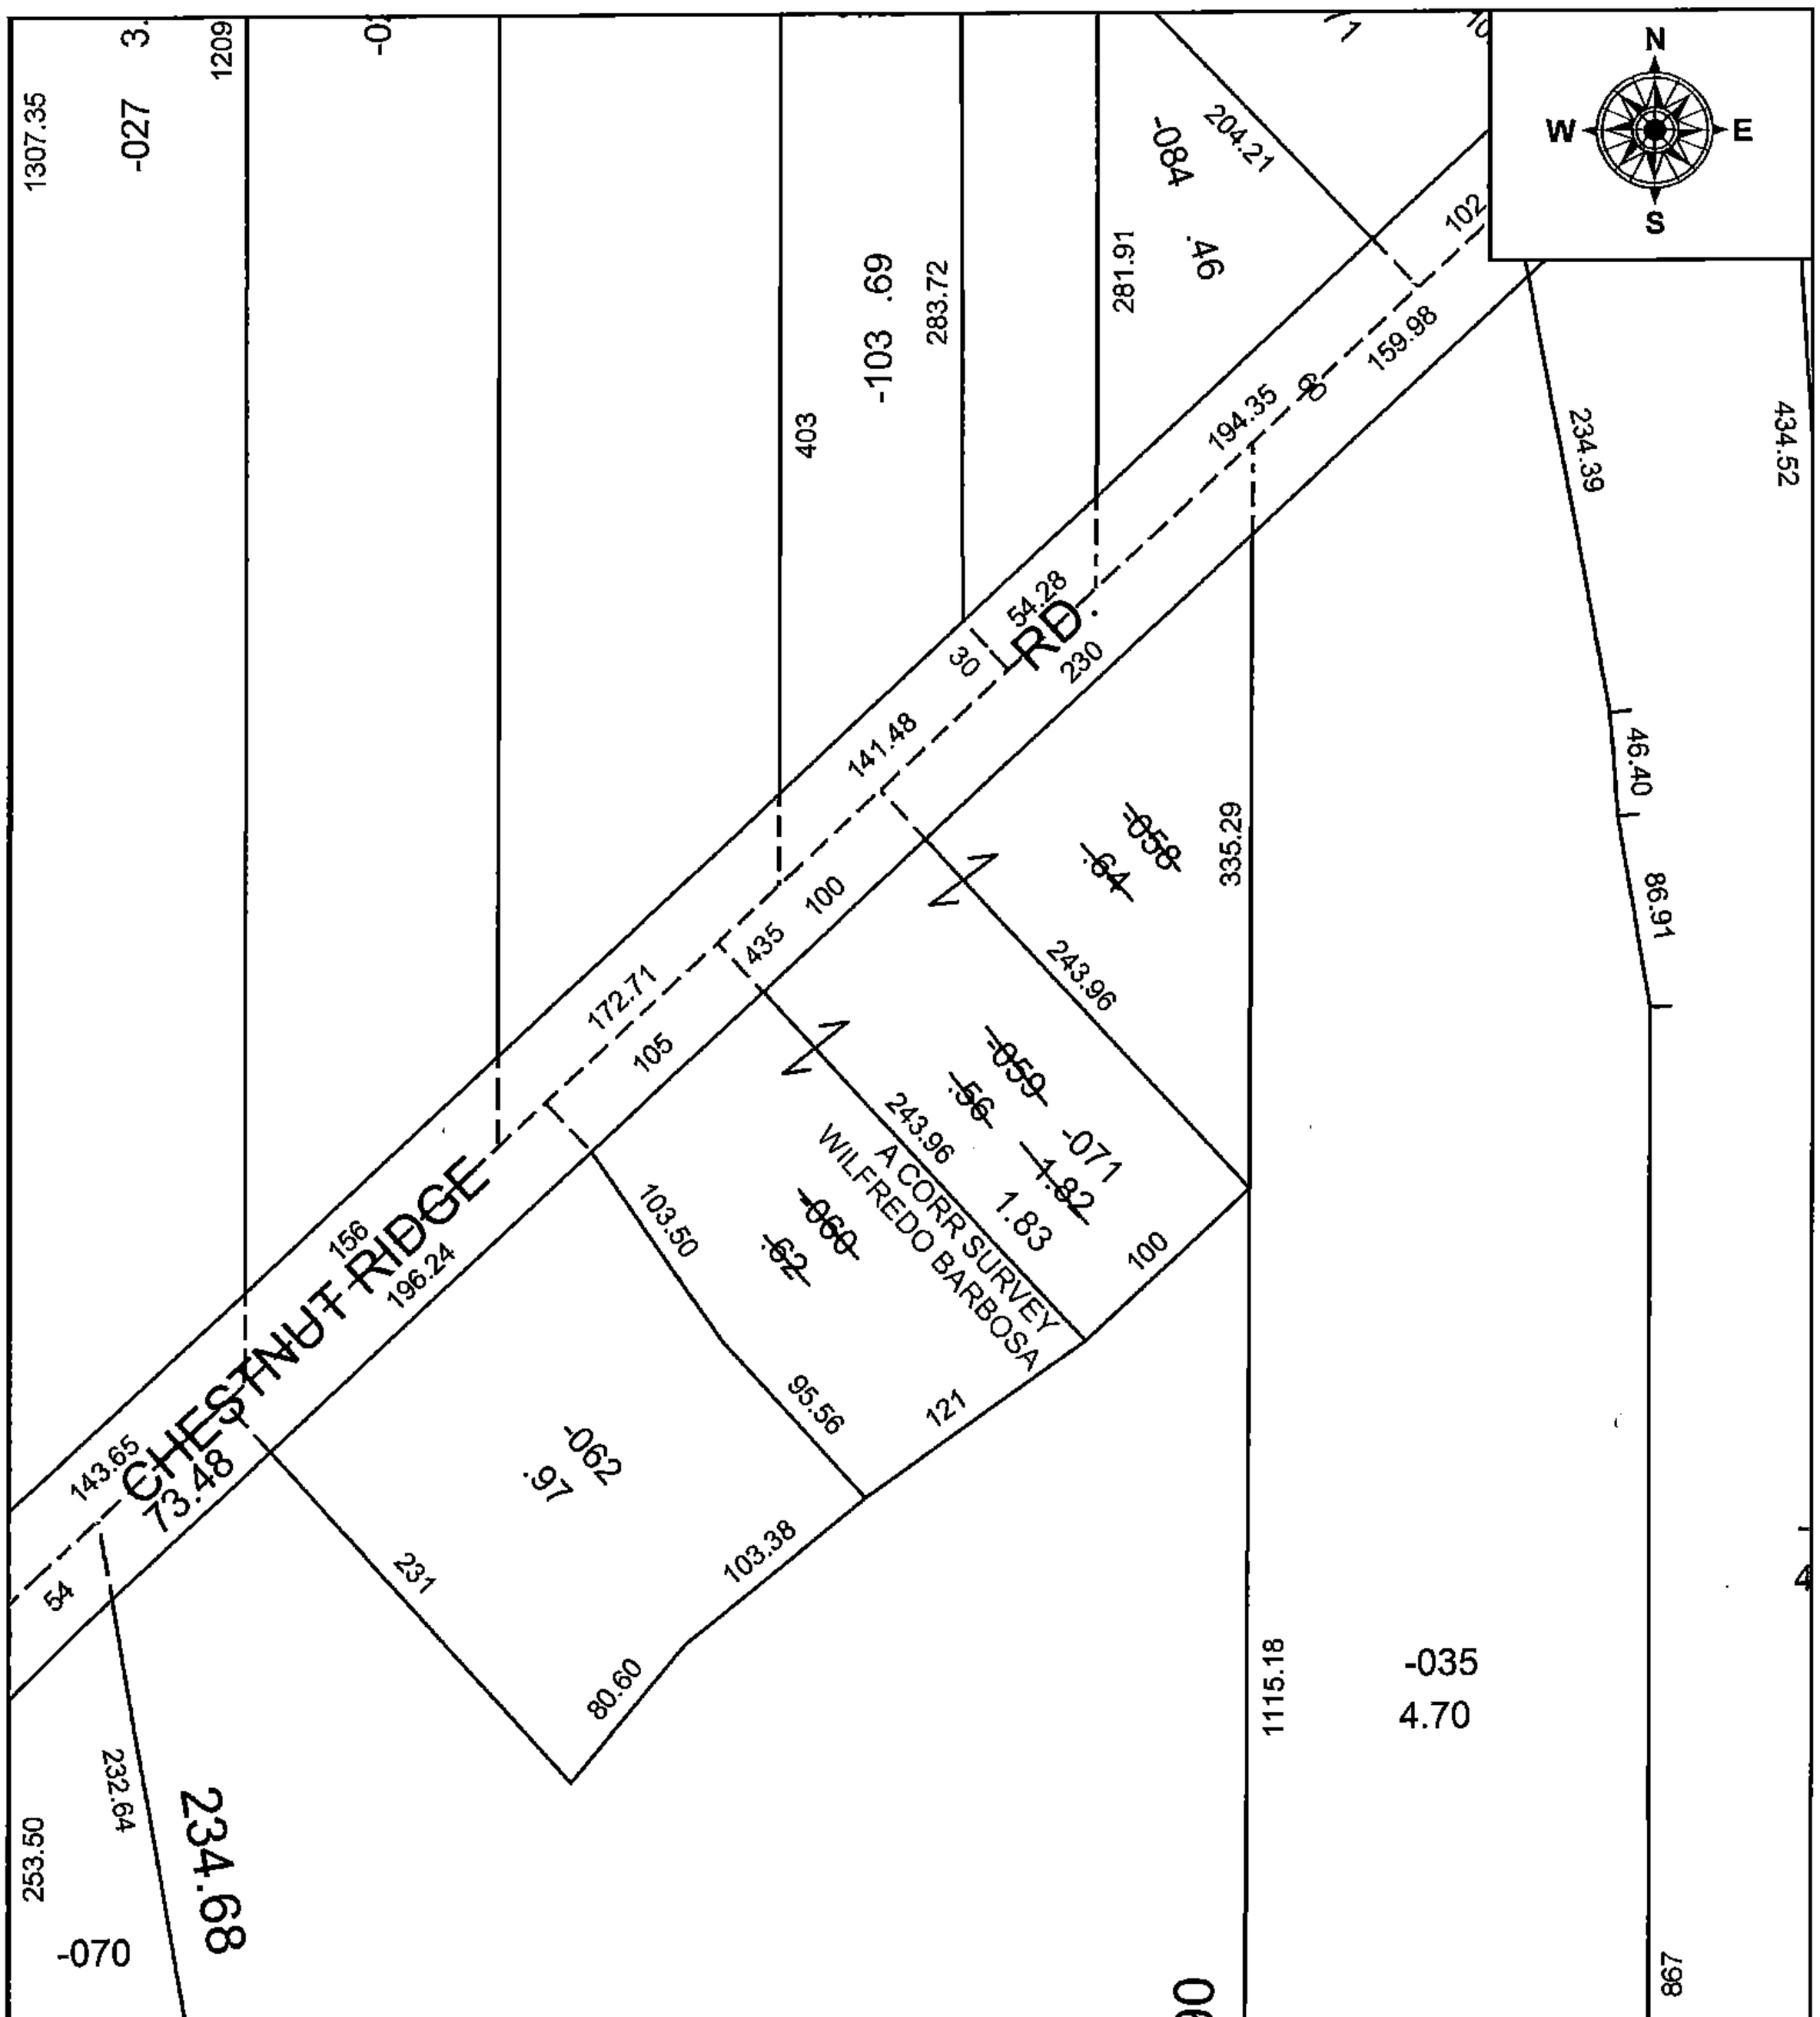

SPLITS/DEEDS PROCESSED

LORAIN COUNTY TAX MAP DEPARTMENT
226 MIDDLE AVE. ELYRIA, OH

SURVEYED BY: WILFREDO BARBOSA
CLOSURE: 1:2798883
MAP PAGE(S): 07-00-023
APPOVED BY: JAH **DATE:** 6/9/2016
SCALE: 1 in = 100 ft **PRIOR INSTRUMENT:** 20150557395