**PARENT PARCEL:** 21-05-029-000-004, -006

**CHILD PARCEL:** 21-05-029-000-018

**STARTING POINT:** SOUTHWEST CORNER OF O.L.29 TR.5

16-03527-C

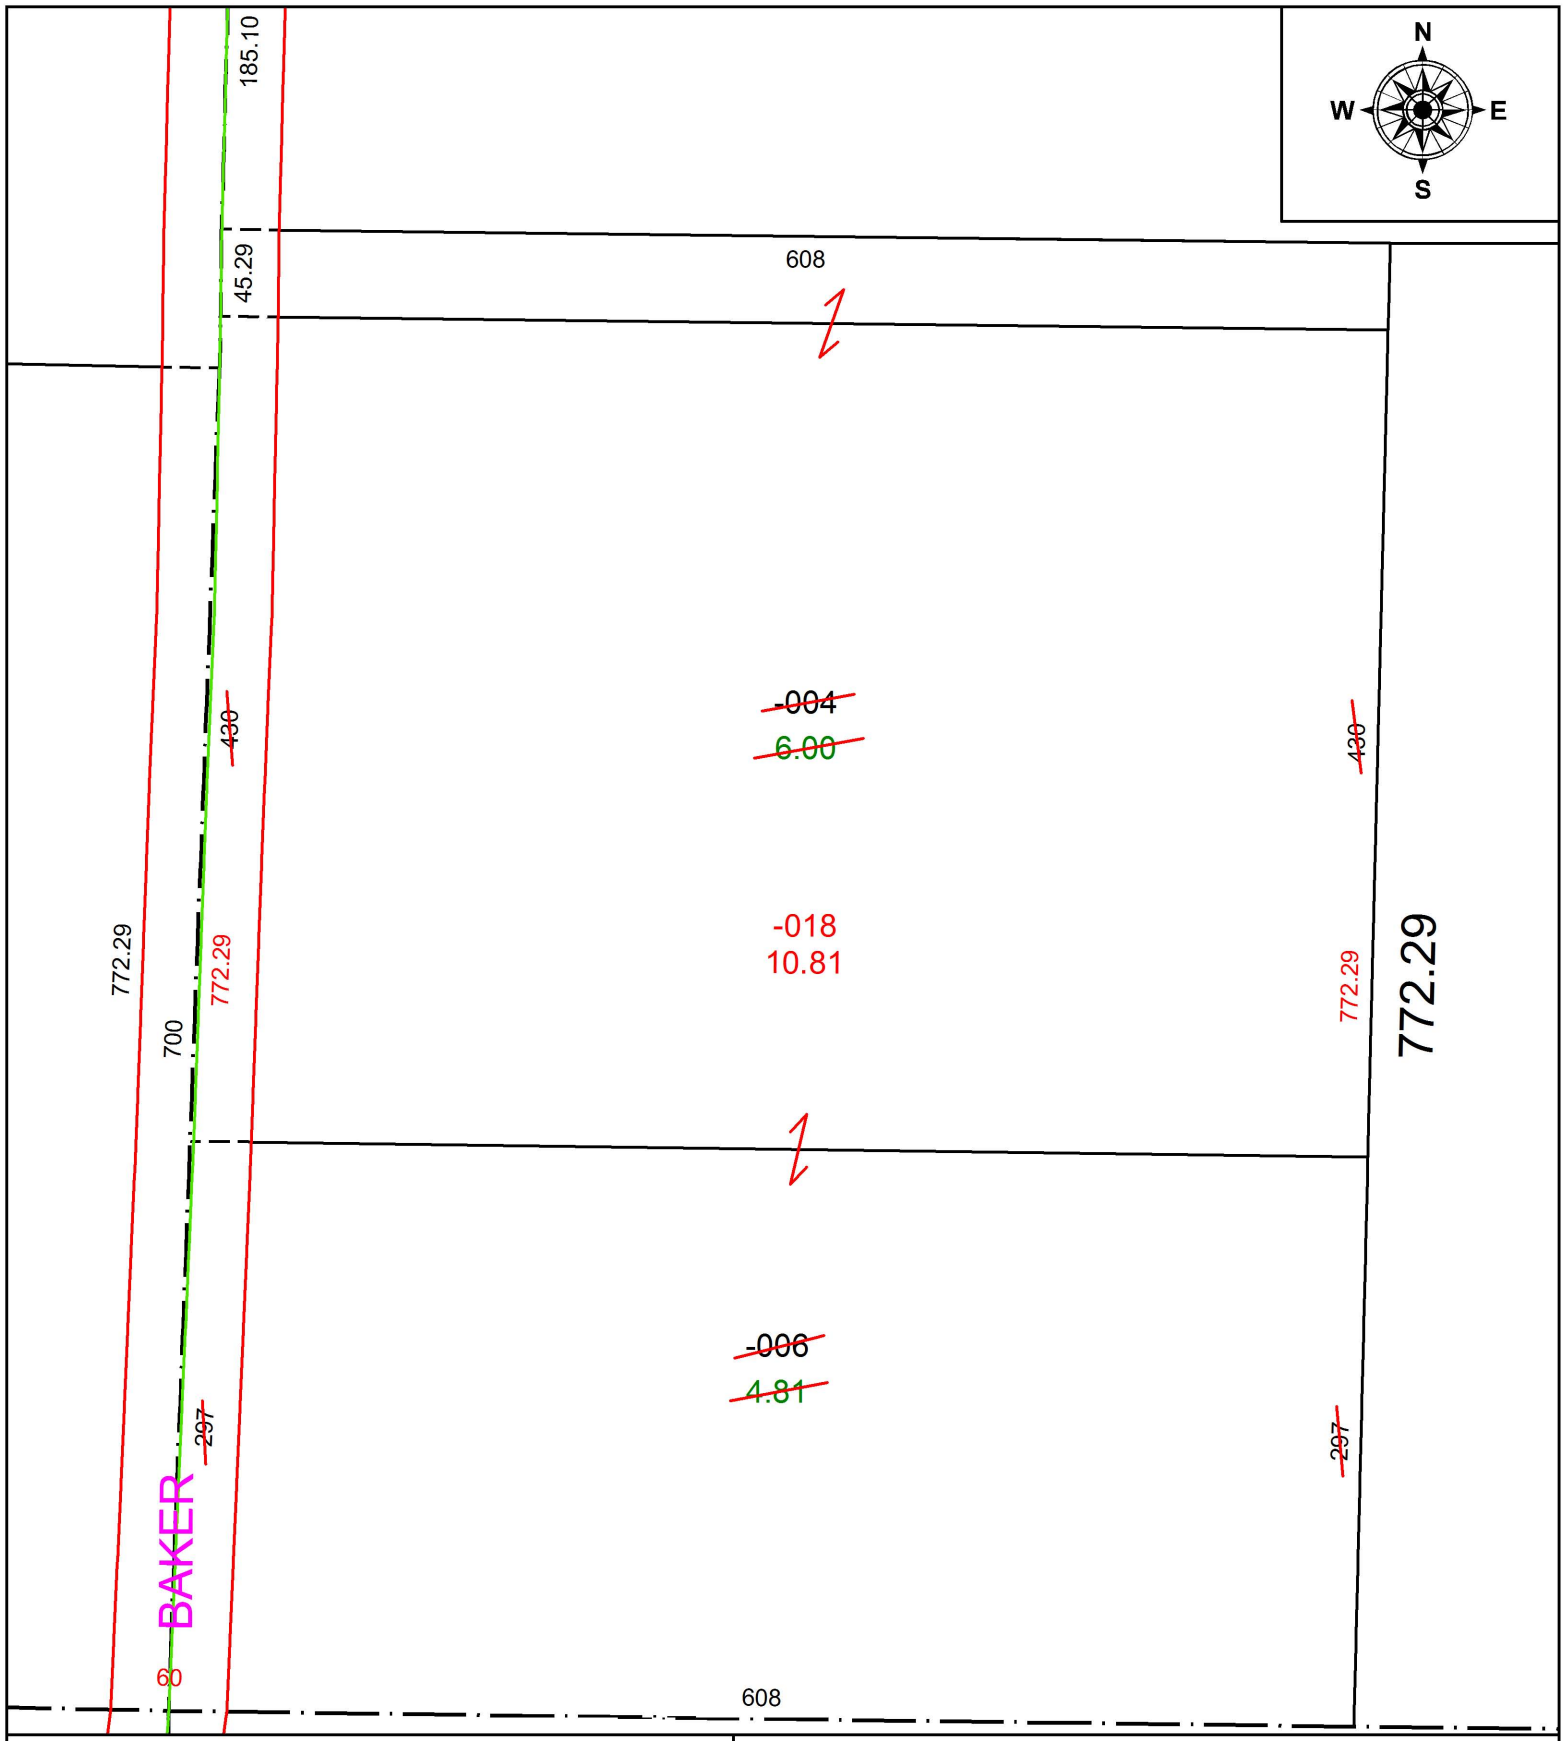


**SPLITS/DEEDS PROCESSED**

LORAIN COUNTY TAX MAP DEPARTMENT
226 MIDDLE AVE. ELYRIA, OH

**SURVEYED BY:** N/A
**CLOSURE:** 1: 2147483648
**MAP PAGE(S):** 21-A
**APPOVED BY:** RRM **DATE:** 9-23-16
**SCALE:** 1" = 100 **PRIOR INSTRUMENT:** 20050072892