PARENT PARCEL: 20-05-017-101-002, 20-05-018-000-010, 20-05-017-102-004

CHILD PARCEL: XX-XX-XXX-XXX-XXX

STARTING POINT: CL OF GRIGGS RD. & WEST LINE OF O.L. 17, TRACT 5

16-03533-C

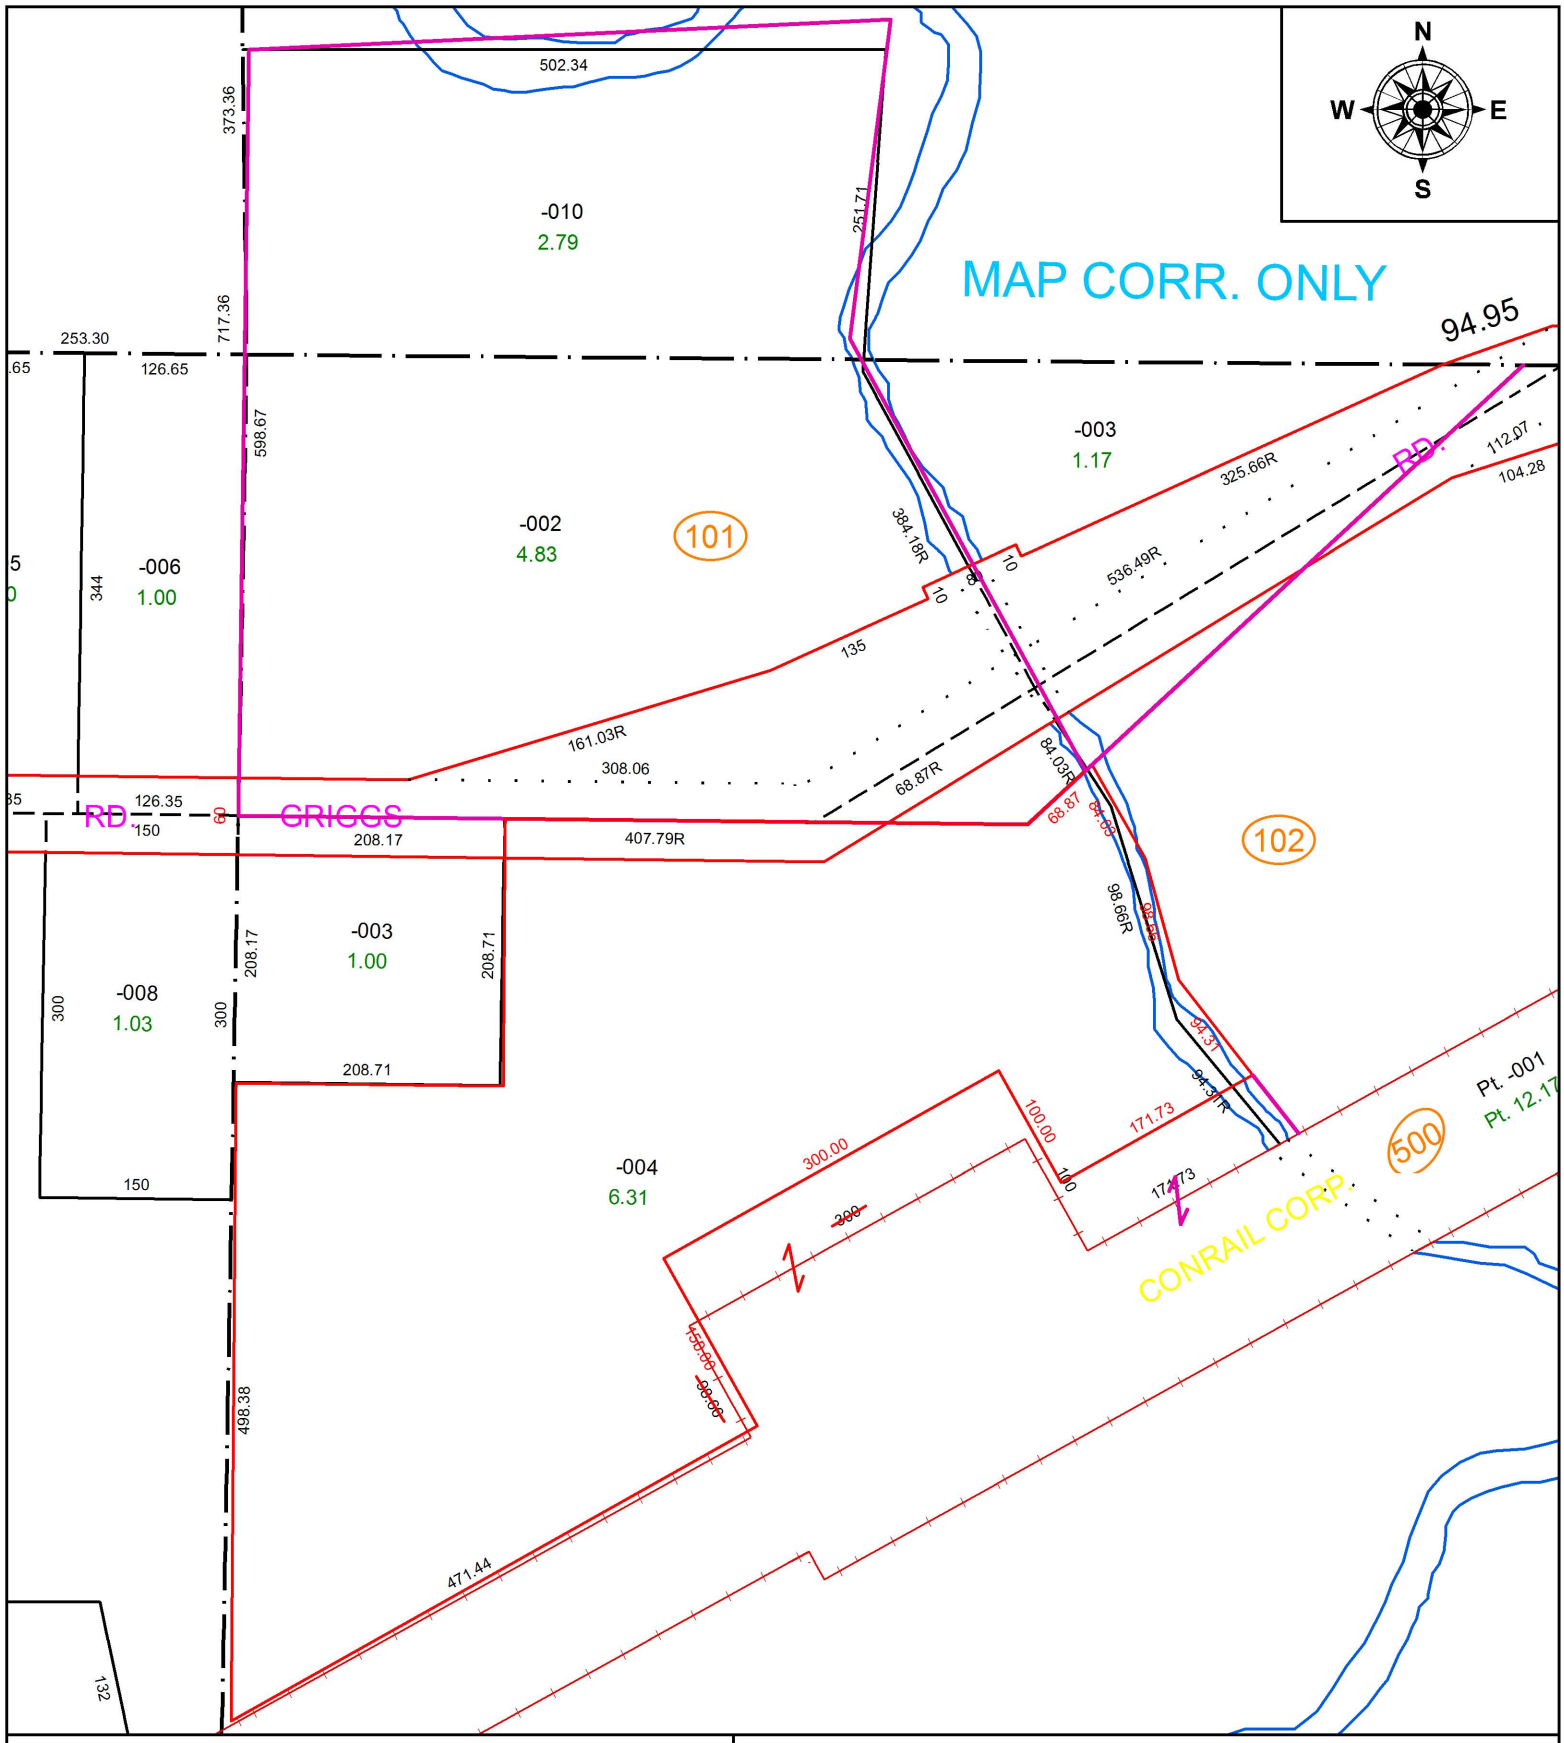

SPLITS/DEEDS PROCESSED

LORAIN COUNTY TAX MAP DEPARTMENT
226 MIDDLE AVE. ELYRIA, OH

SURVEYED BY: DANIEL COOK
CLOSURE: 1: 33,000
MAP PAGE(S): 20-05-017 & -018
APPOVED BY: TJS **DATE:** 12/6/16
SCALE: 1" = 150' **PRIOR INSTRUMENT:** DV XXXX/XXXX