PARENT PARCEL: 11-00-045-000-041
CHILD PARCEL: 11-00-045-000-051, -052
STARTING POINT: CENTERLINE OF ST RT 83 & E. ROYALTON RD

16-03533

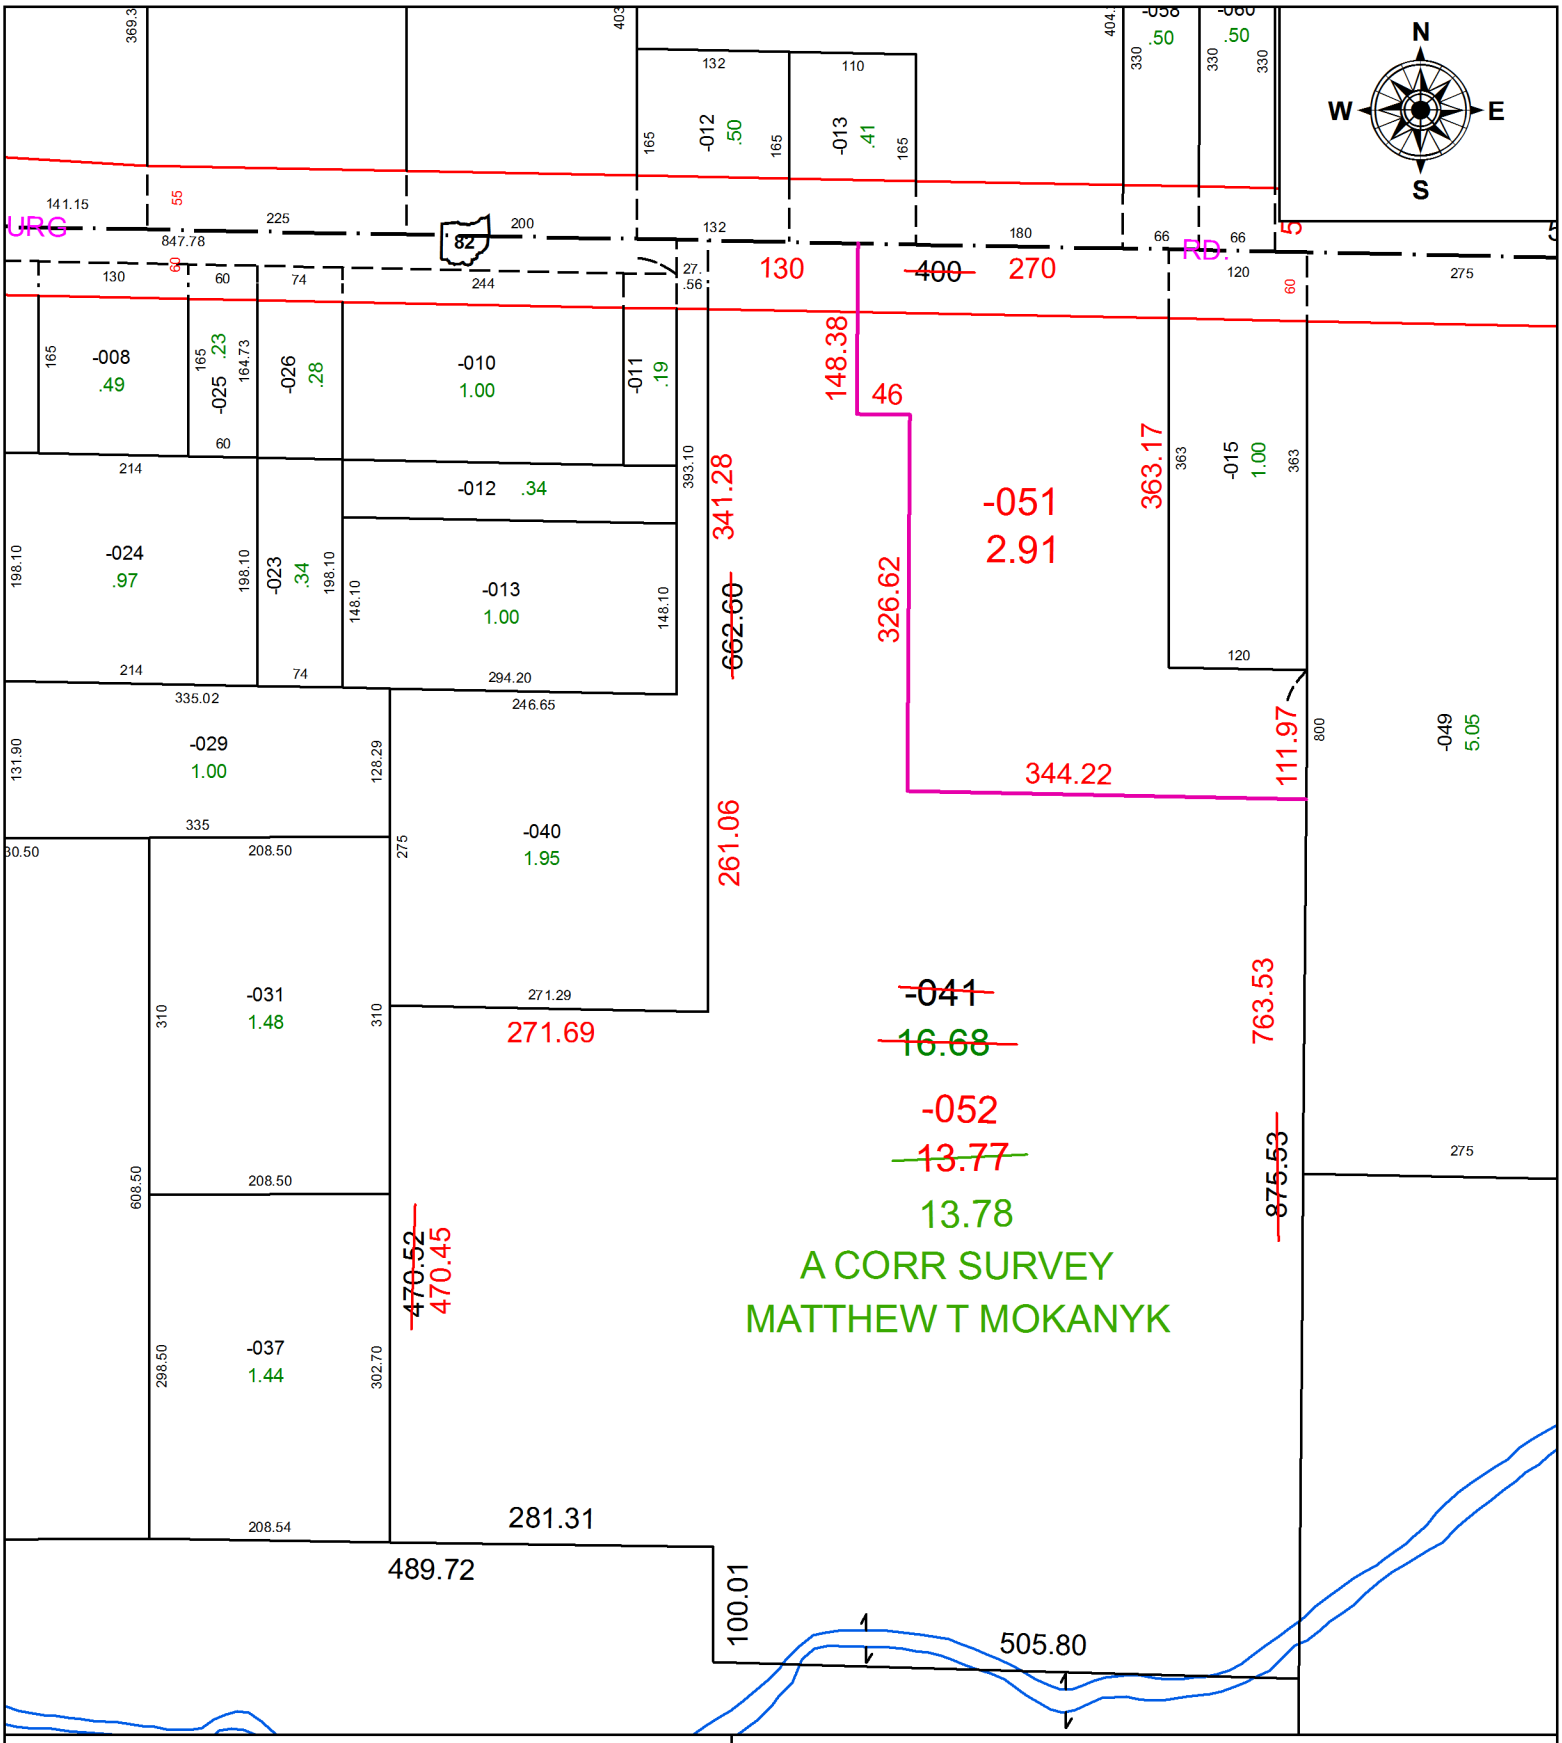

SPLITS/DEEDS PROCESSED
LORAIN COUNTY TAX MAP DEPARTMENT
226 MIDDLE AVE. ELYRIA, OH

SURVEYED BY: MATTHEW MOKANYK
CLOSURE: 1:287202
MAP PAGE(S): 11-00-045
APPOVED BY: JAH **DATE:** 07-01-2016
SCALE: 1 in = 167 ft **PRIOR INSTRUMENT:** DV 415/239