PARENT PARCEL: 05-00-006-000-146
CHILD PARCEL: 05-00-006-000-244, -245
STARTING POINT: SIDLEINE OF TOWER LANE AND MIDDLE RIDGE RD

16-03535

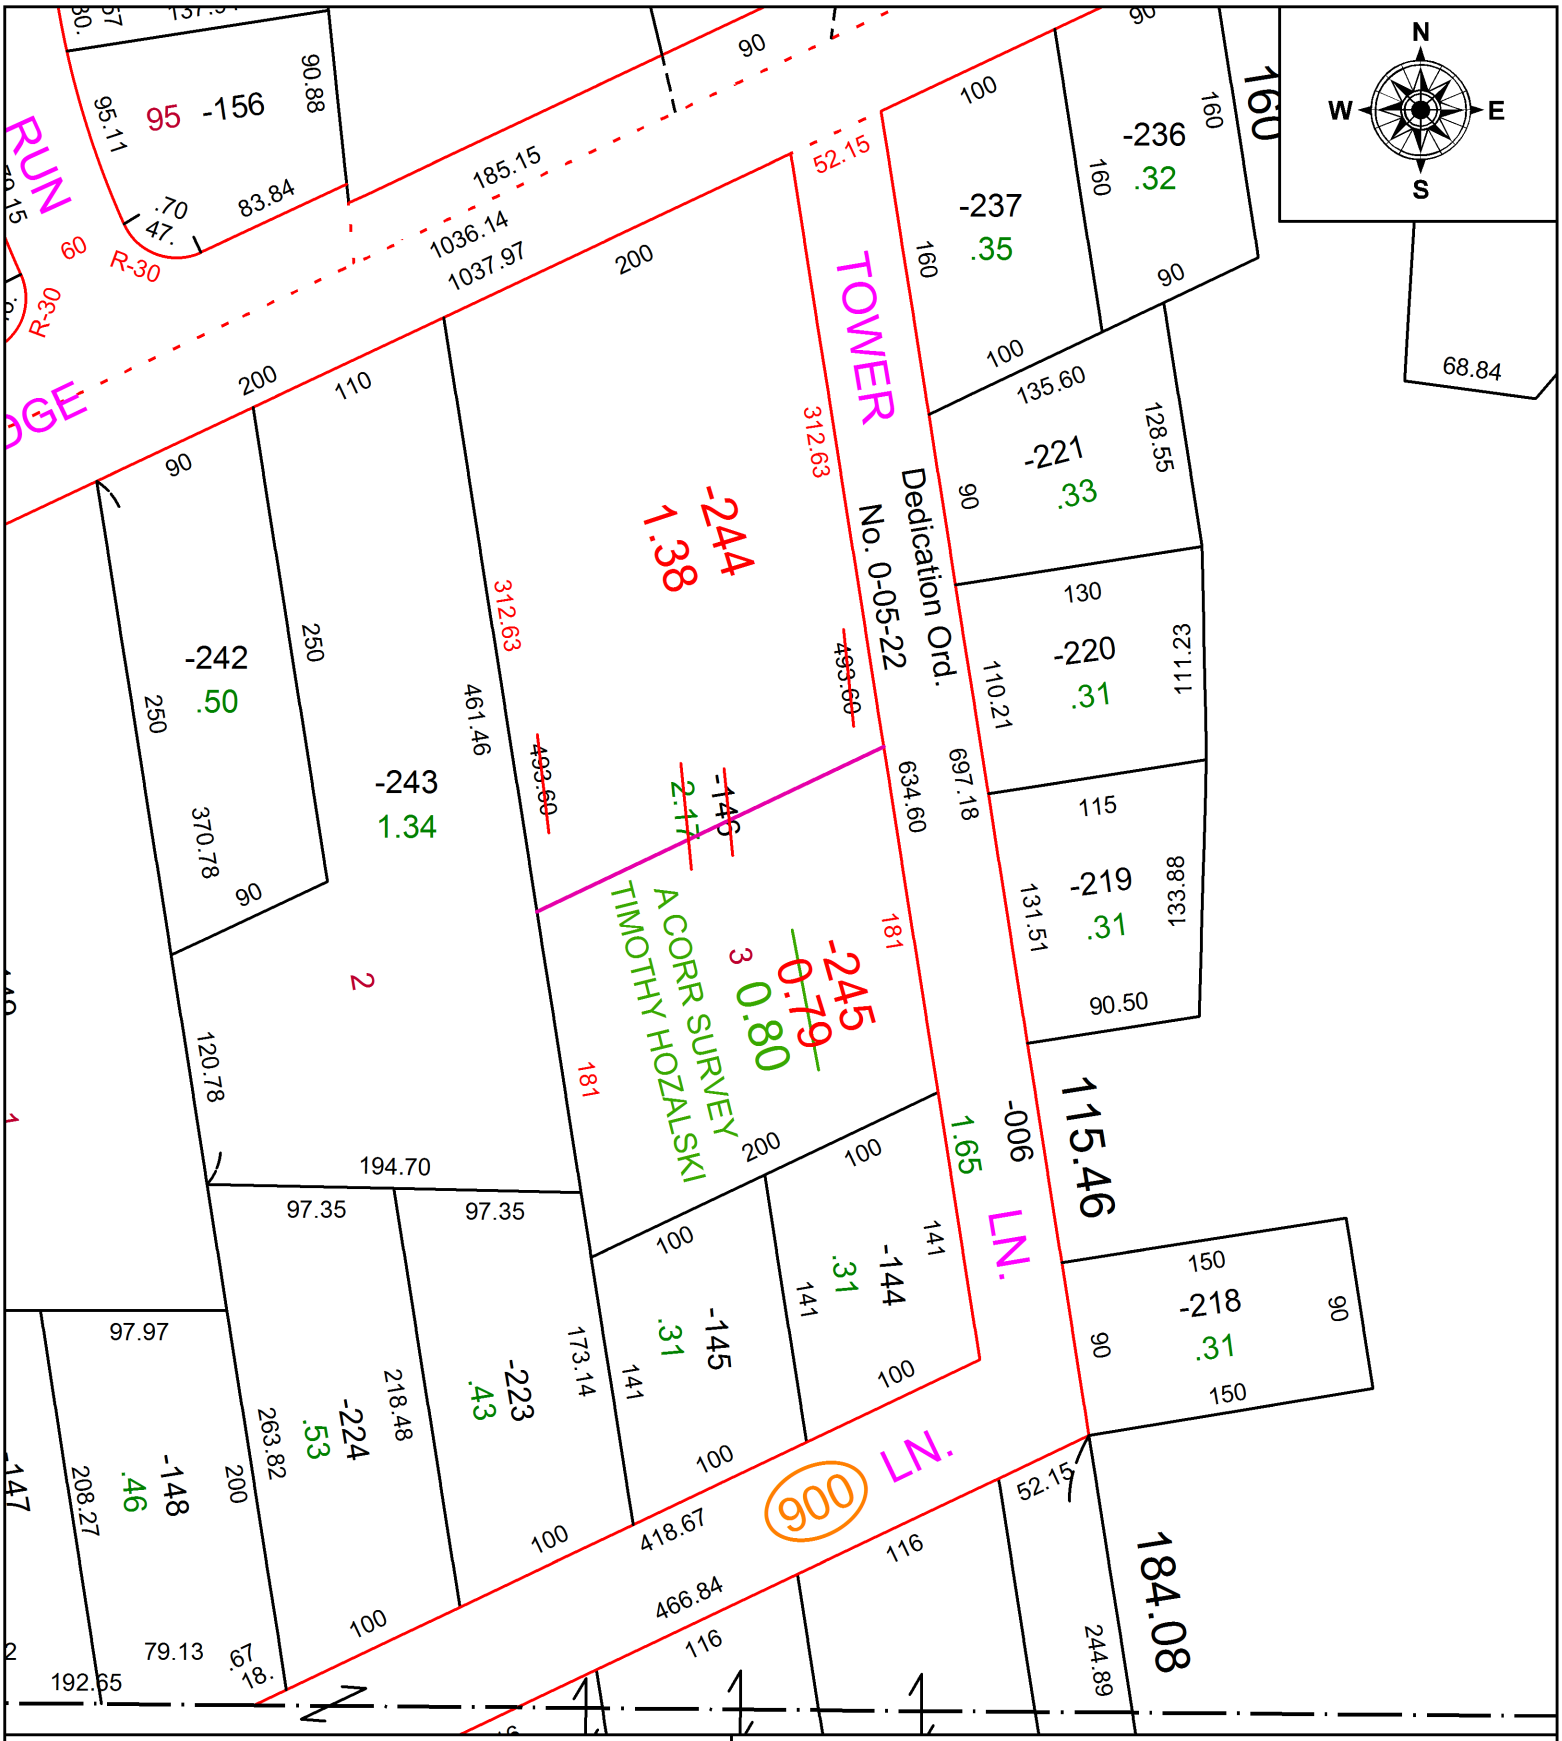

SPLITS/DEEDS PROCESSED
LORAIN COUNTY TAX MAP DEPARTMENT
226 MIDDLE AVE. ELYRIA, OH

SURVEYED BY: TIMOTHY HOZALSKI
CLOSURE: 1:-2147483648
MAP PAGE(S): 05-00-006
APPOVED BY: JAH **DATE:** 7/11/2016
SCALE: 1 in = 100 ft **PRIOR INSTRUMENT:** 20160589121