PARENT PARCEL: 07-00-015-112-002
CHILD PARCEL: XX-XX-XXX-XXX-XXX
STARTING POINT: NORTHEAST CORNER OF LAND CONVEYED TO ARTHUR H. HILL

16-03536-A

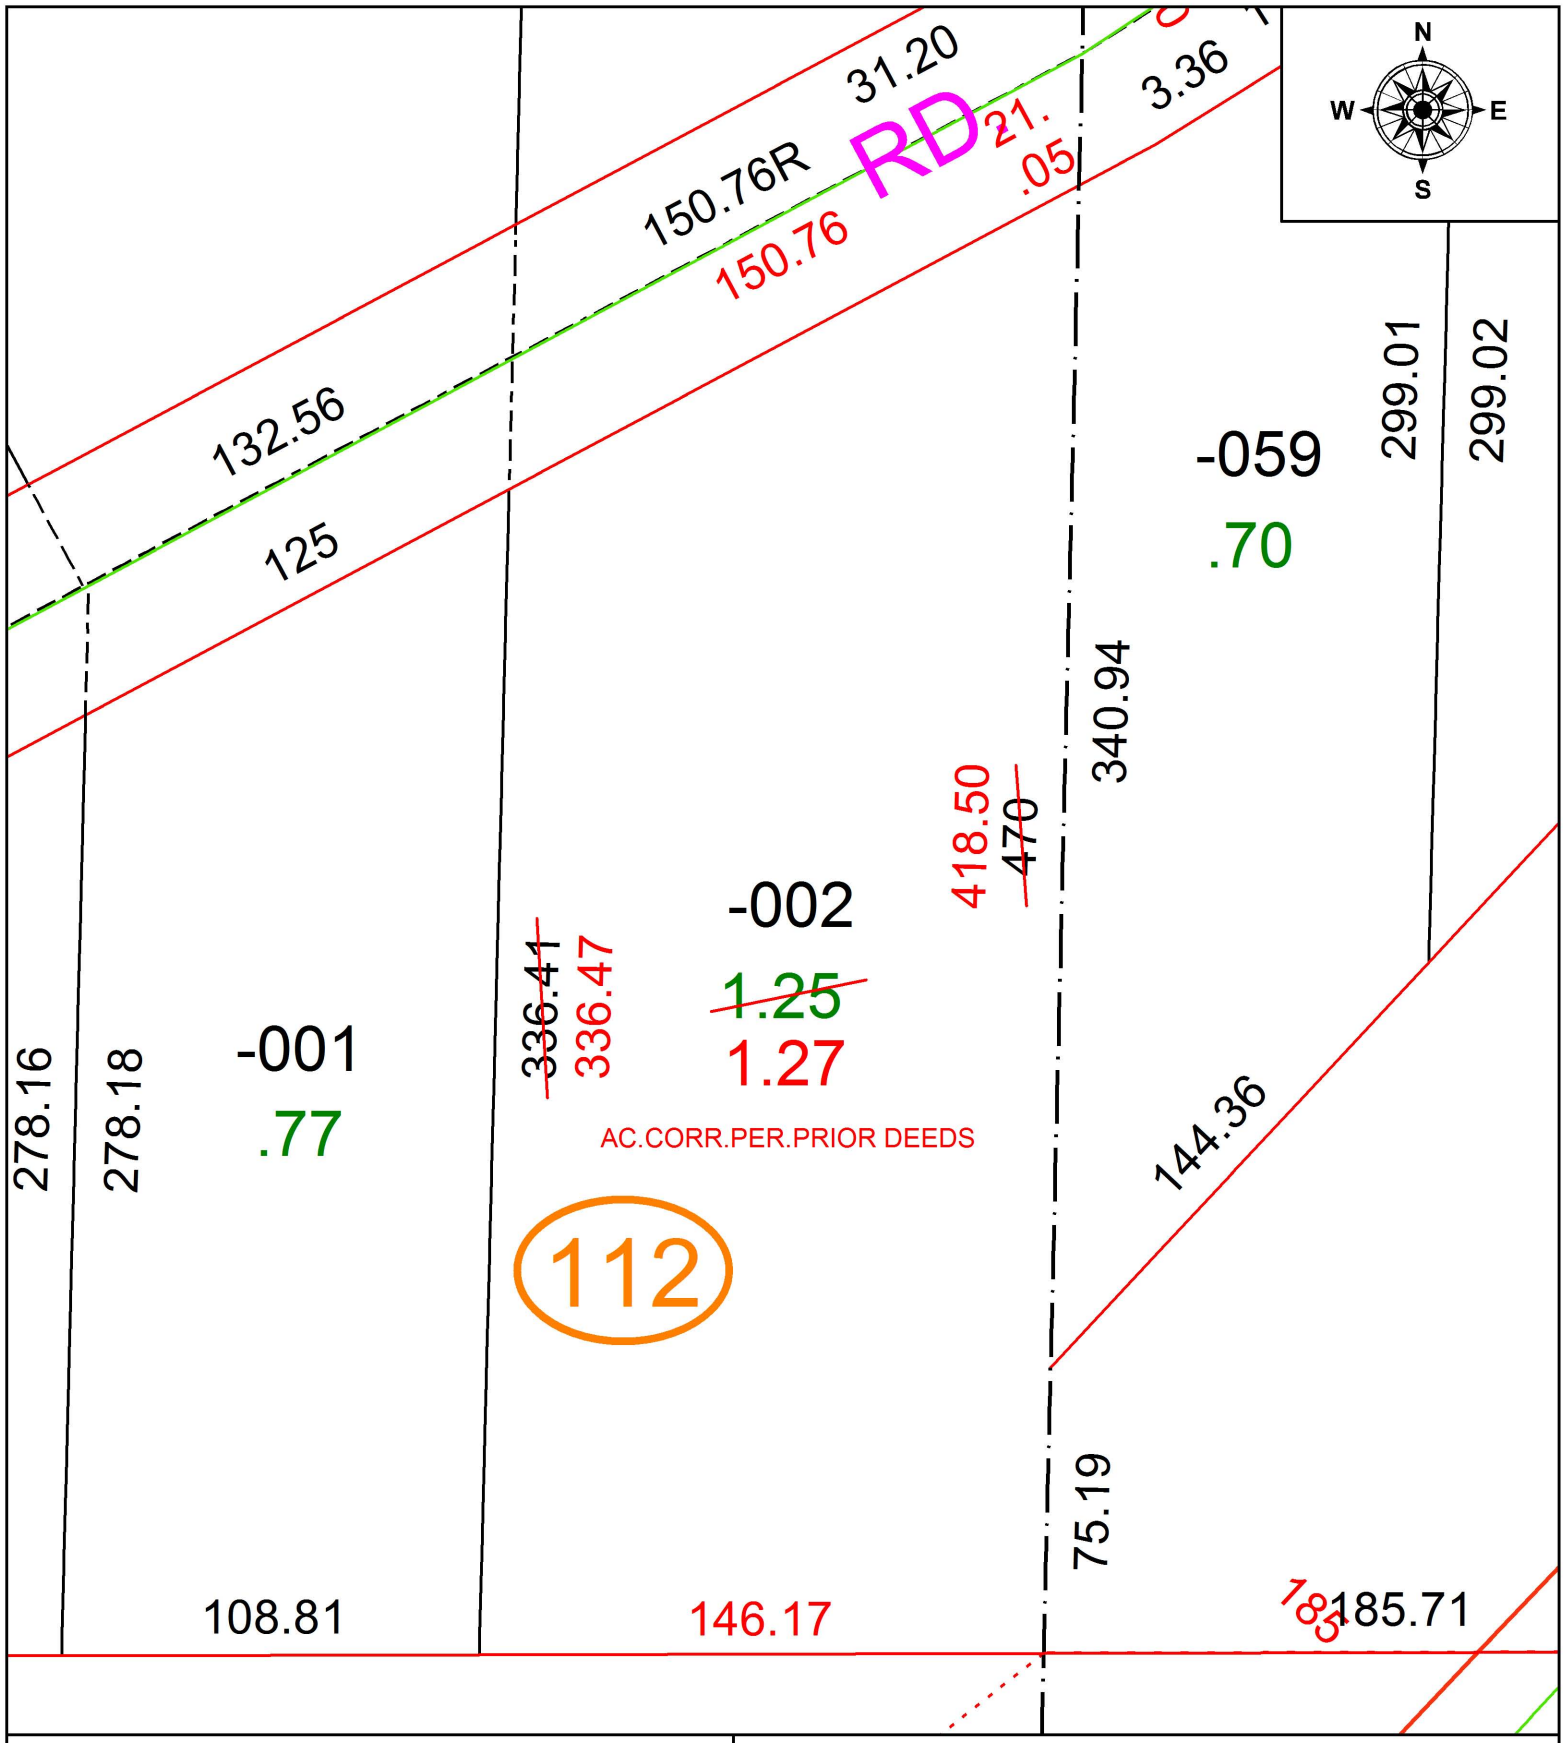

SPLITS/DEEDS PROCESSED
LORAIN COUNTY TAX MAP DEPARTMENT
226 MIDDLE AVE. ELYRIA, OH

SURVEYED BY: N/A
CLOSURE: 1: 78,433
MAP PAGE(S): 7-00-015
APPOVED BY: RRM **DATE:** 10-4-16
SCALE: 1" = 50 **PRIOR INSTRUMENT:** 20050078654