PARENT PARCEL: 09-00-076-101-040, -041
CHILD PARCEL: 09-00-076-101-063, -064, -065
STARTING POINT: CENTERLINE OF NORTH PLEASANT ST & NORTH LINE OF VILLAGE LOT 41

16-03536

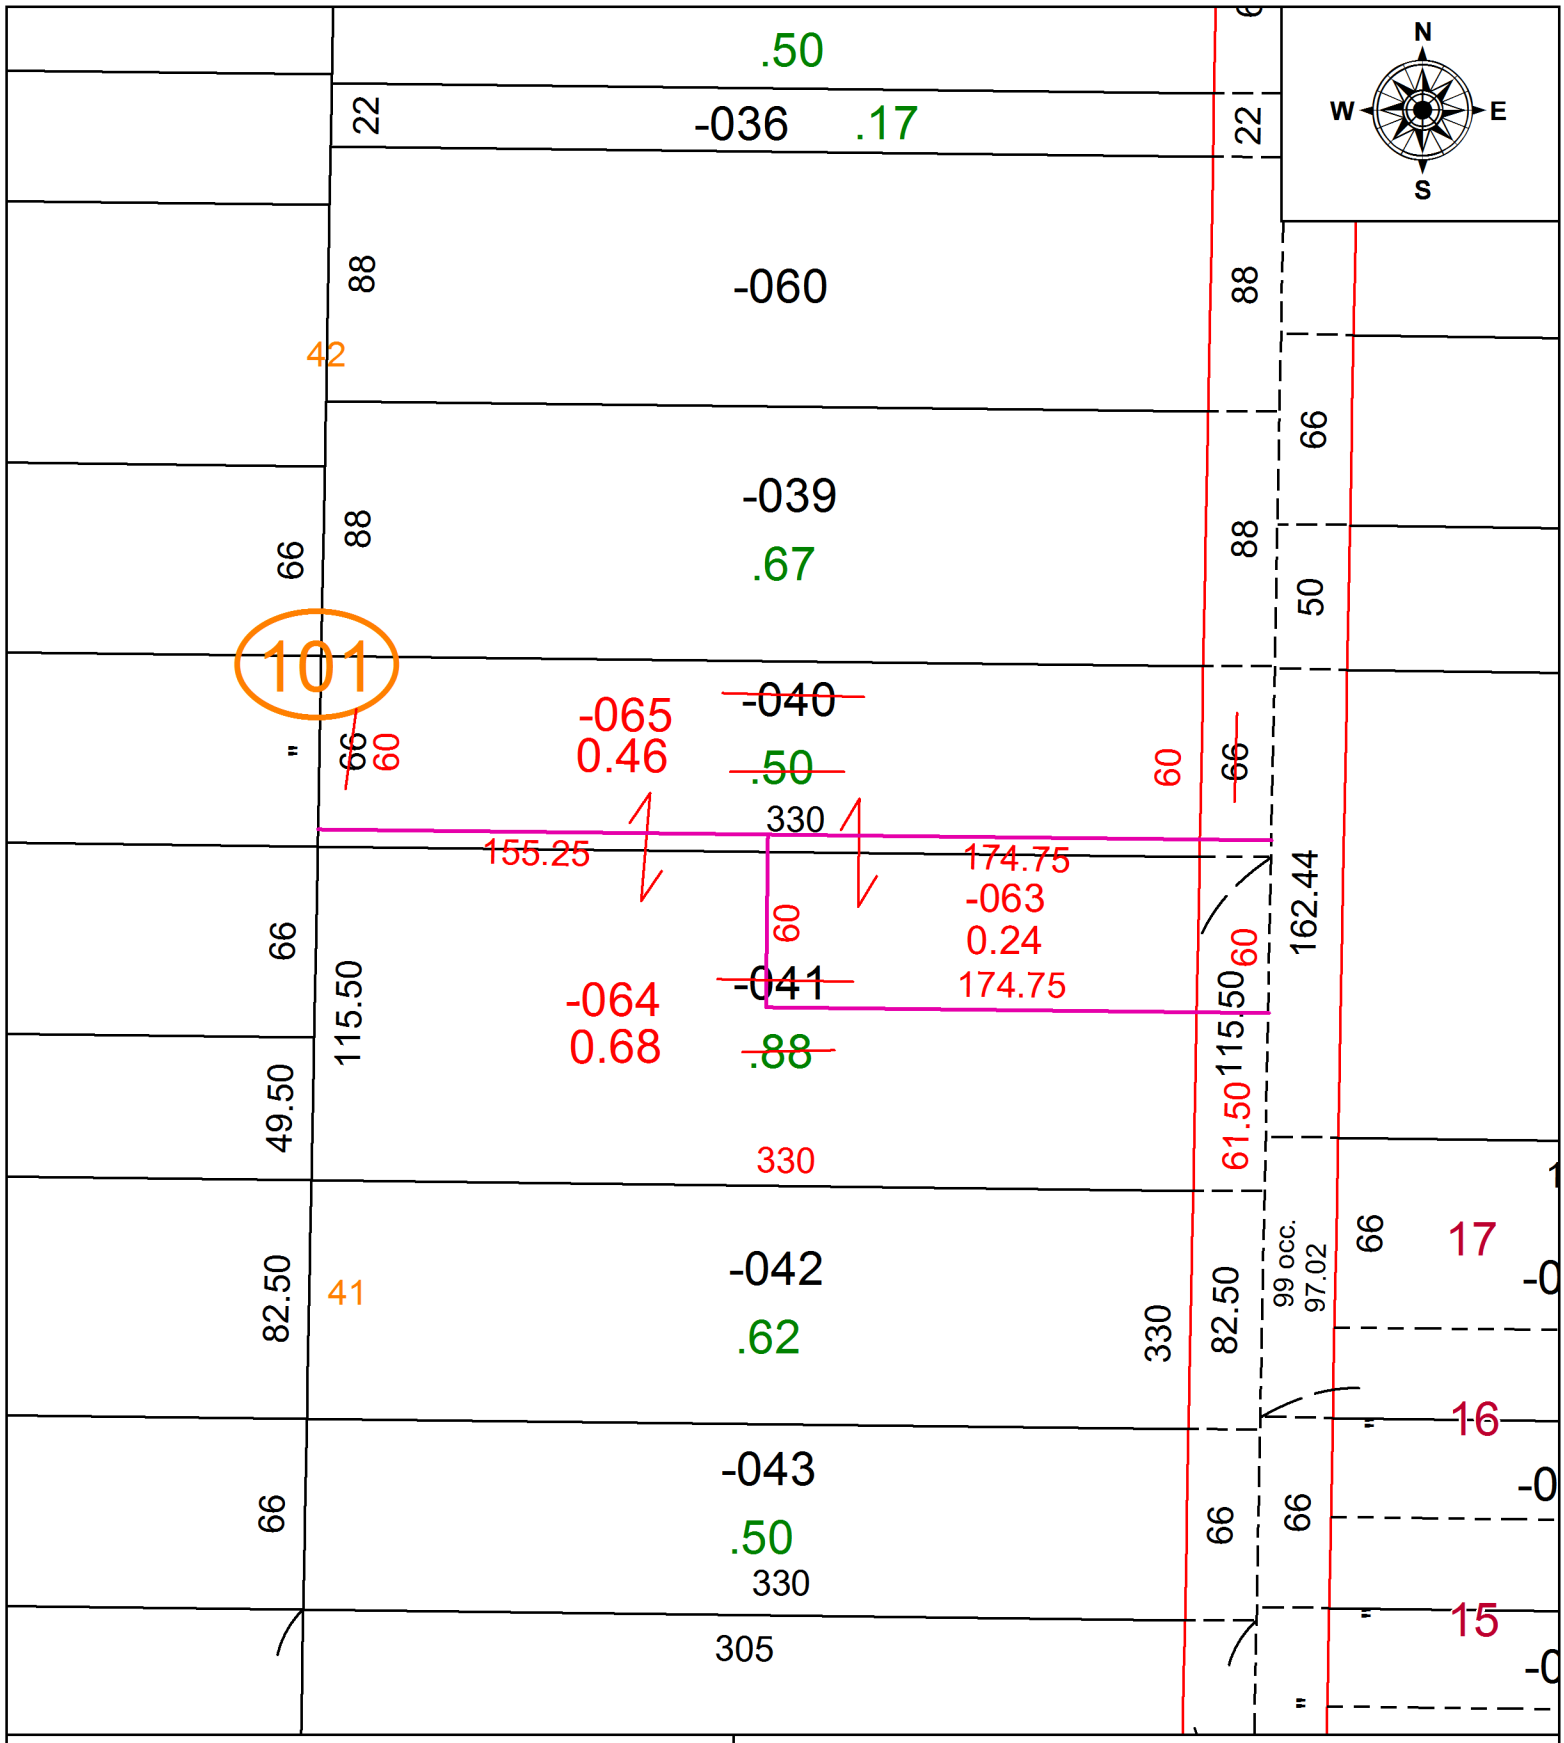

SPLITS/DEEDS PROCESSED
LORAIN COUNTY TAX MAP DEPARTMENT
226 MIDDLE AVE. ELYRIA, OH

SURVEYED BY: JAMES RESAR
CLOSURE: 1:-2147483648
MAP PAGE(S): 09-00-076
APPOVED BY: JAH **DATE:** 07/13/2016
SCALE: 1 in = 67 ft **PRIOR INSTRUMENT:** 20150532805