PARENT PARCEL: 06-24-085-104-036 & -037
CHILD PARCEL: XX-XX-XXX-XXX-XXX
STARTING POINT: S.W. CORNER OF S/L 38 IN C.A. & FRANK BRONSON'S 2ND ADDITION

16-03539-C

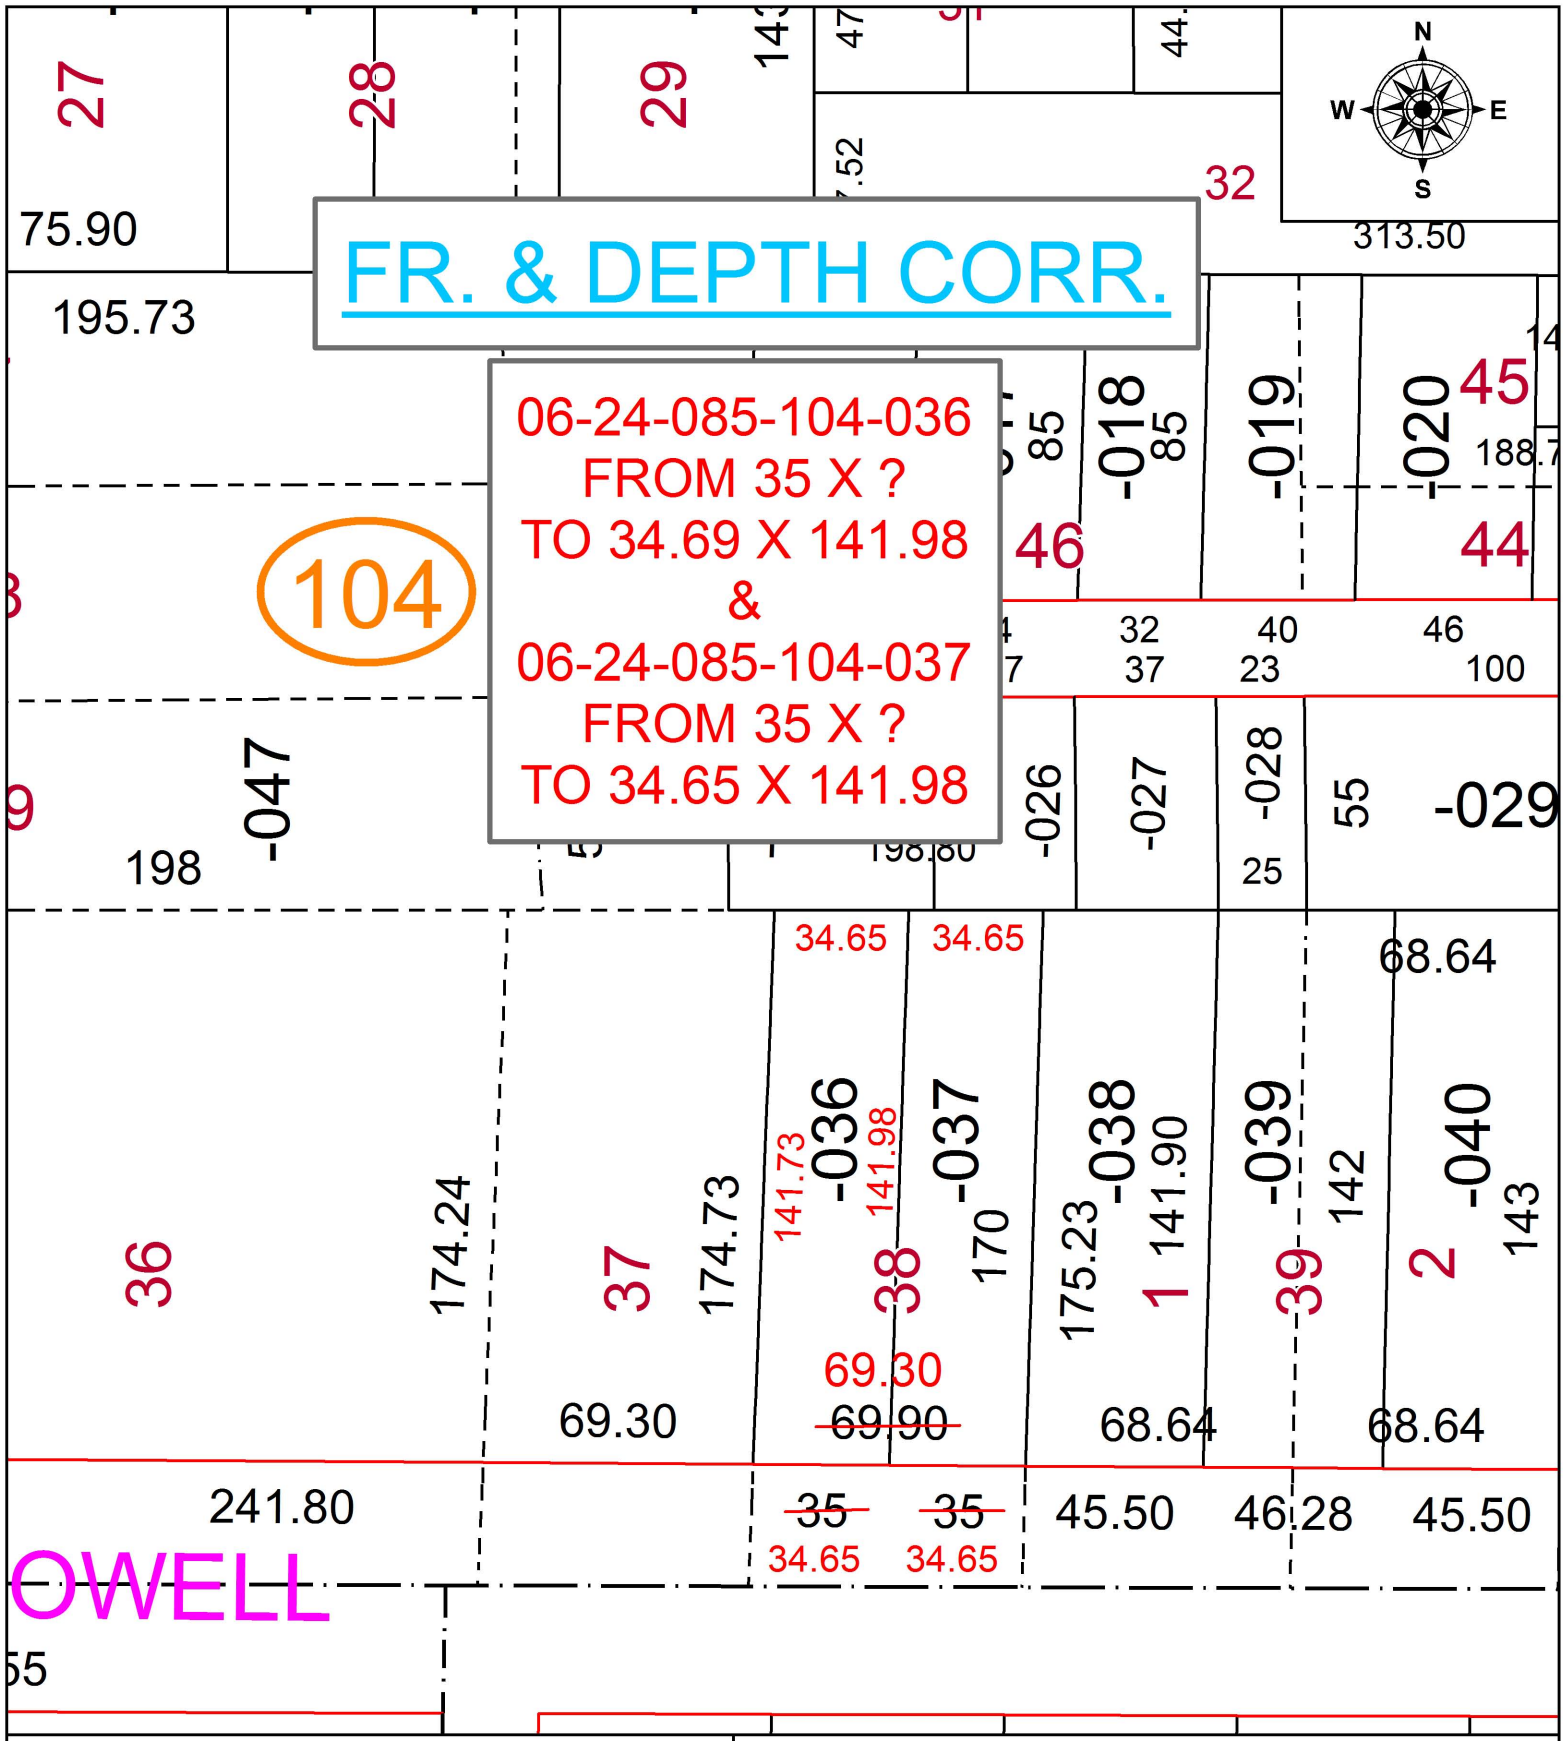

SPLITS/DEEDS PROCESSED
LORAIN COUNTY TAX MAP DEPARTMENT
226 MIDDLE AVE. ELYRIA, OH

SURVEYED BY: LAUNDON, SIMON, CAHL
CLOSURE: 0.01 : 10,000
MAP PAGE(S): 06-24-085
APPOVED BY: TJS **DATE:** 10/12/16
SCALE: 1" = 200 **PRIOR INSTRUMENT:** 2003-0894128