PARENT PARCEL: ADD TO DUP LAND LEASE

CHILD PARCEL: 04-00-030-640-019

STARTING POINT: EASTERLY LINE OF LAKE BREEZE ALLOTMENT & CL OF LAKE RD

16-03540

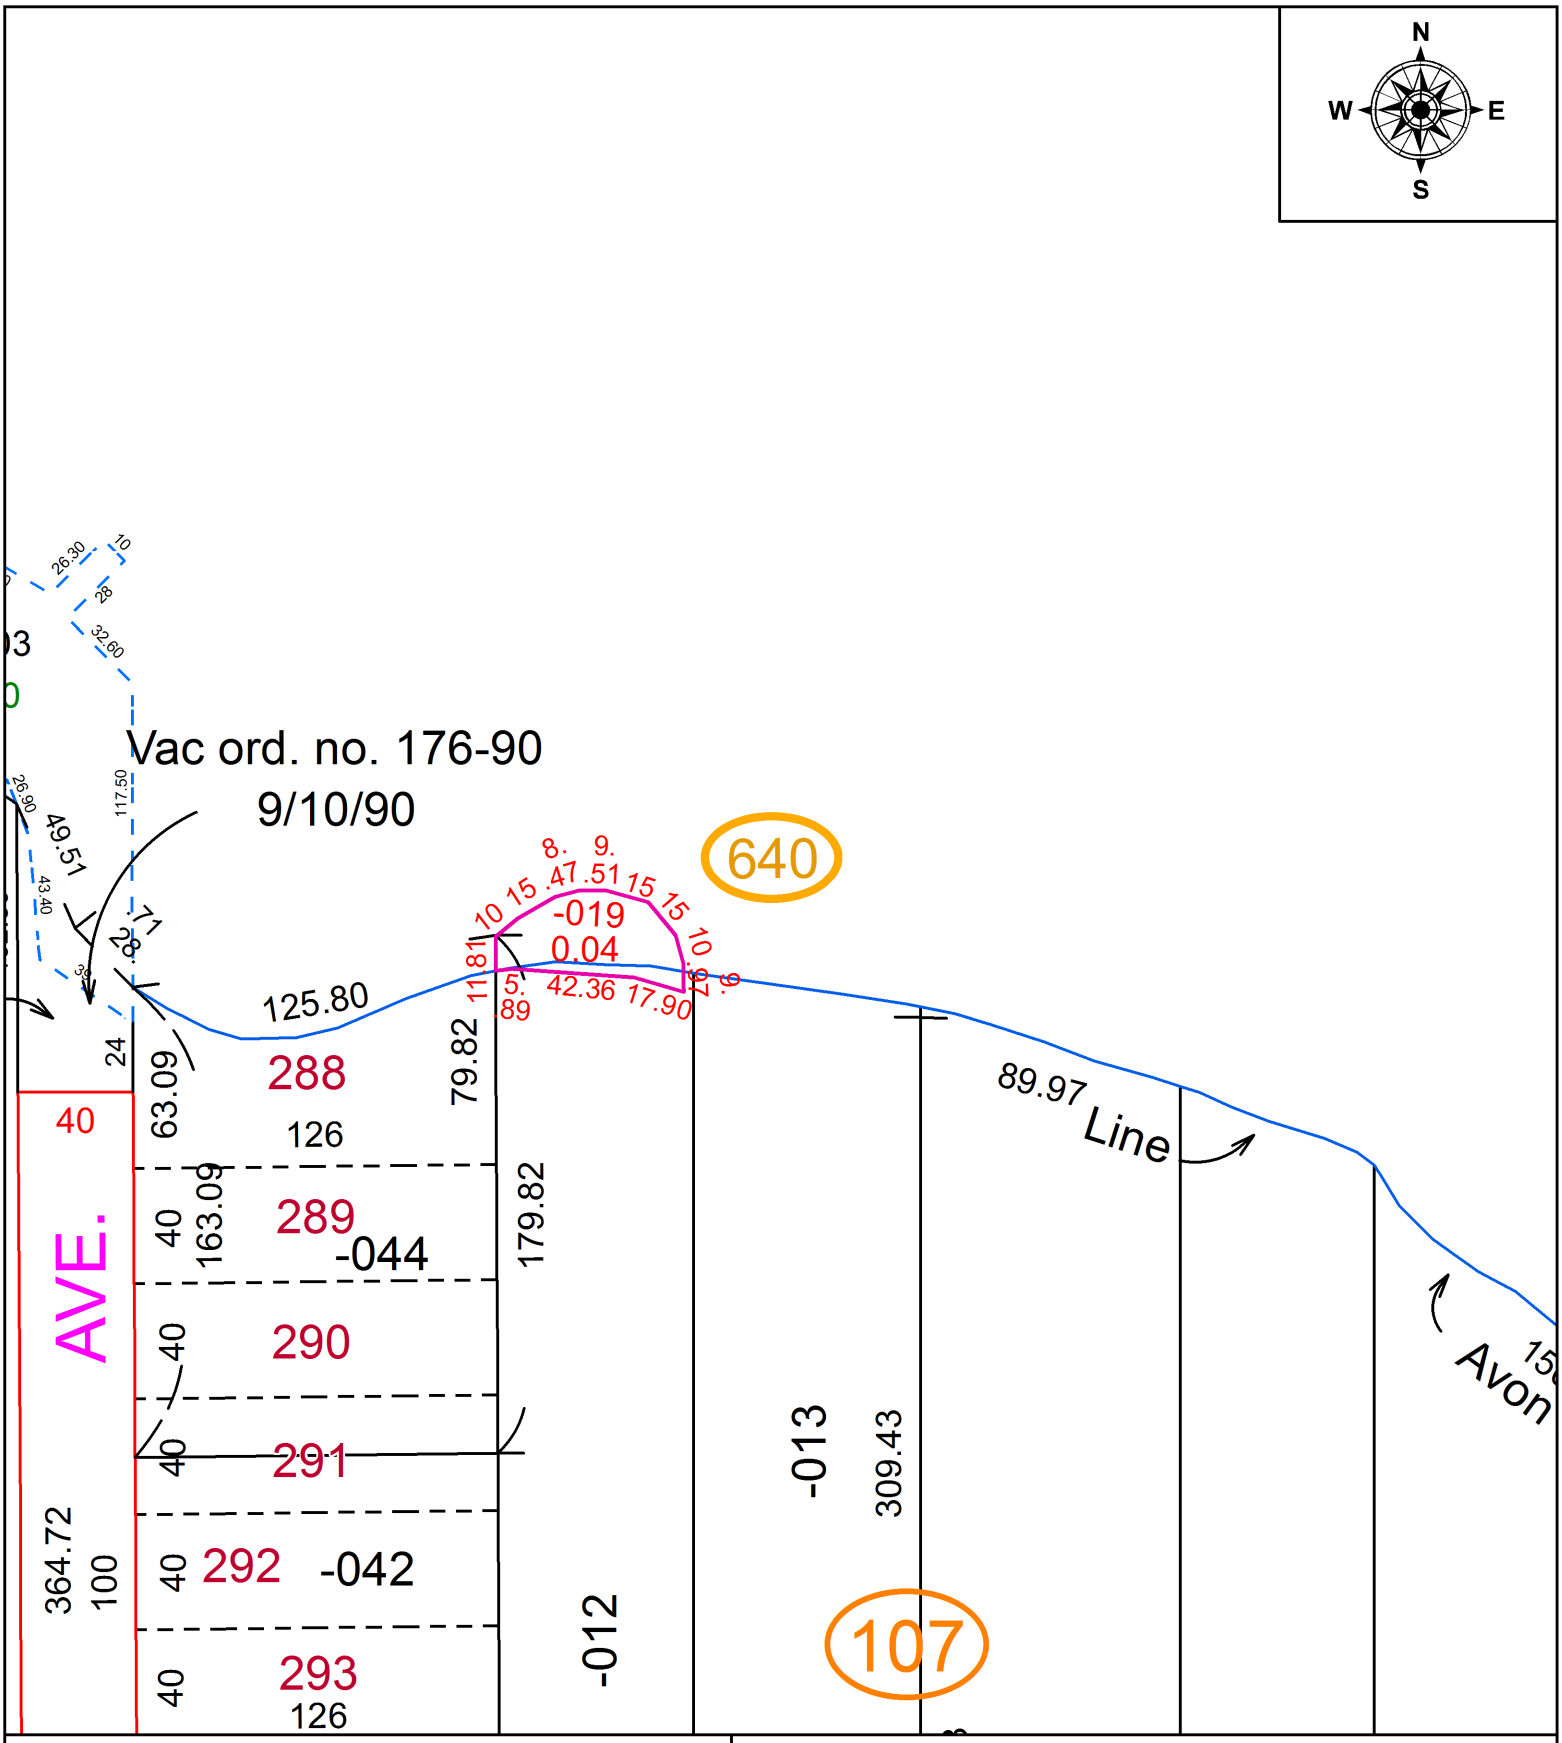

SPLITS/DEEDS PROCESSED

LORAIN COUNTY TAX MAP DEPARTMENT
226 MIDDLE AVE. ELYRIA, OH

SURVEYED BY: THOMAS SNEZEK
CLOSURE: 1:19346
MAP PAGE(S): 04-00-030
APPOVED BY: JAH **DATE:** 7/19/2016
SCALE: 1 in = 67 ft **PRIOR INSTRUMENT:** 20140497668