PARENT PARCEL: 07-00-014-101-005, -006

CHILD PARCEL: 07-00-014-101-039

STARTING POINT: MOST EASTERLY CORNER OF LAND CONVEYED TO DEWEY WORCESTER (DV 284/232)

16-03541-C

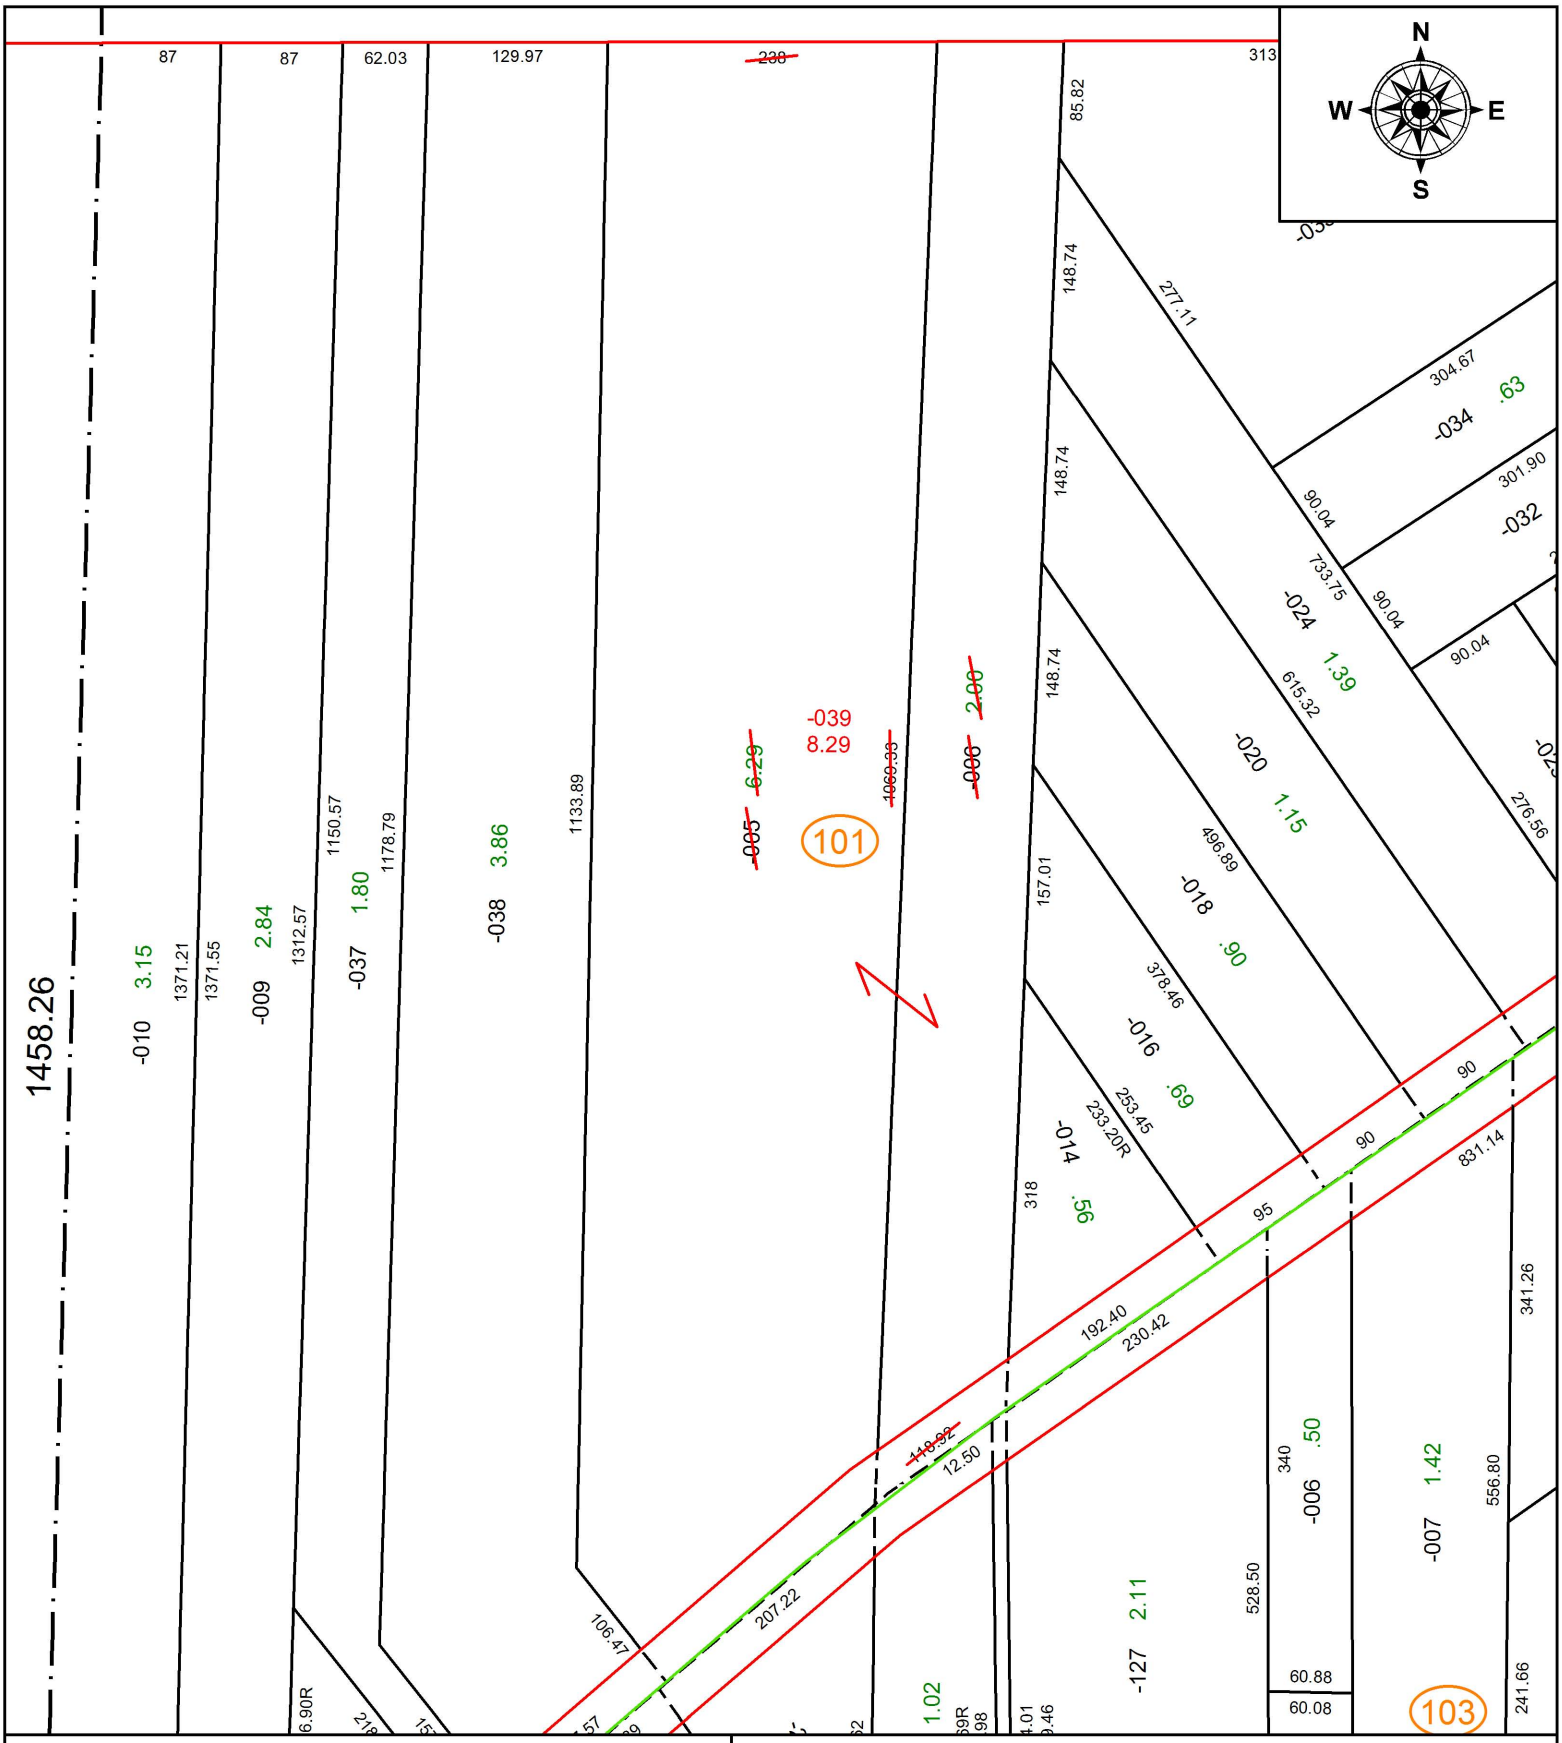

SPLITS/DEEDS PROCESSED

LORAIN COUNTY TAX MAP DEPARTMENT
226 MIDDLE AVE. ELYRIA, OH

SURVEYED BY: N/A

CLOSURE: N/A

MAP PAGE(S): 7-00-014

APPOVED BY: RRM **DATE:** 10-14-16

SCALE: 1" = 140 **PRIOR INSTRUMENT:** 20160593456