PARENT PARCEL: 05-00-022-106-020
CHILD PARCEL: XX-XX-XXX-XXX-XXX
STARTING POINT: NORTHWEST CORNER OF S/L 1 IN RAINBOW DRIVE SUB. NO.1

16-03544-D

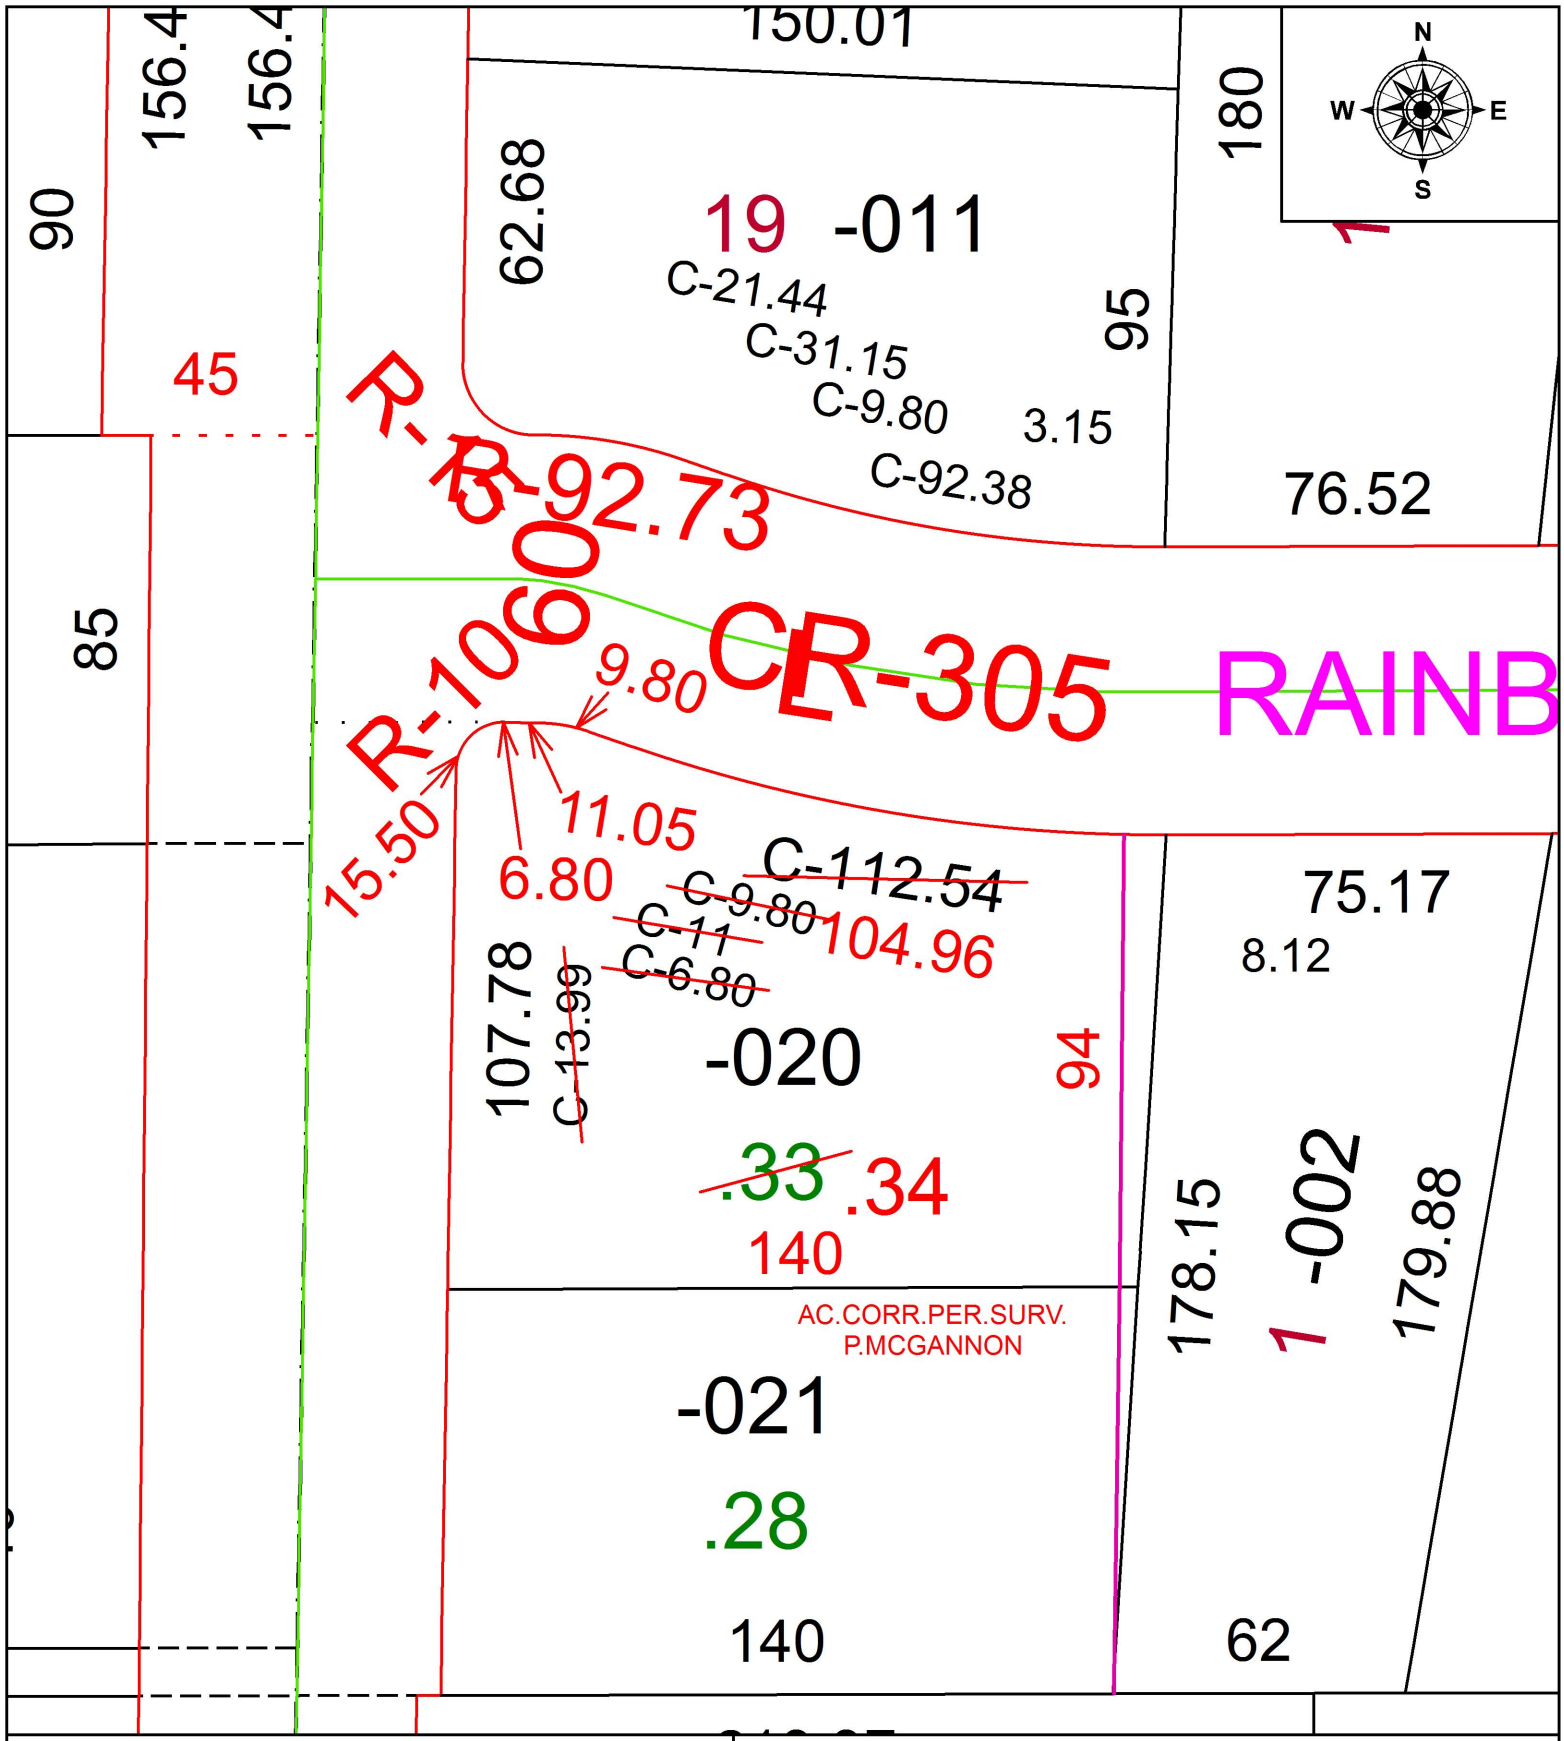

SPLITS/DEEDS PROCESSED
LORAIN COUNTY TAX MAP DEPARTMENT
226 MIDDLE AVE. ELYRIA, OH

SURVEYED BY: PATRICK A. MCGANNON
CLOSURE: 1: 120,389
MAP PAGE(S): 5-00-022
APPOVED BY: RRM **DATE:** 10-21-16
SCALE: 1" = 40 **PRIOR INSTRUMENT:** 20150555380