PARENT PARCEL: 09-00-004-101-054, -055

CHILD PARCEL: 09-00-004-101-057

STARTING POINT: CENTERLINE OF ANNIS RD & O.L. 4

16-03546

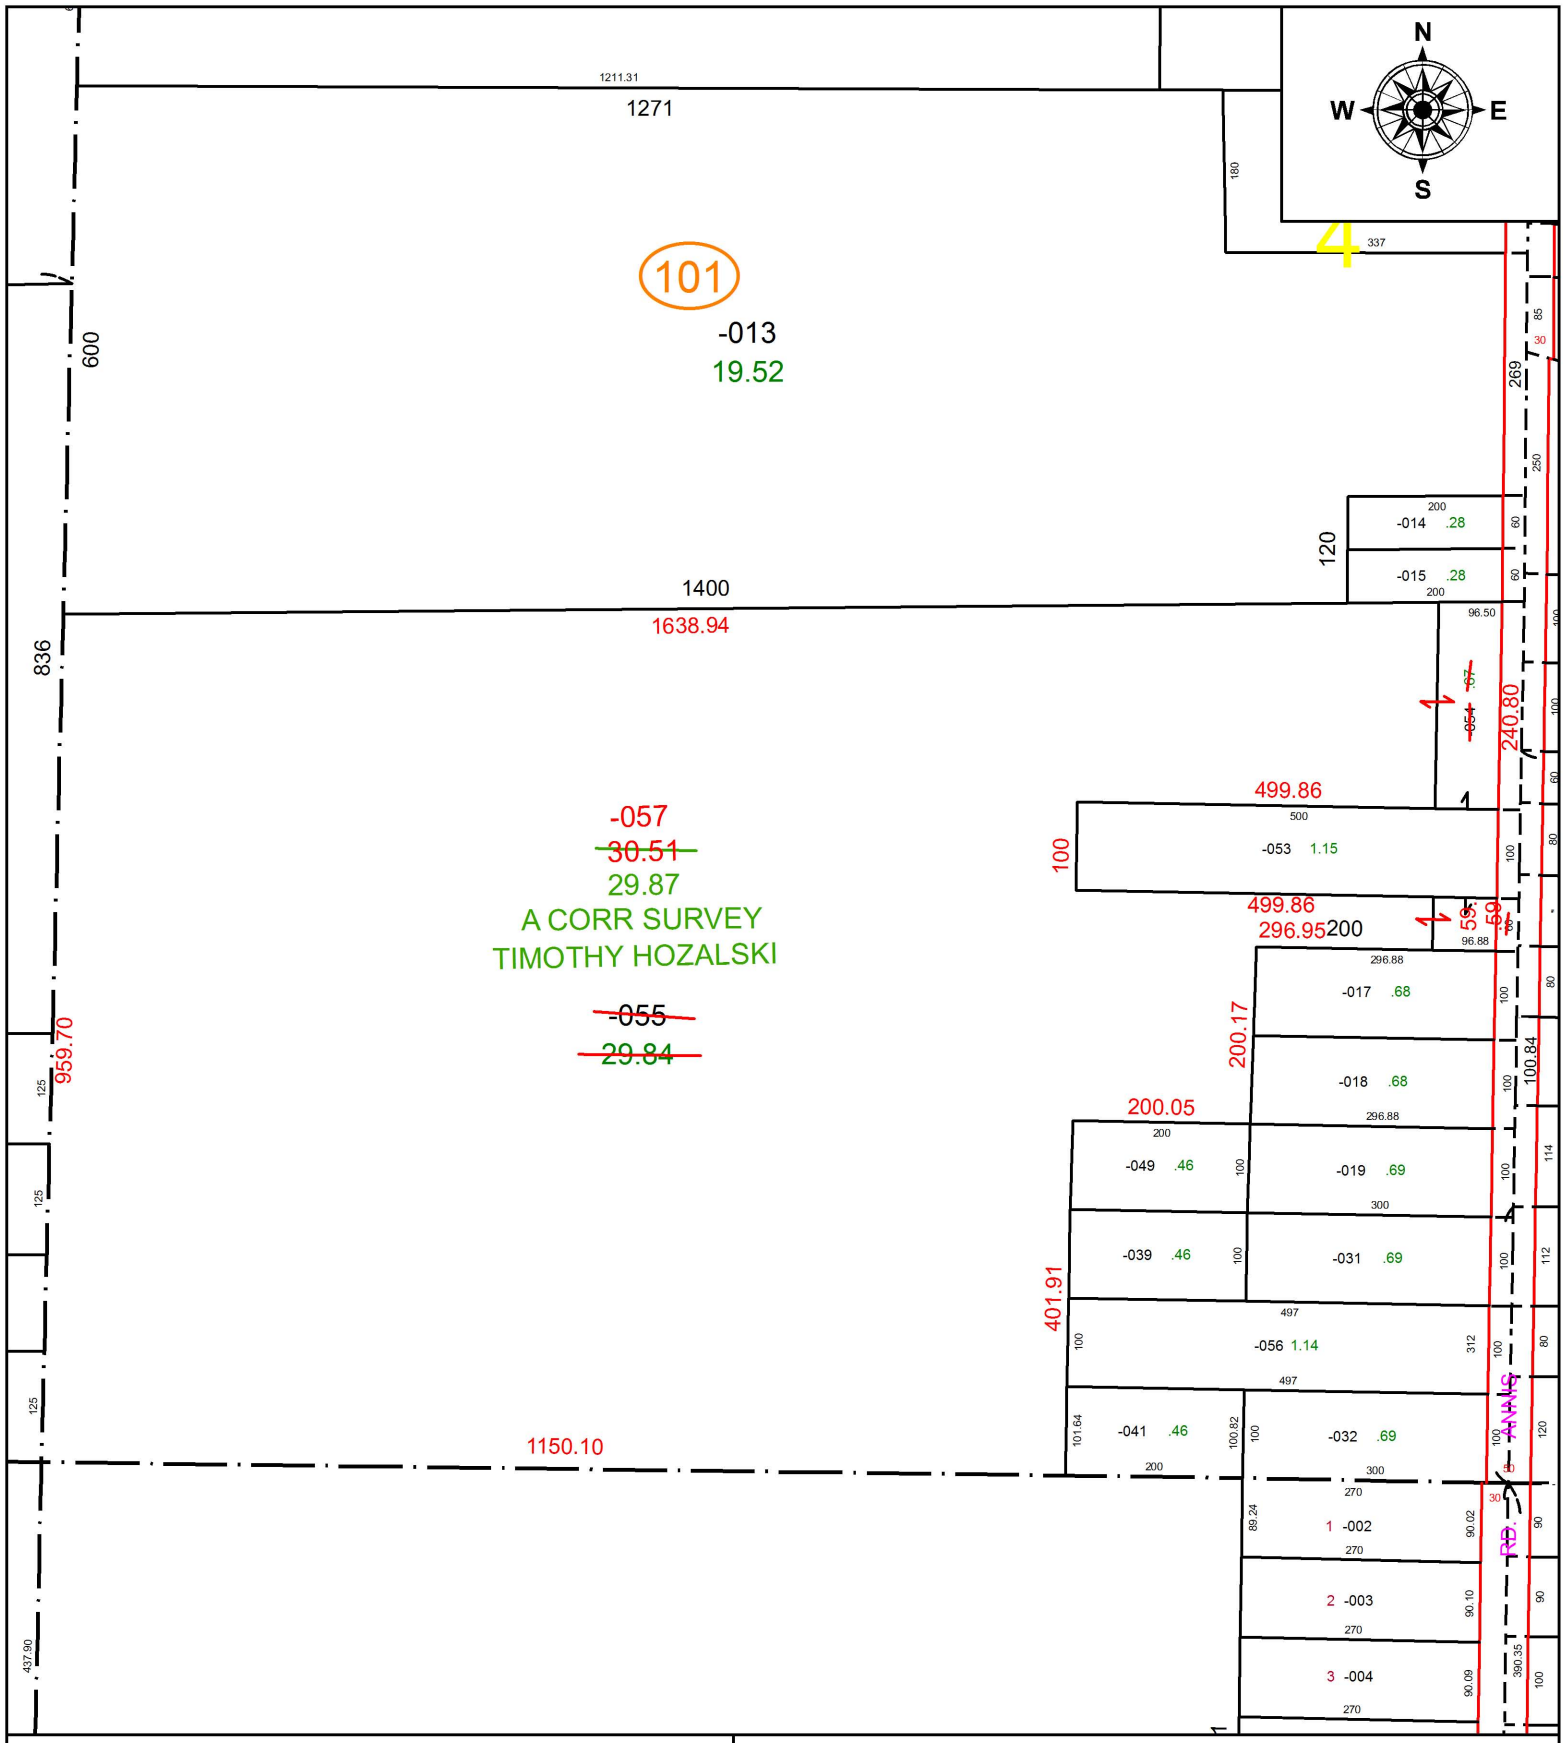

SPLITS/DEEDS PROCESSED

LORAIN COUNTY TAX MAP DEPARTMENT
226 MIDDLE AVE. ELYRIA, OH

SURVEYED BY: TIMOTHY HOZALSKI

CLOSURE: 1:878374

MAP PAGE(S): 09-00-004

APPOVED BY: JAH **DATE:** 7/28/2016

SCALE: 1 in = 217 ft **PRIOR INSTRUMENT:** OR 31/926