**PARENT PARCEL:** 19-02-057-000-007, -009

**CHILD PARCEL:** 19-02-057-000-010

**STARTING POINT:** SOUTHEAST CORNER OF O.L.57 TR.2

# 16-03547-C

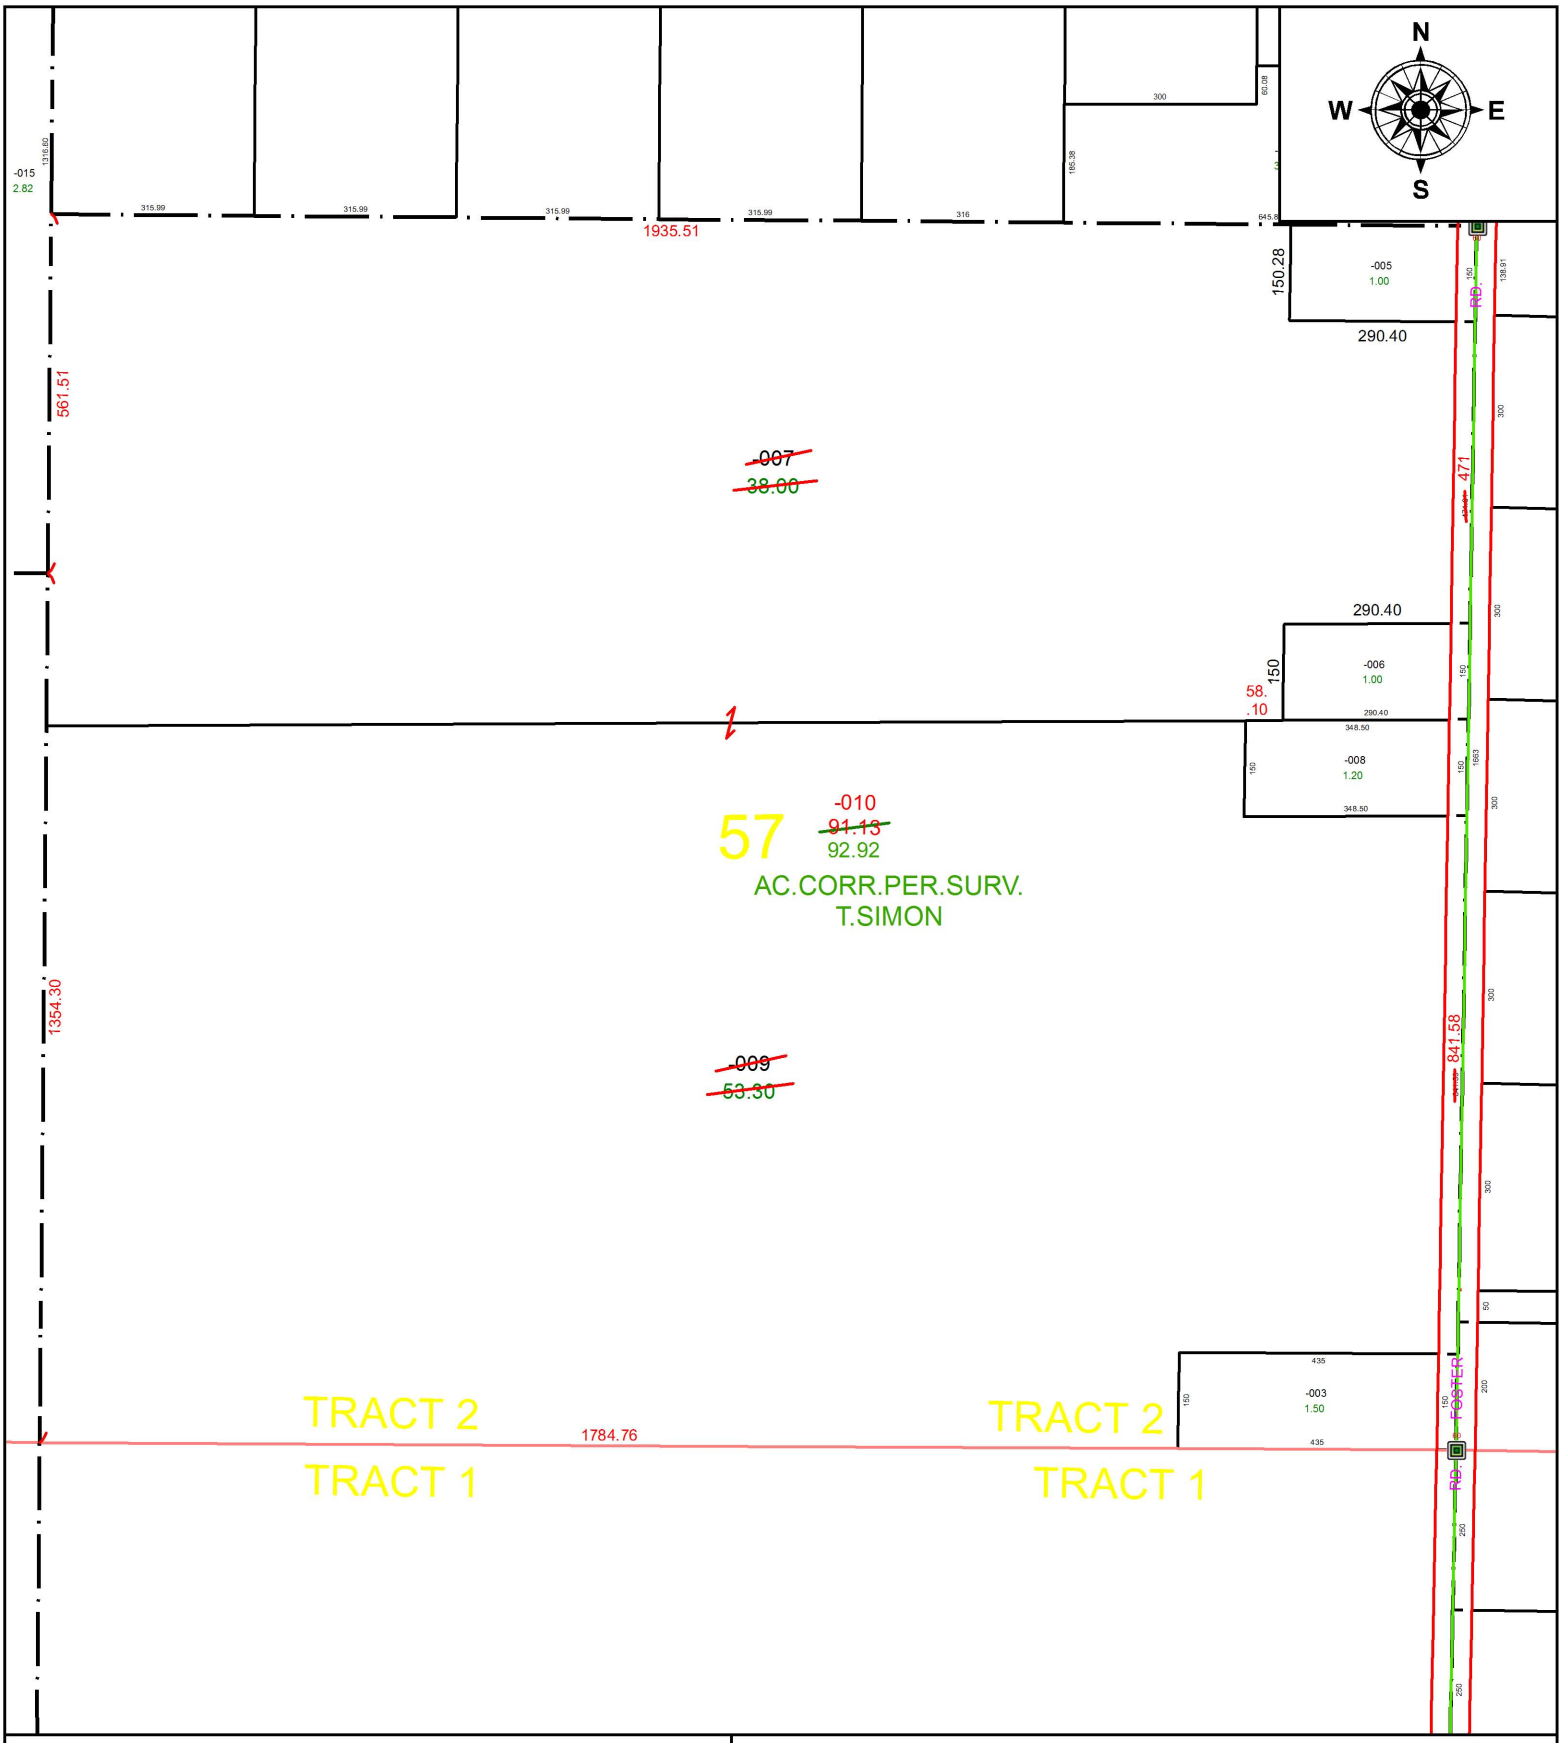


**SPLITS/DEEDS PROCESSED**

LORAIN COUNTY TAX MAP DEPARTMENT
226 MIDDLE AVE. ELYRIA, OH

**SURVEYED BY:** THOMAS A. SIMON
**CLOSURE:** 1: 2,196,997
**MAP PAGE(S):** 19-02-057
**APPOVED BY:** RRM **DATE:** 11-1-16
**SCALE:** 1" = 300 **PRIOR INSTRUMENT:** 20150534519