PARENT PARCEL: 08-12-019-000-007

CHILD PARCEL: XX-XX-XXX-XXX-XXX

STARTING POINT: SOUTHEAST CORNER OF O.L.19 TR.12

16-03549-D

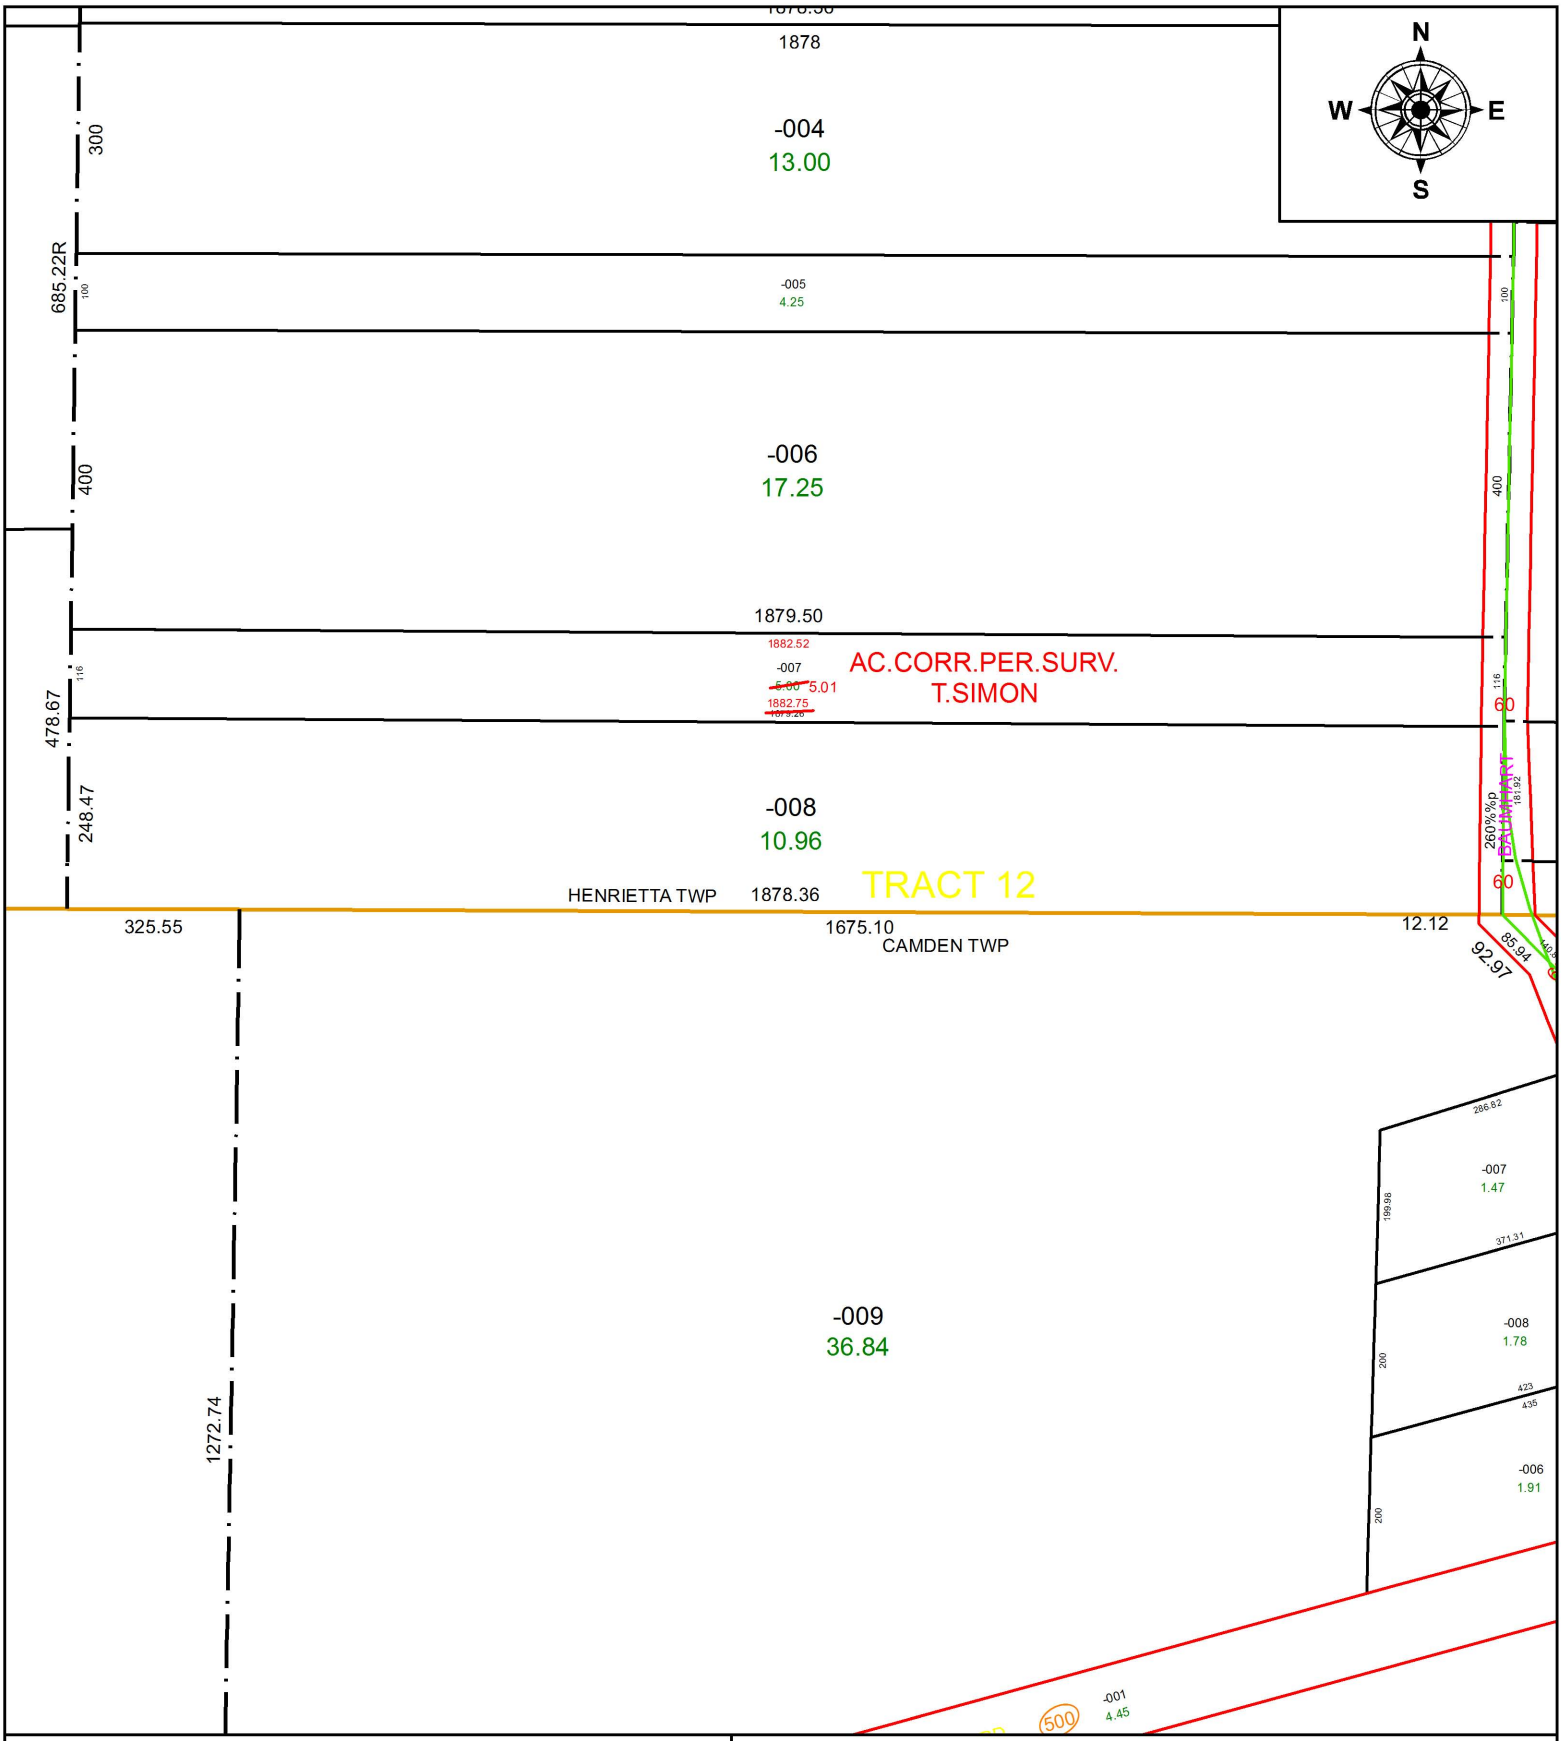

SPLITS/DEEDS PROCESSED

LORAIN COUNTY TAX MAP DEPARTMENT
226 MIDDLE AVE. ELYRIA, OH

SURVEYED BY: THOMAS A. SIMON
CLOSURE: 1: 937,393
MAP PAGE(S): 8-H
APPOVED BY: RRM **DATE:** 11-4-16
SCALE: 1" = 250 **PRIOR INSTRUMENT:** 20160588365