PARENT PARCEL: 01-00-026-000-040, -038, -008, -046

CHILD PARCEL: 01-00-026-000-051 THRU -054

STARTING POINT: CENTERLINE OF WHITTLESEY RD & BAUMHART RD

16-03550

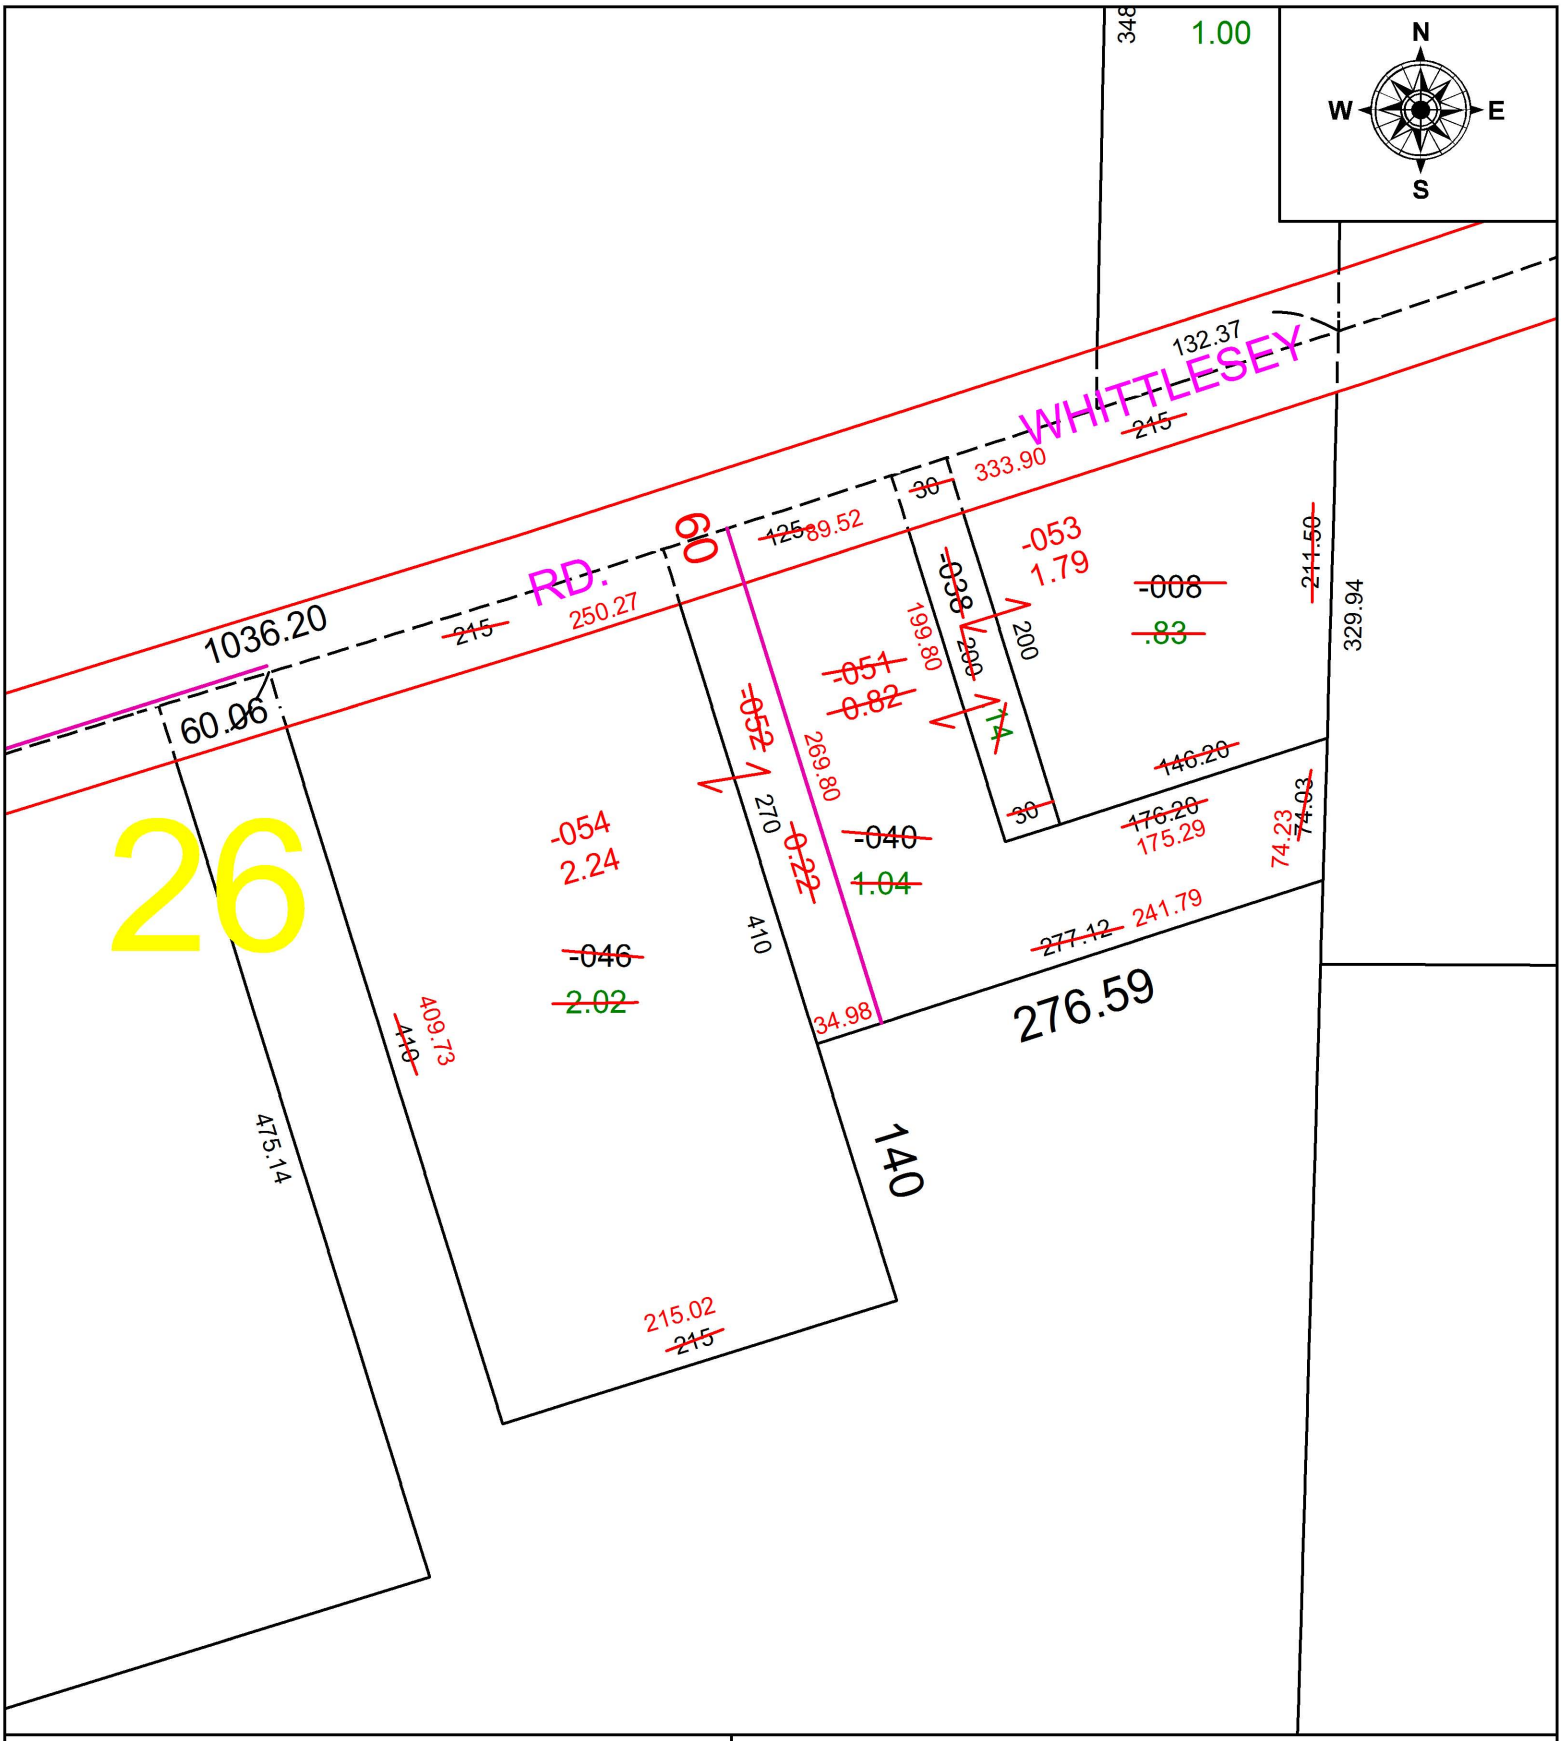

SPLITS/DEEDS PROCESSED

LORAIN COUNTY TAX MAP DEPARTMENT
226 MIDDLE AVE. ELYRIA, OH

SURVEYED BY: PATRICK MCGANNON
CLOSURE: 1:798493
MAP PAGE(S): 01-00-026
APPOVED BY: JAH **DATE:** 8/11/2016
SCALE: 1 in = 100 ft **PRIOR INSTRUMENT:** 20080268154