PARENT PARCEL: 07-00-027-102-010, 07-00-028-103-098
CHILD PARCEL: SAME
STARTING POINT: SIDELINE OF AURENSEN RD & NOLL DR

16-03552

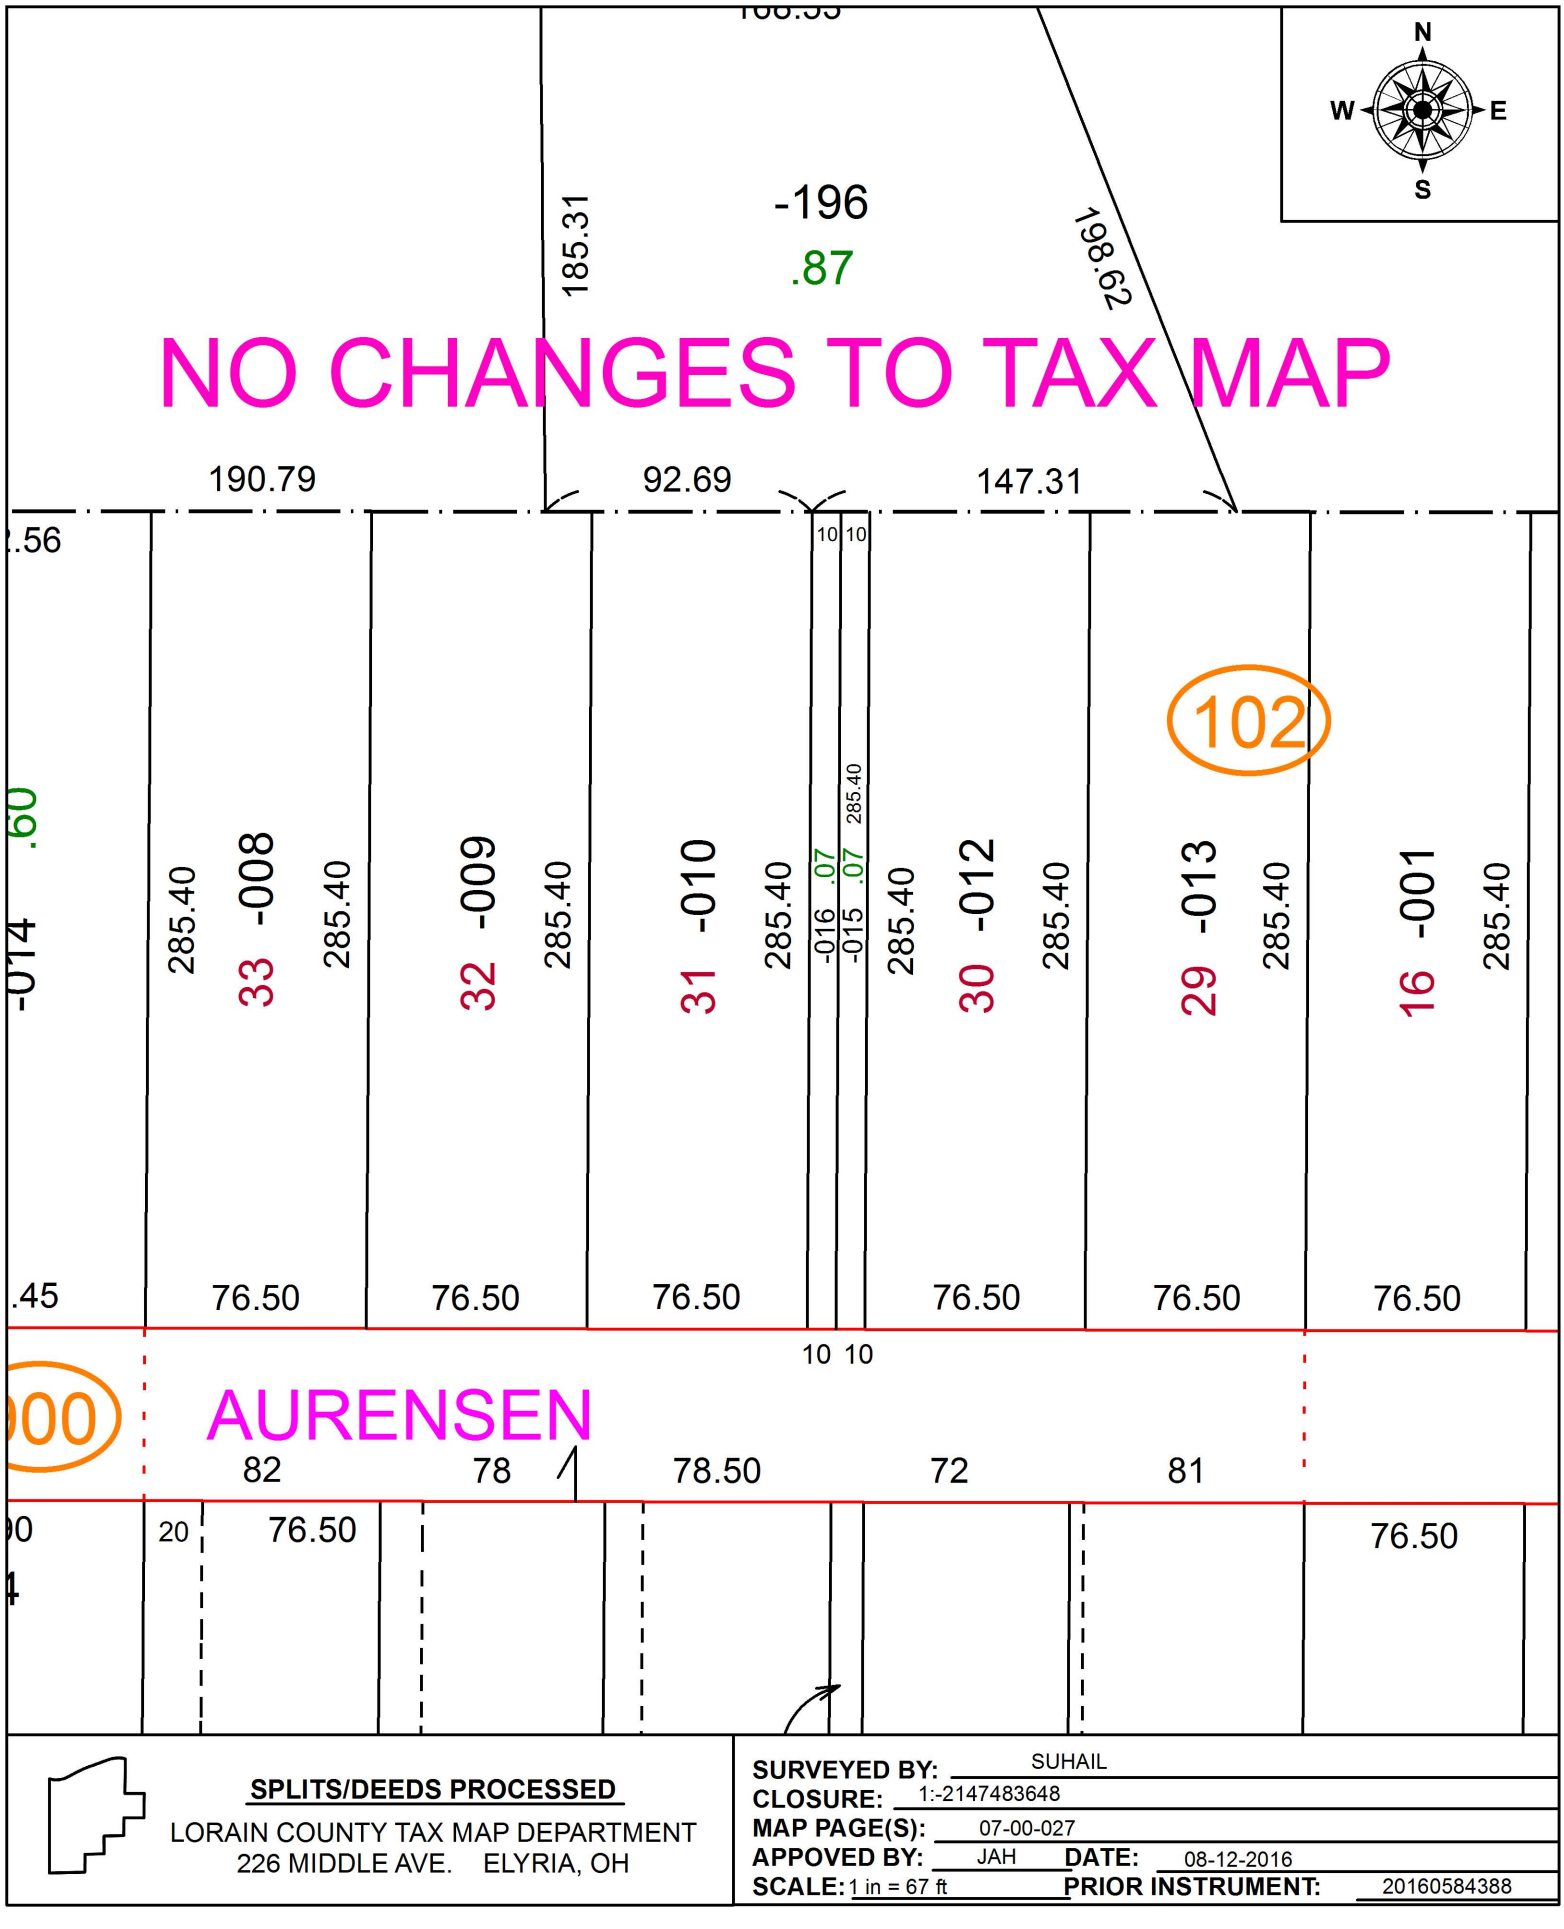

SPLITS/DEEDS PROCESSED
LORAIN COUNTY TAX MAP DEPARTMENT
226 MIDDLE AVE. ELYRIA, OH

SURVEYED BY: SUHAIL
CLOSURE: 1:-2147483648
MAP PAGE(S): 07-00-027
APPOVED BY: JAH **DATE:** 08-12-2016
SCALE: 1 in = 67 ft **PRIOR INSTRUMENT:** 20160584388