PARENT PARCEL: 13-11-005-000-014
CHILD PARCEL: XX-XX-XXX-XXX-XXX
STARTING POINT: NORTHEAST CORNER OF O.L.5 TR.11

16-03553-A

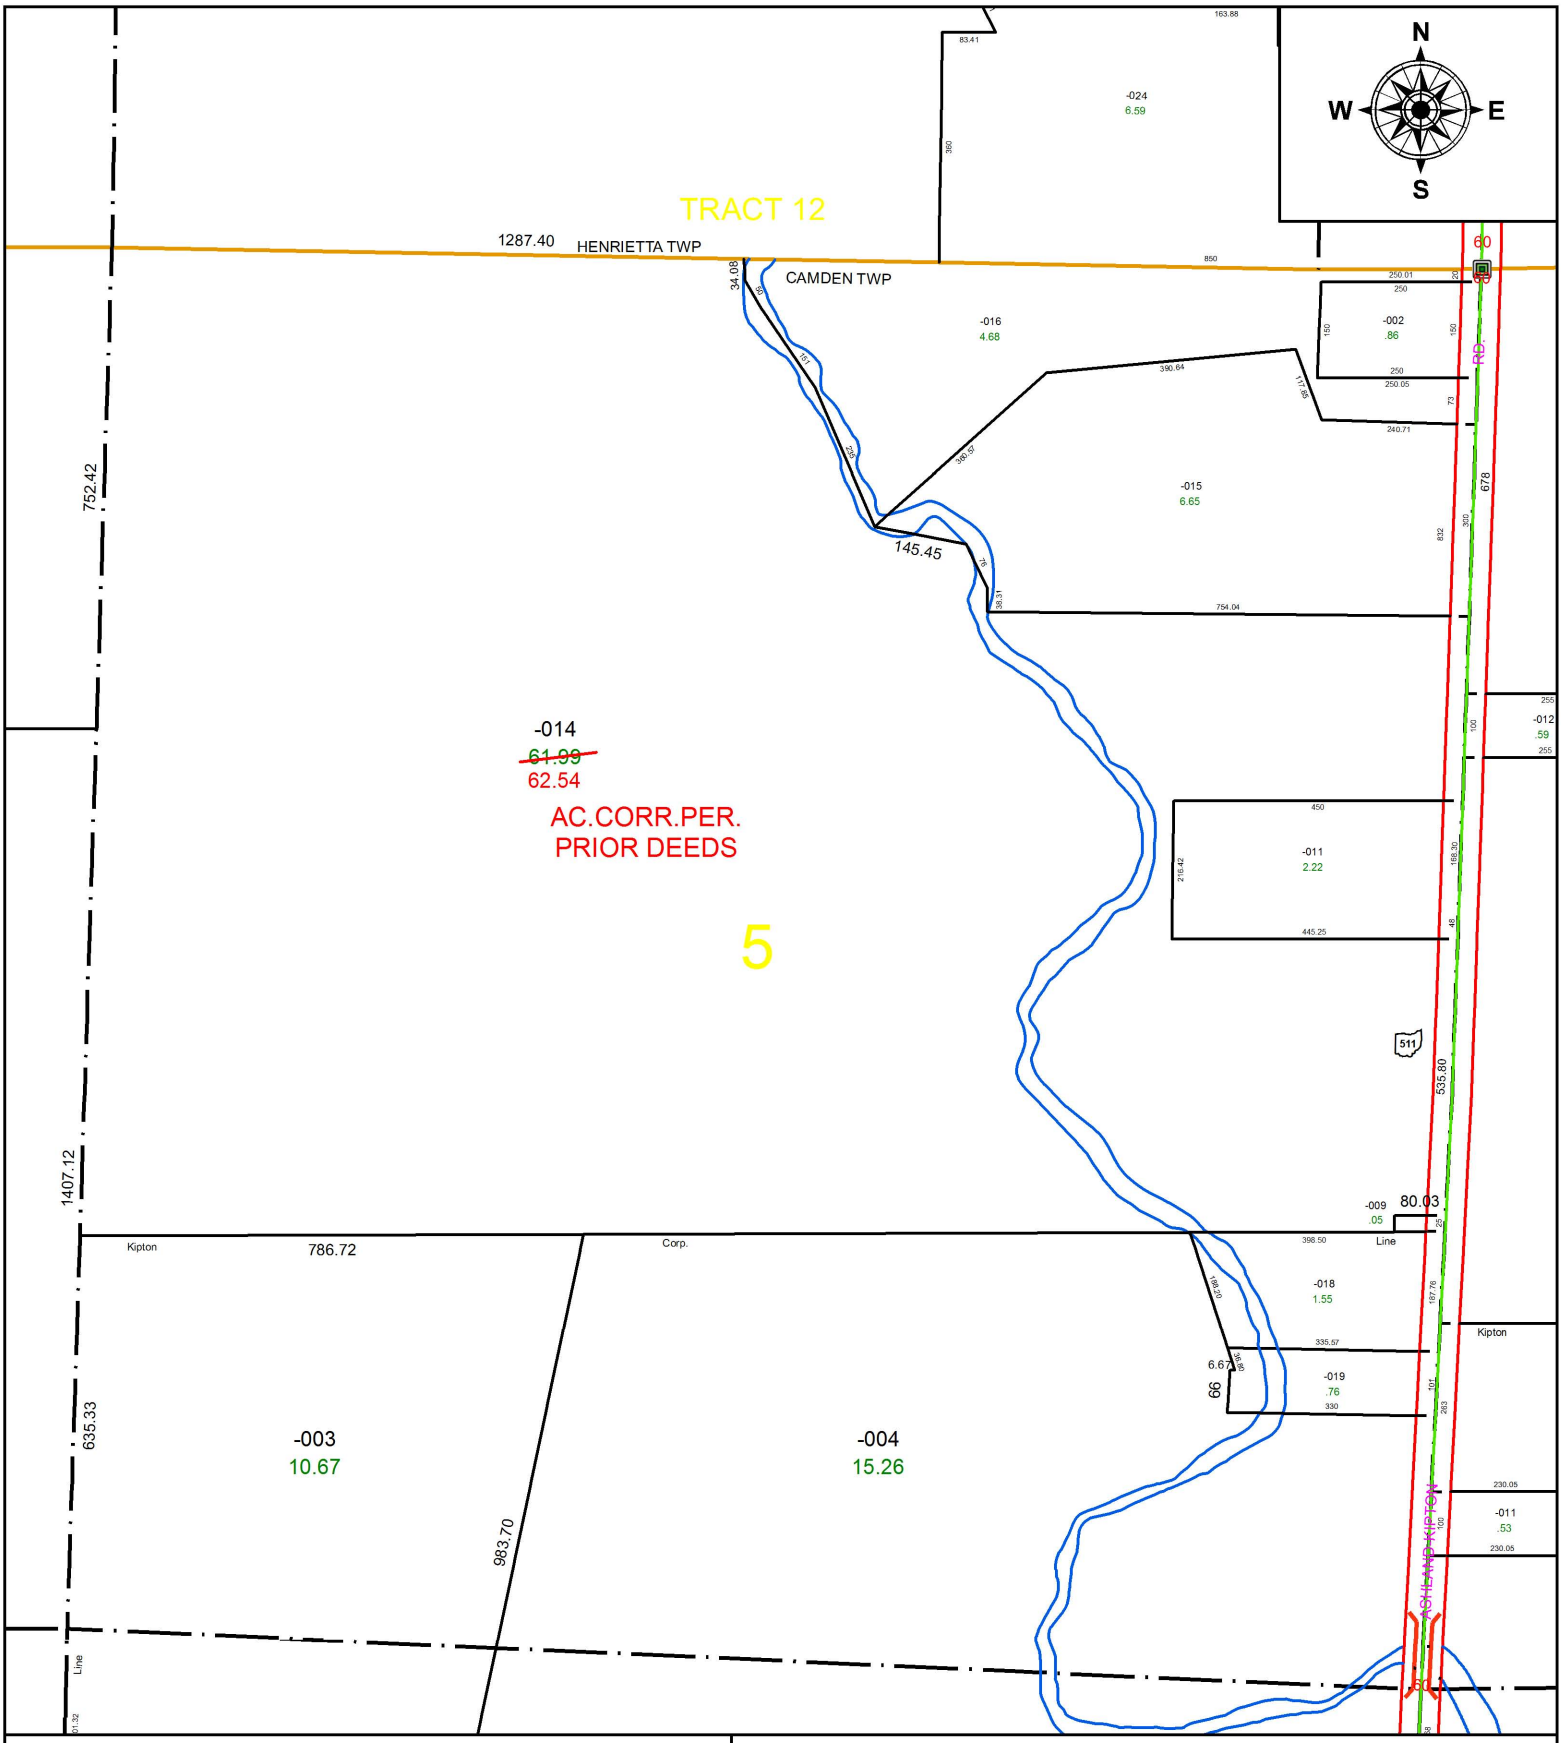

SPLITS/DEEDS PROCESSED

LORAIN COUNTY TAX MAP DEPARTMENT
226 MIDDLE AVE. ELYRIA, OH

SURVEYED BY: N/A
CLOSURE: N/A
MAP PAGE(S): 13-11-005
APPOVED BY: RRM **DATE:** 11-10-16
SCALE: 1" = 300 **PRIOR INSTRUMENT:** 20140502414